



2221

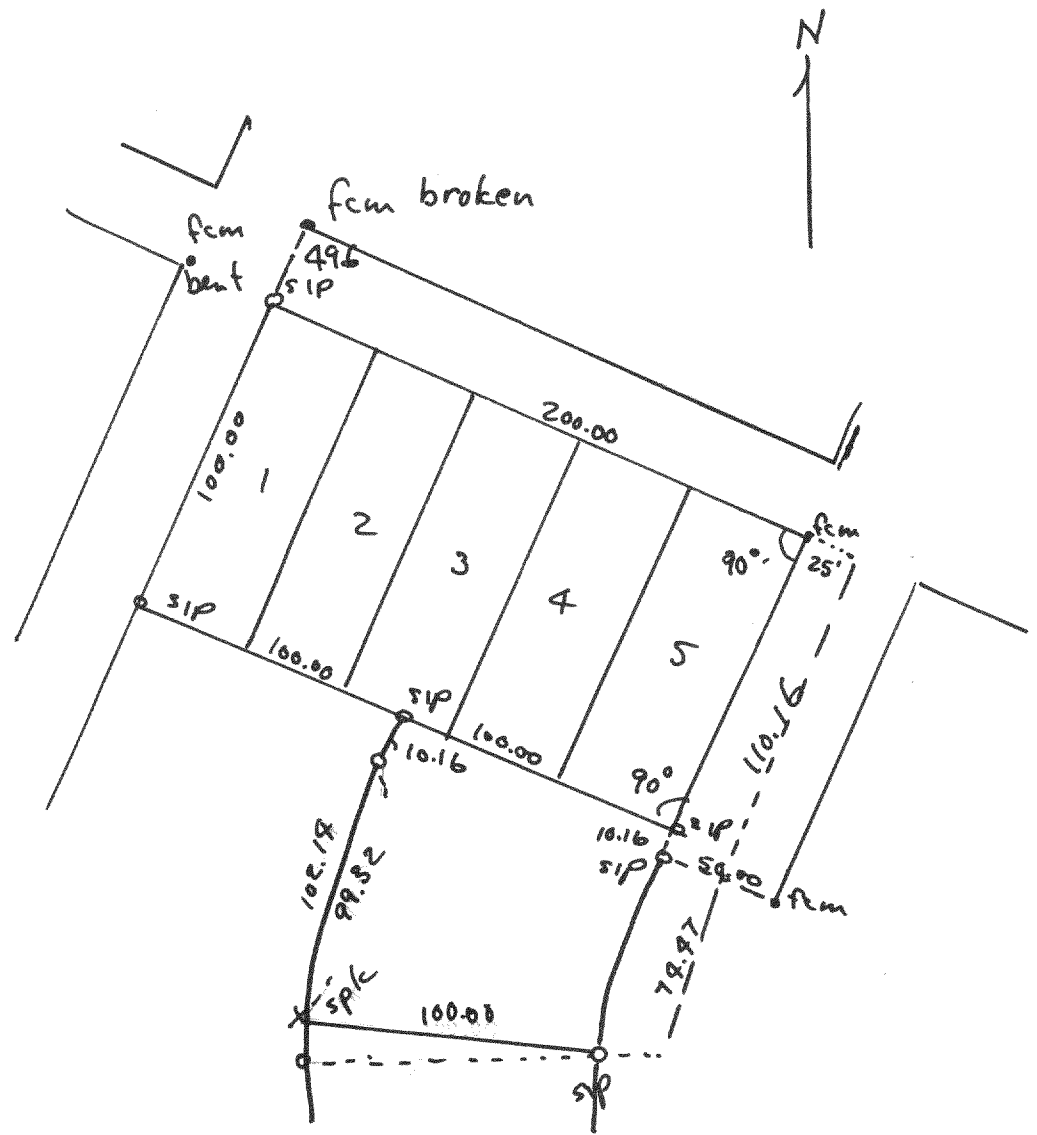

Plat of survey of lots 1, 2, 3, 4, 5 & 30, Block 39 of Interlaken located in Sec 11, T3N R16E of Walworth County Wis.
Sept 25, 1950

Lloyd S. Jensen
County Surveyor


2222

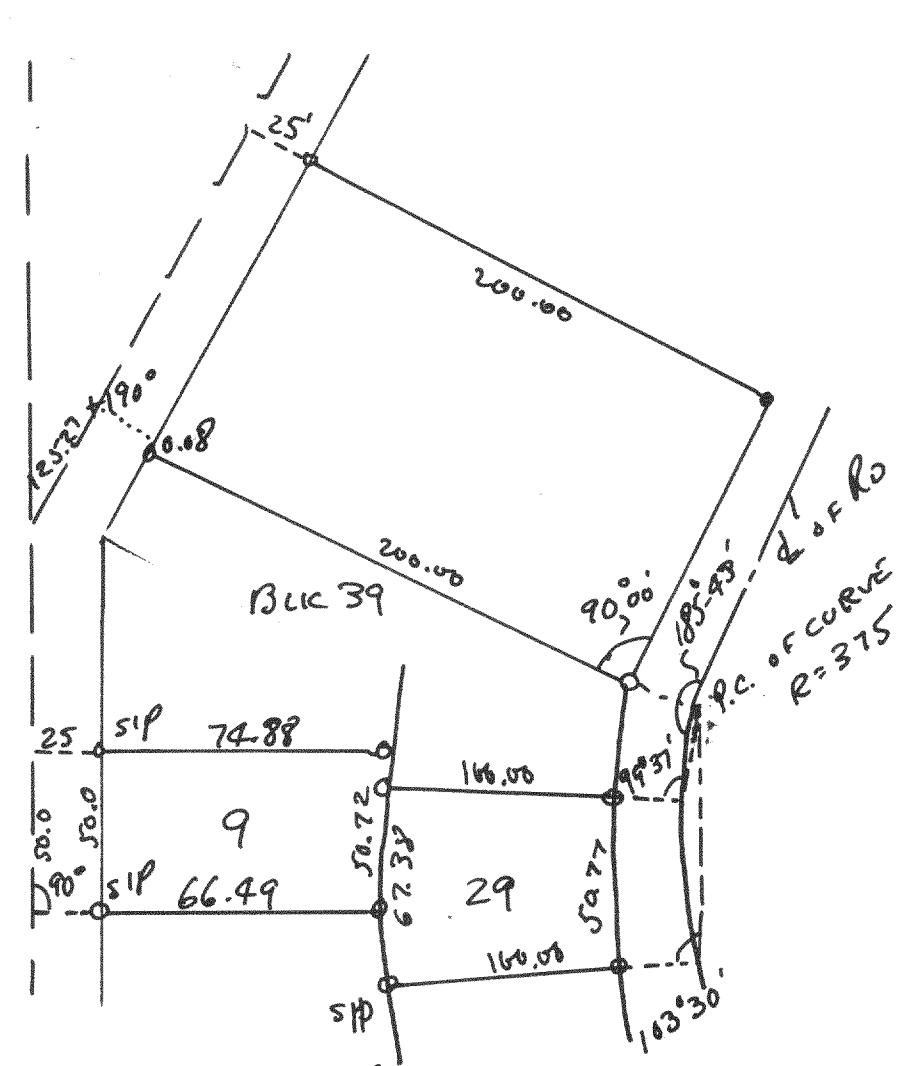

Survey of lots 9 & 29 Block 39 of Interlaken located in Sec 11, T3N R16E of Walworth County, Wis.
October 9, 1950

Lloyd S. Jensen
County Surveyor

2223

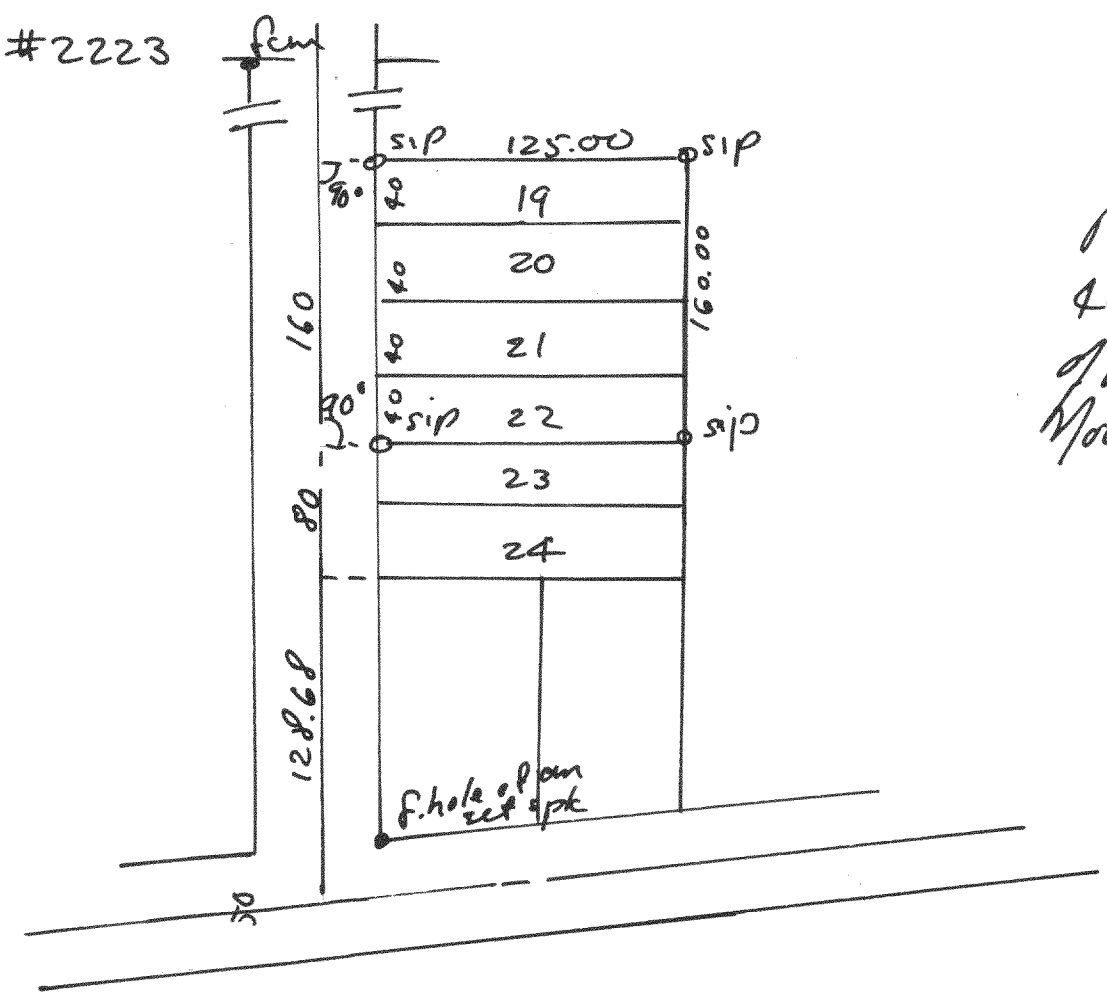

Plat of survey of lots 19-22 incl., Block 44 Interlaken located in Sec 11, T3N R16E of Walworth County, Wis.
Nov 10, 1950

Lloyd S. Jensen
County Surveyor