



#2270

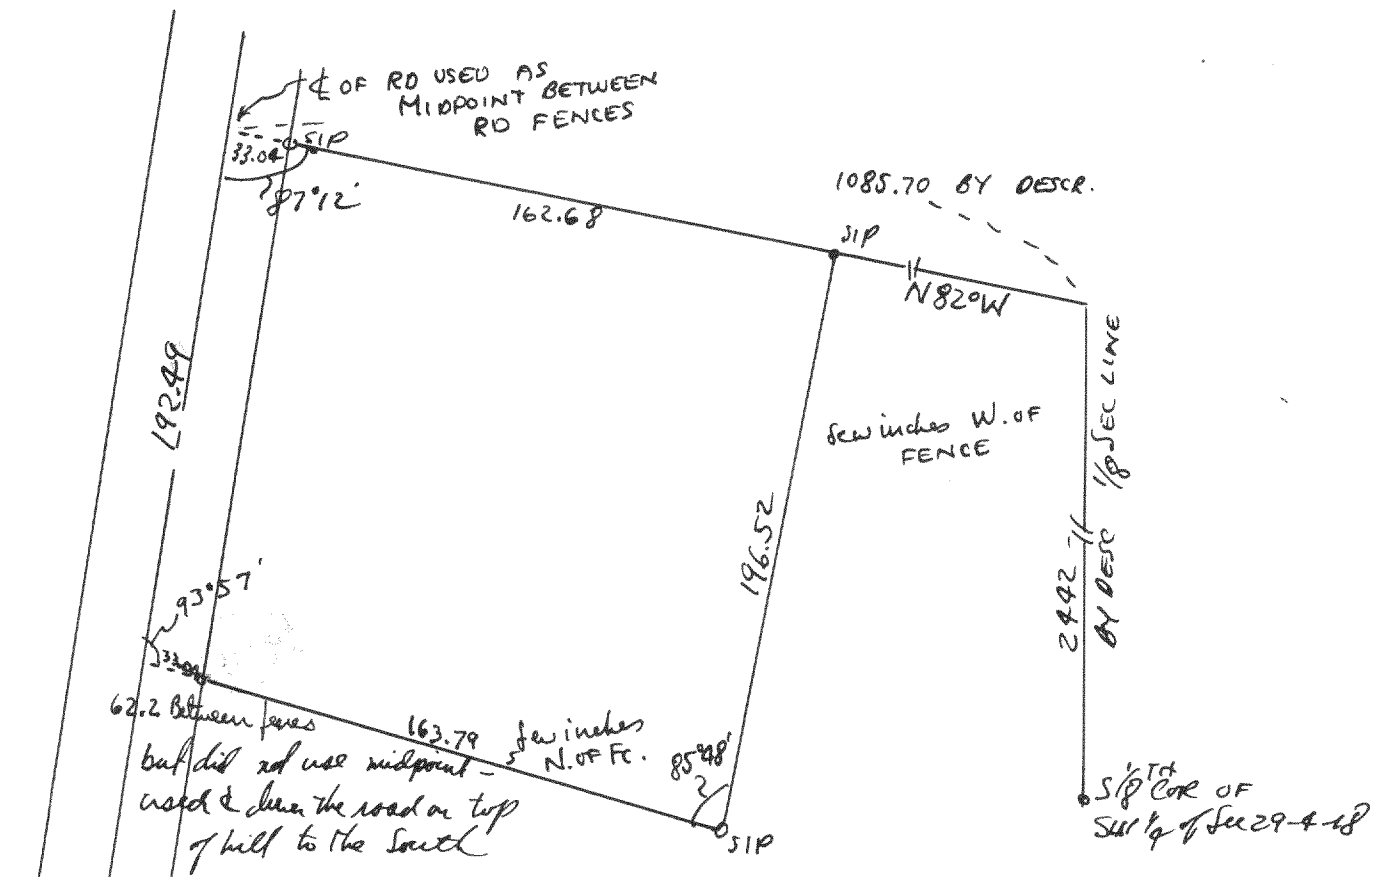


Plat of survey of a parcel of land located in the NW 1/2 of the SW 1/4 of Sec 29-T4N R18E of Walworth County, Wisconsin
 Sept 29, 1950
 Floyd S. Jensen
 County Surveyor

#2271

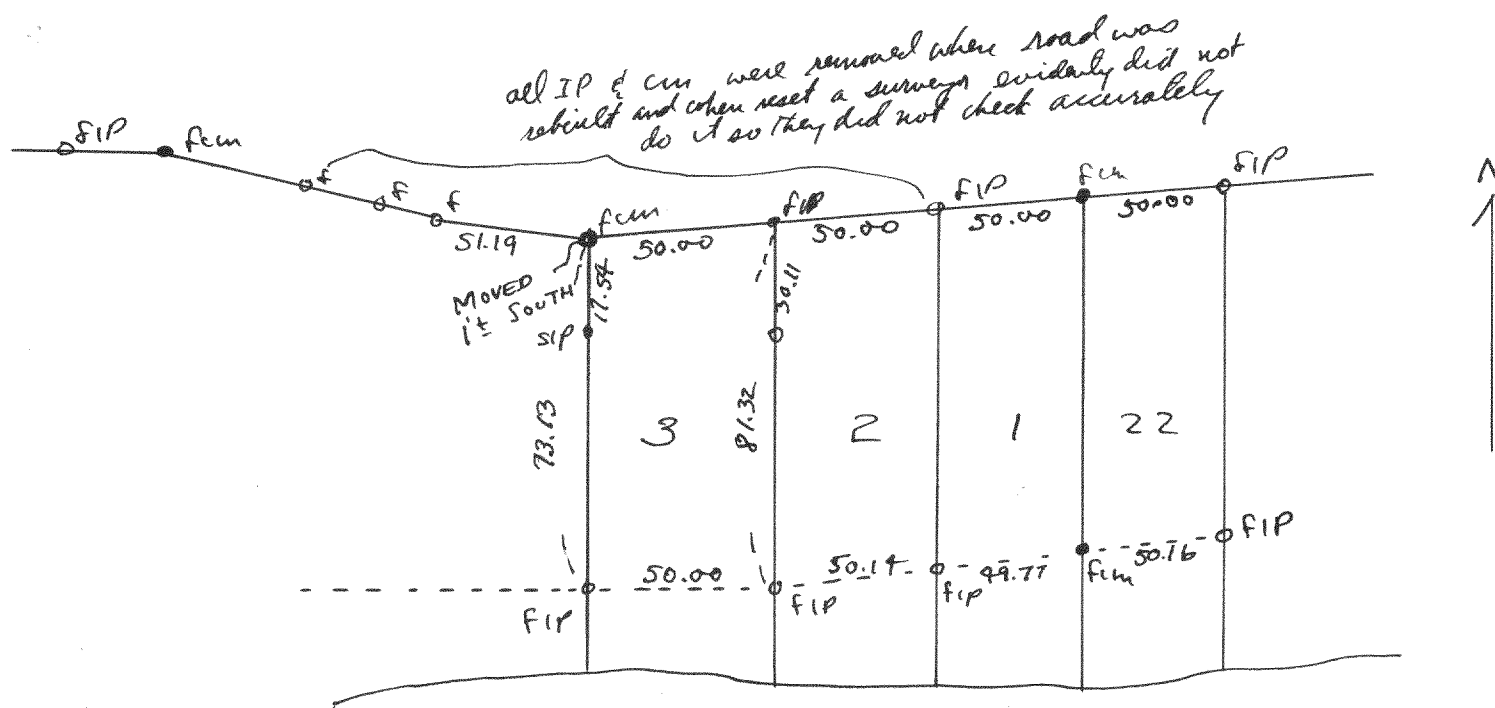


Plat of survey of lot 3, Fureck's 2ND Subd located in Sec 18, T4N R18E, Walworth County, Wis.
 Oct 10, 1950
 Floyd S. Jensen
 County Surveyor

#2272

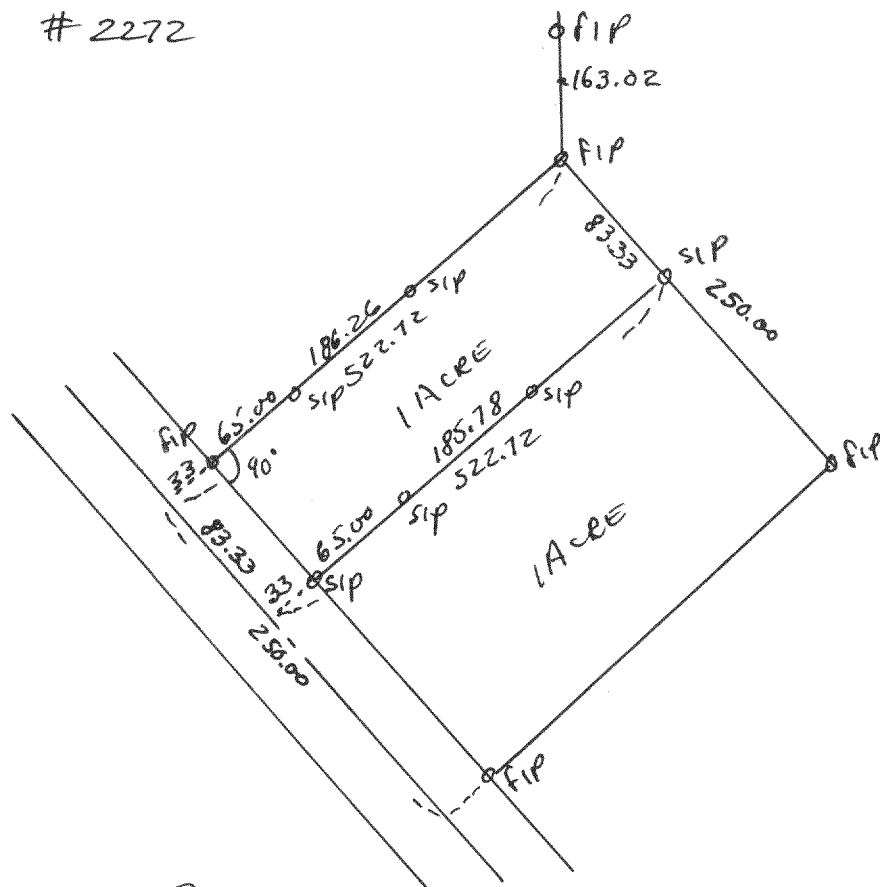

Plat of survey of a 1 acre parcel for Daniels located in the NW 1/2 of Sec 11, T4N R18E of Walworth County, Wisconsin.
 Oct 13, 1950
 Floyd S. Jensen
 County Surveyor

#2273

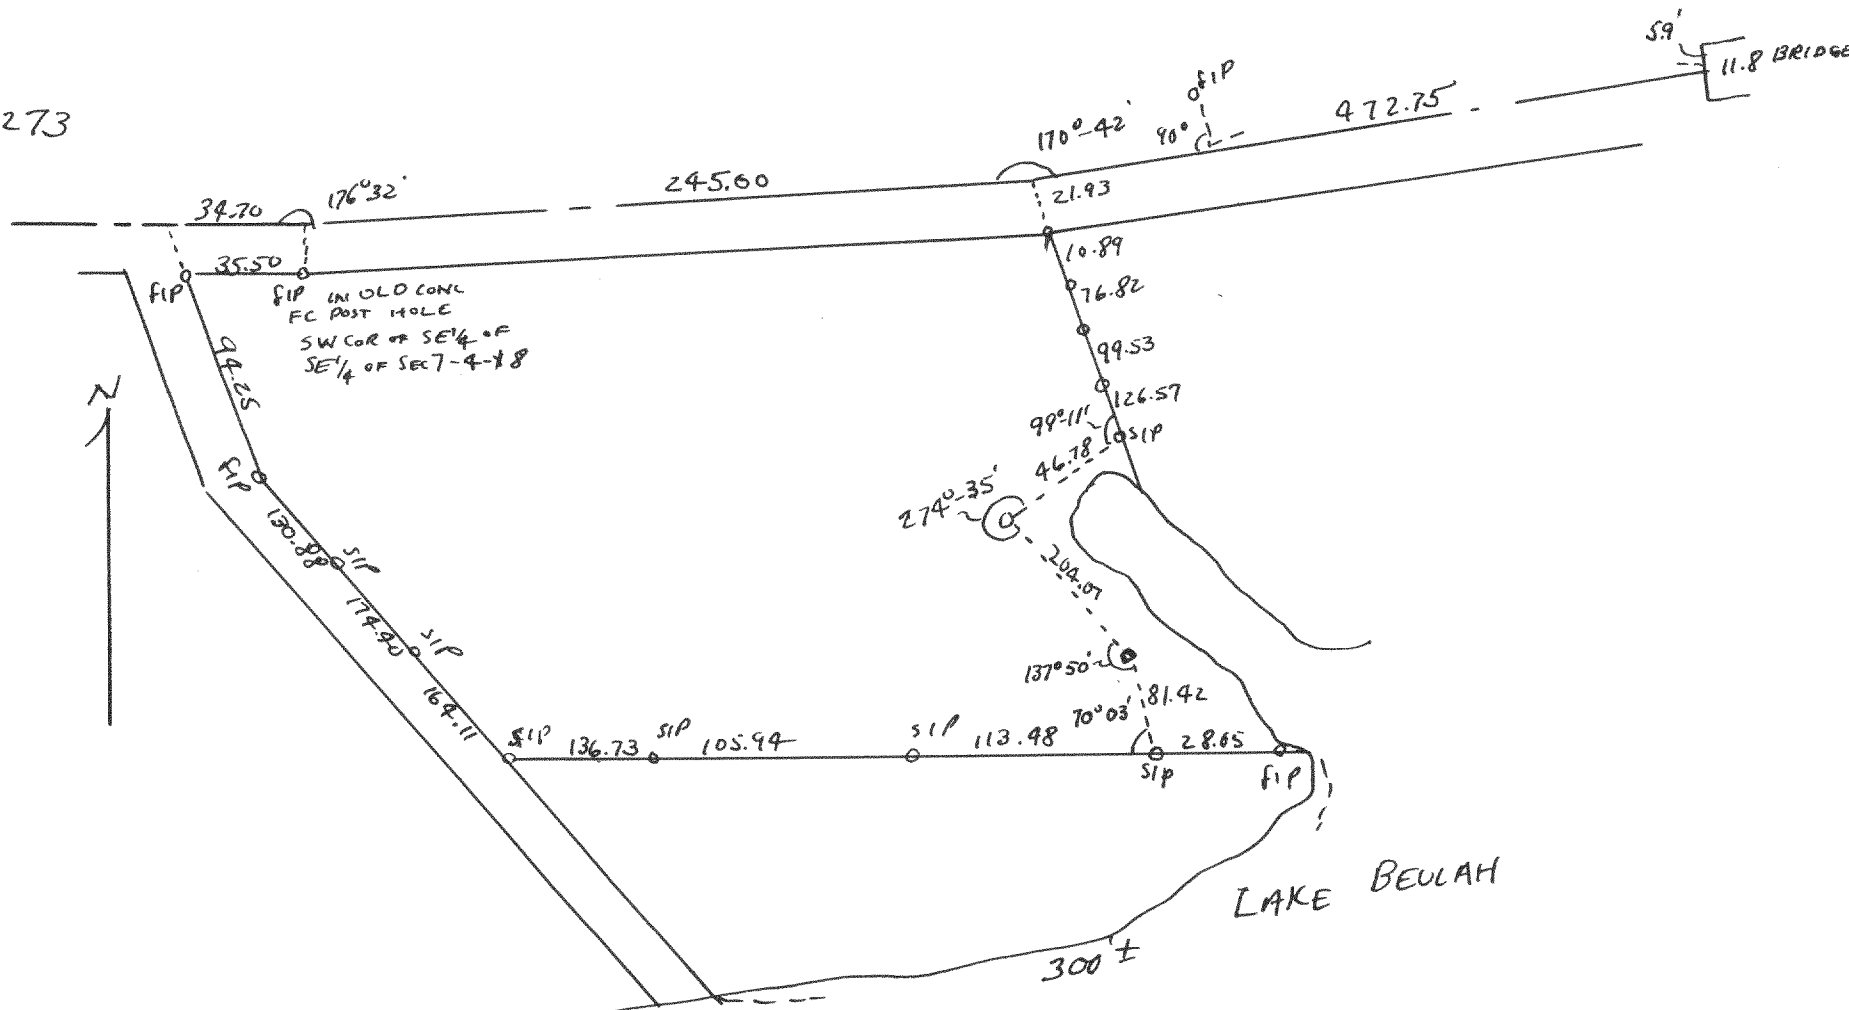

Plat of Survey of Kembe Property located in Sec 7, T4N R18E of Walworth County, Wis.
 Nov 10, 1950
 Floyd S. Jensen
 County Surveyor