



# 2300

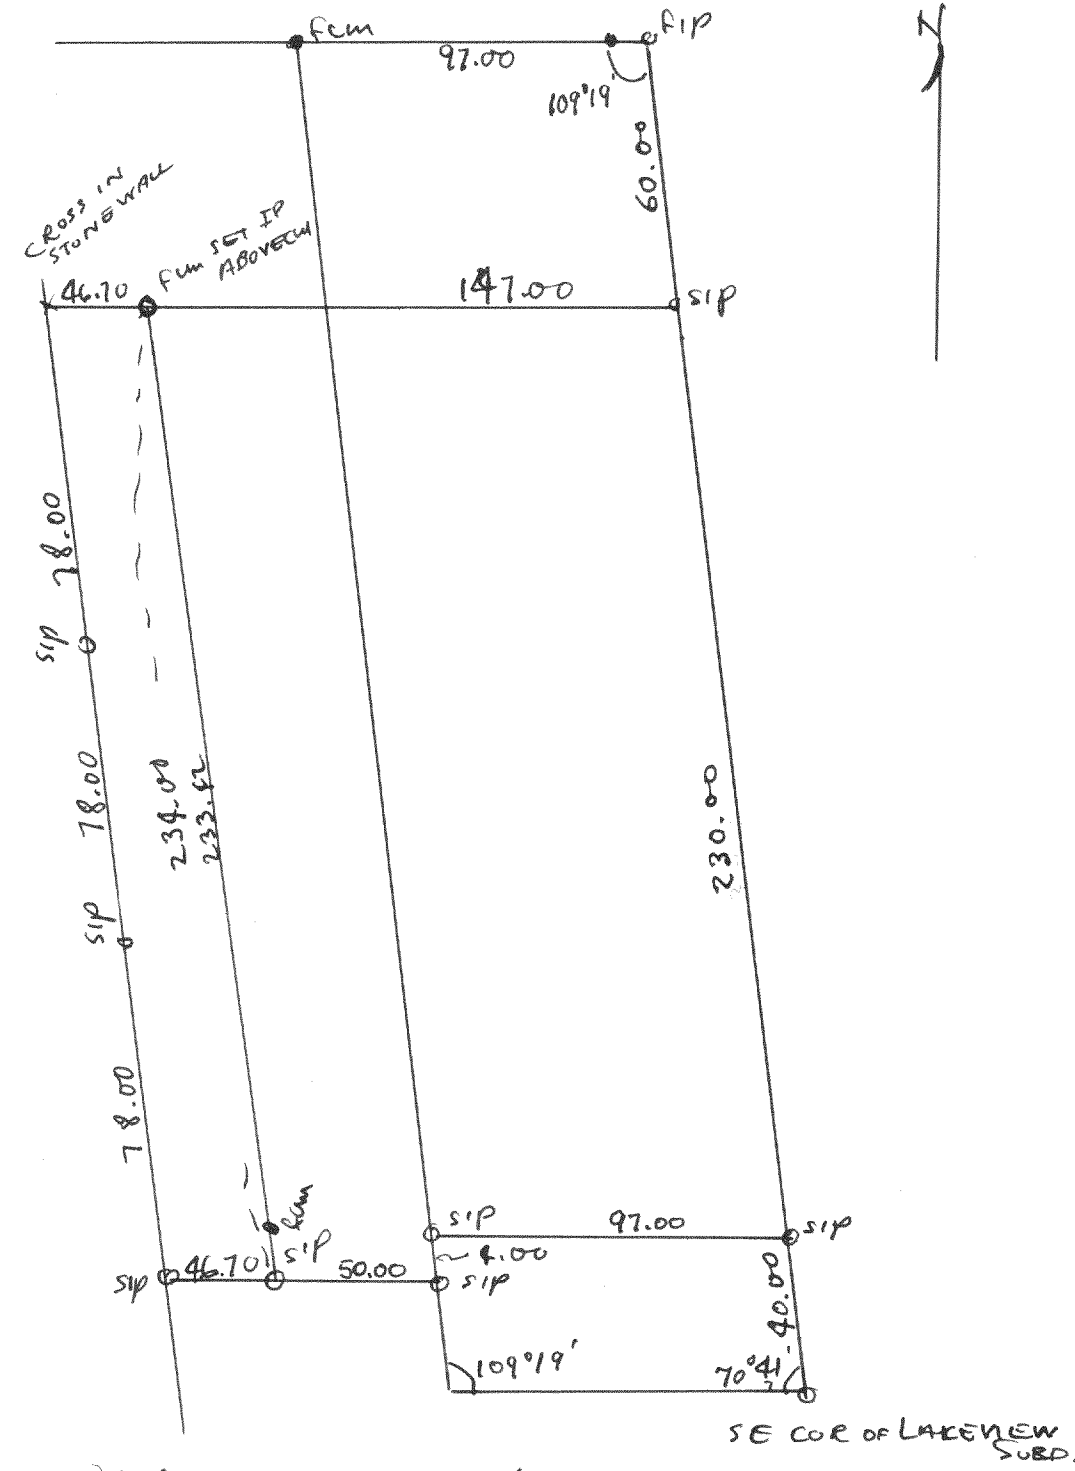

Plat of survey of Lakeview Subd located in Sec 14  
 TINKRGE Village of Fontana, Walworth, Wis.  
 1950  
 Lloyd S. Jensen  
 County Surveyor

# 2301

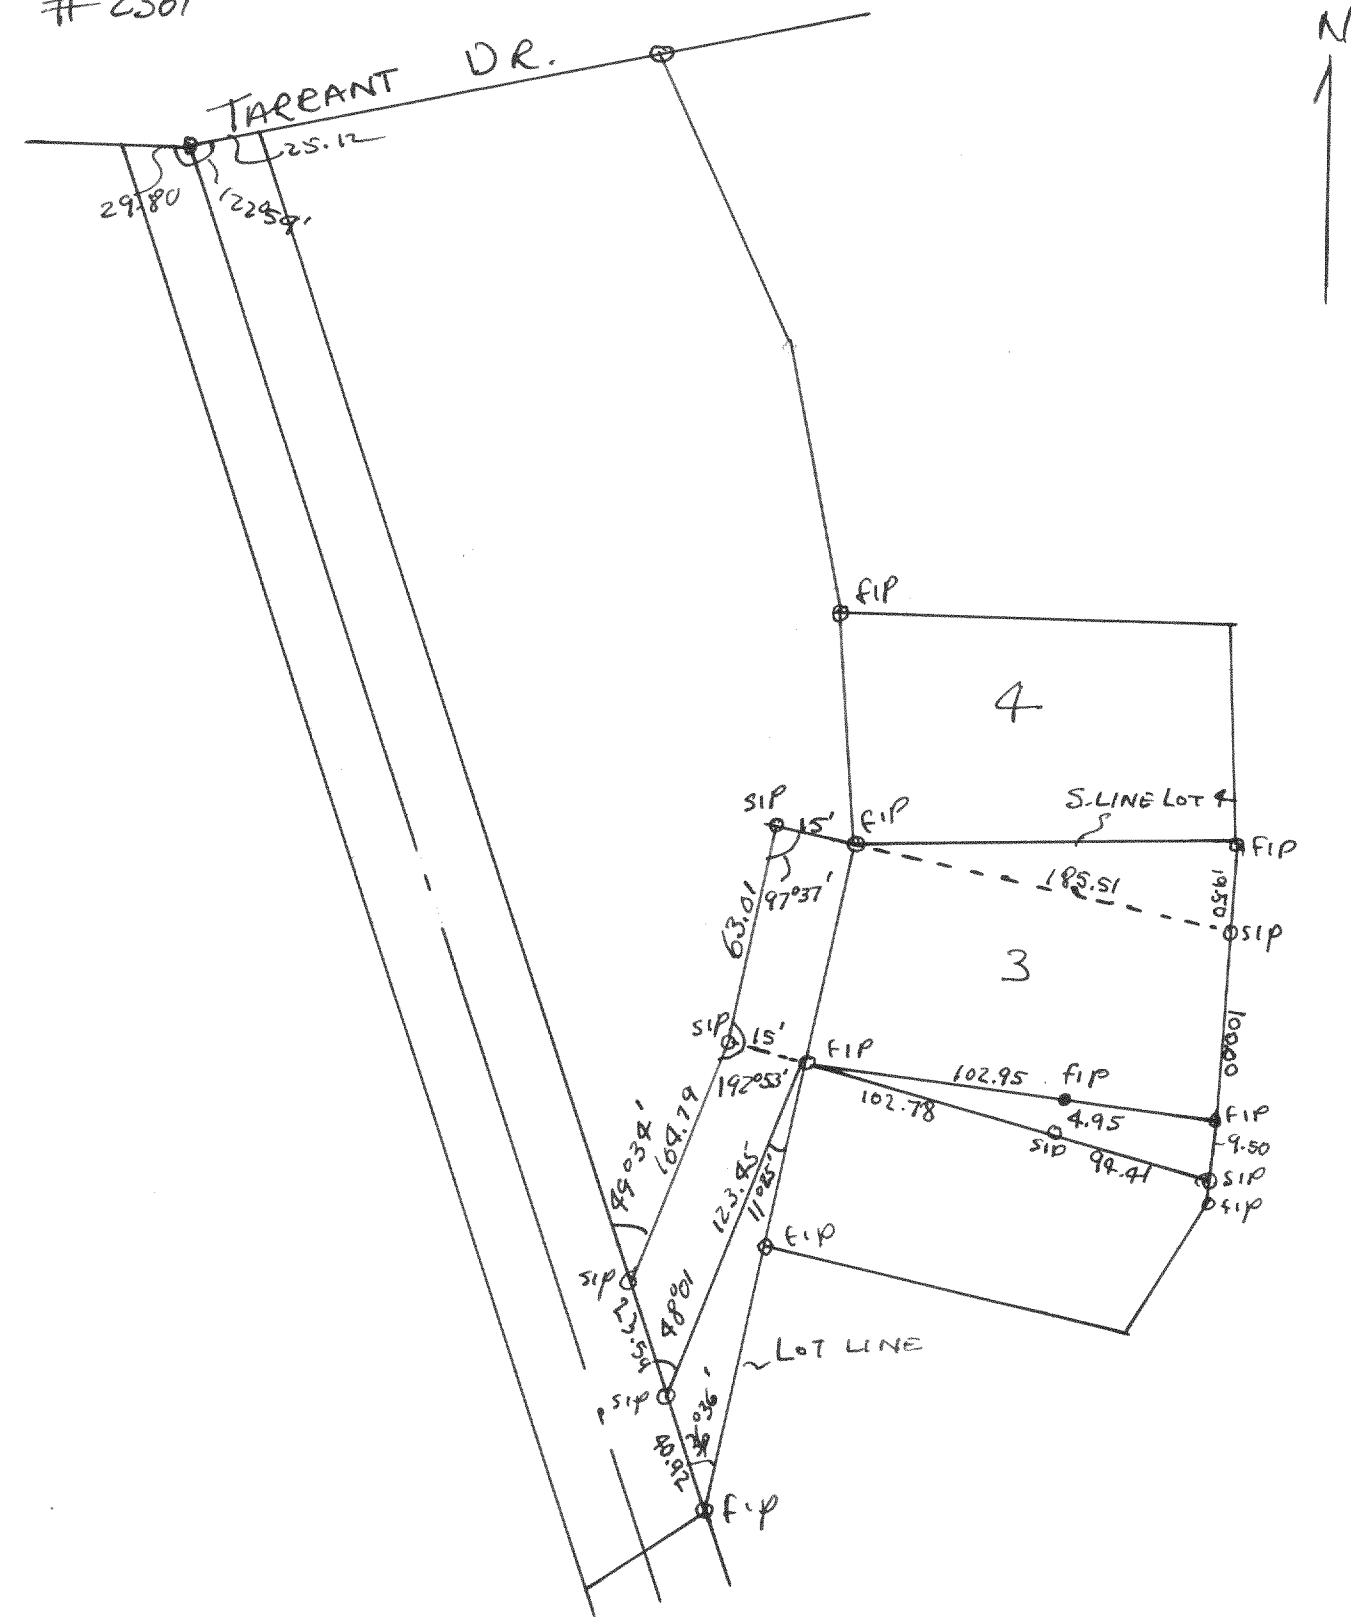

Plat of survey of changes in lot 3 and Row to lot 3 in Country Club  
 Estates Addition #1 located in The Village of Fontana Sec 14, TINKRGE of Walworth  
 County, Wis.  
 1950  
 Lloyd S. Jensen  
 County Surveyor