



Plot of survey of lot 3, Lost Nations Park located in Sec 35 T4N16E of Walworth County, Wis
1950

Floyd L. Jensen (swy)
County Surveyor

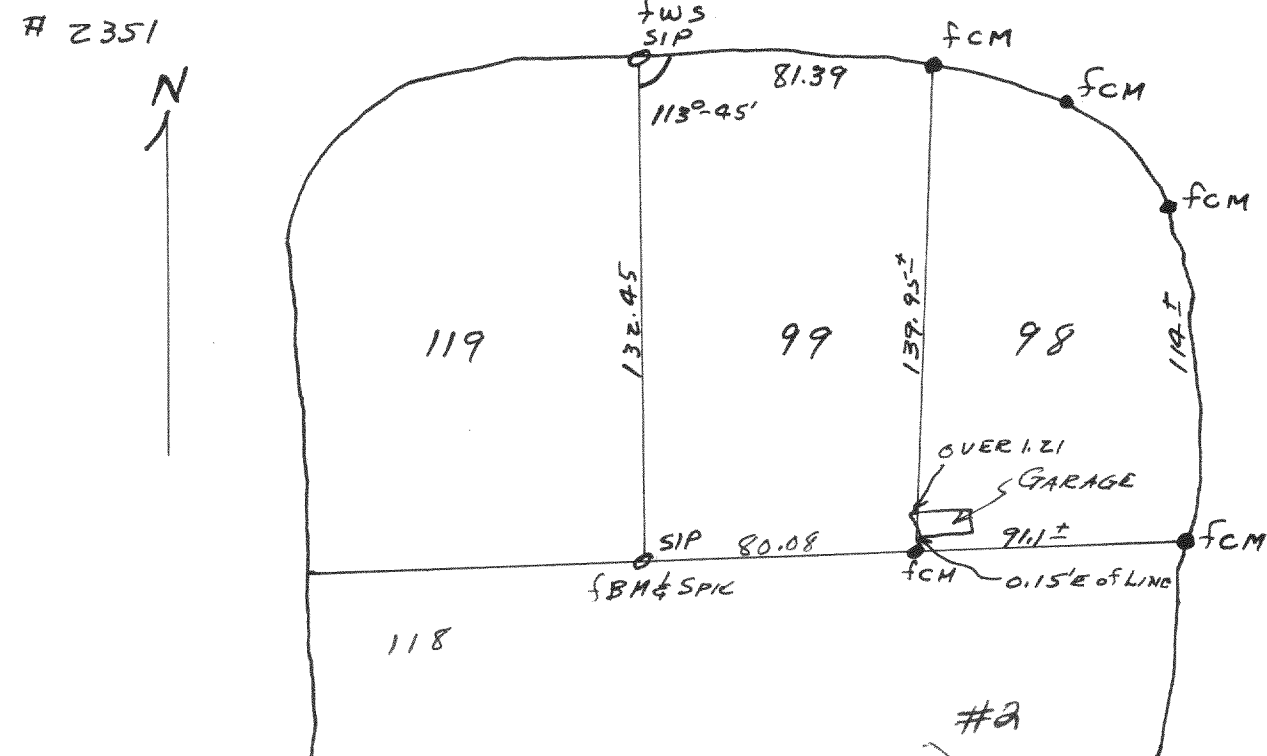

Plot of survey of lot 99 Unit #1 of Country Club Estates located in Sec 23 T1N16E Village of Fontana, Walworth County Wis.
July 6, 1950
Floyd L. Jensen (swy)
County Surveyor

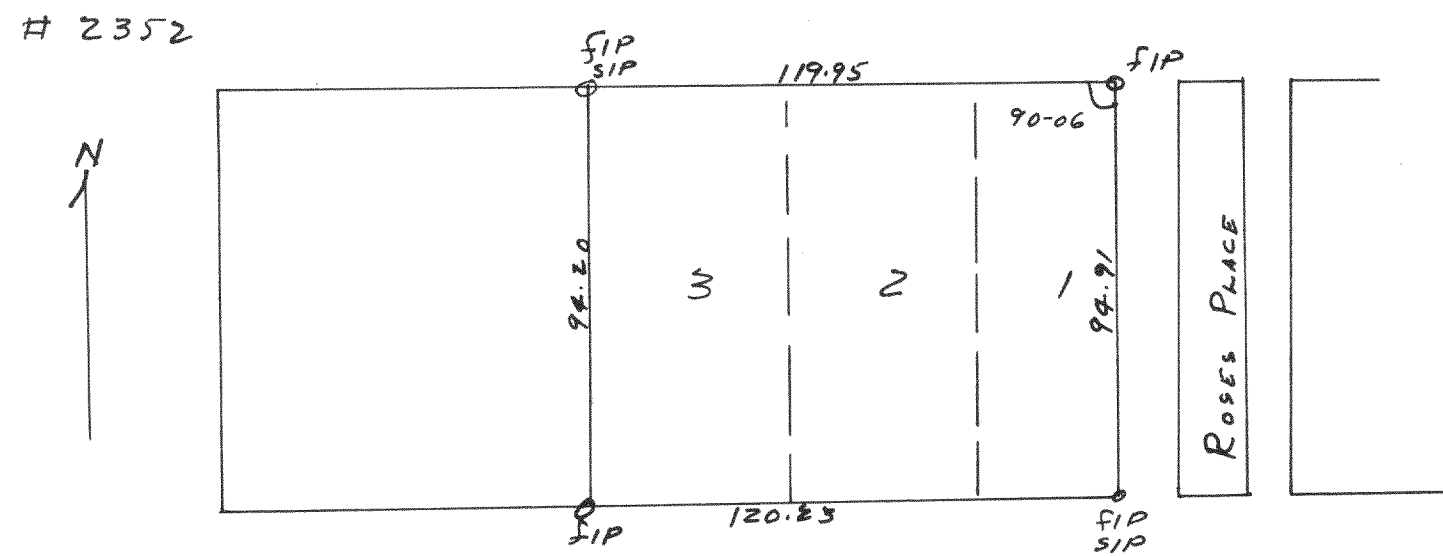

Plot of survey of lots 1, 2, & 3 of Blk 4 of Glenwood Springs Subd. located in Sec 14 T1N16E Village of Fontana, Walworth County, Wis.
Aug 4, 1950
Floyd L. Jensen (swy)
County Surveyor