


SURVEY NO. 1285

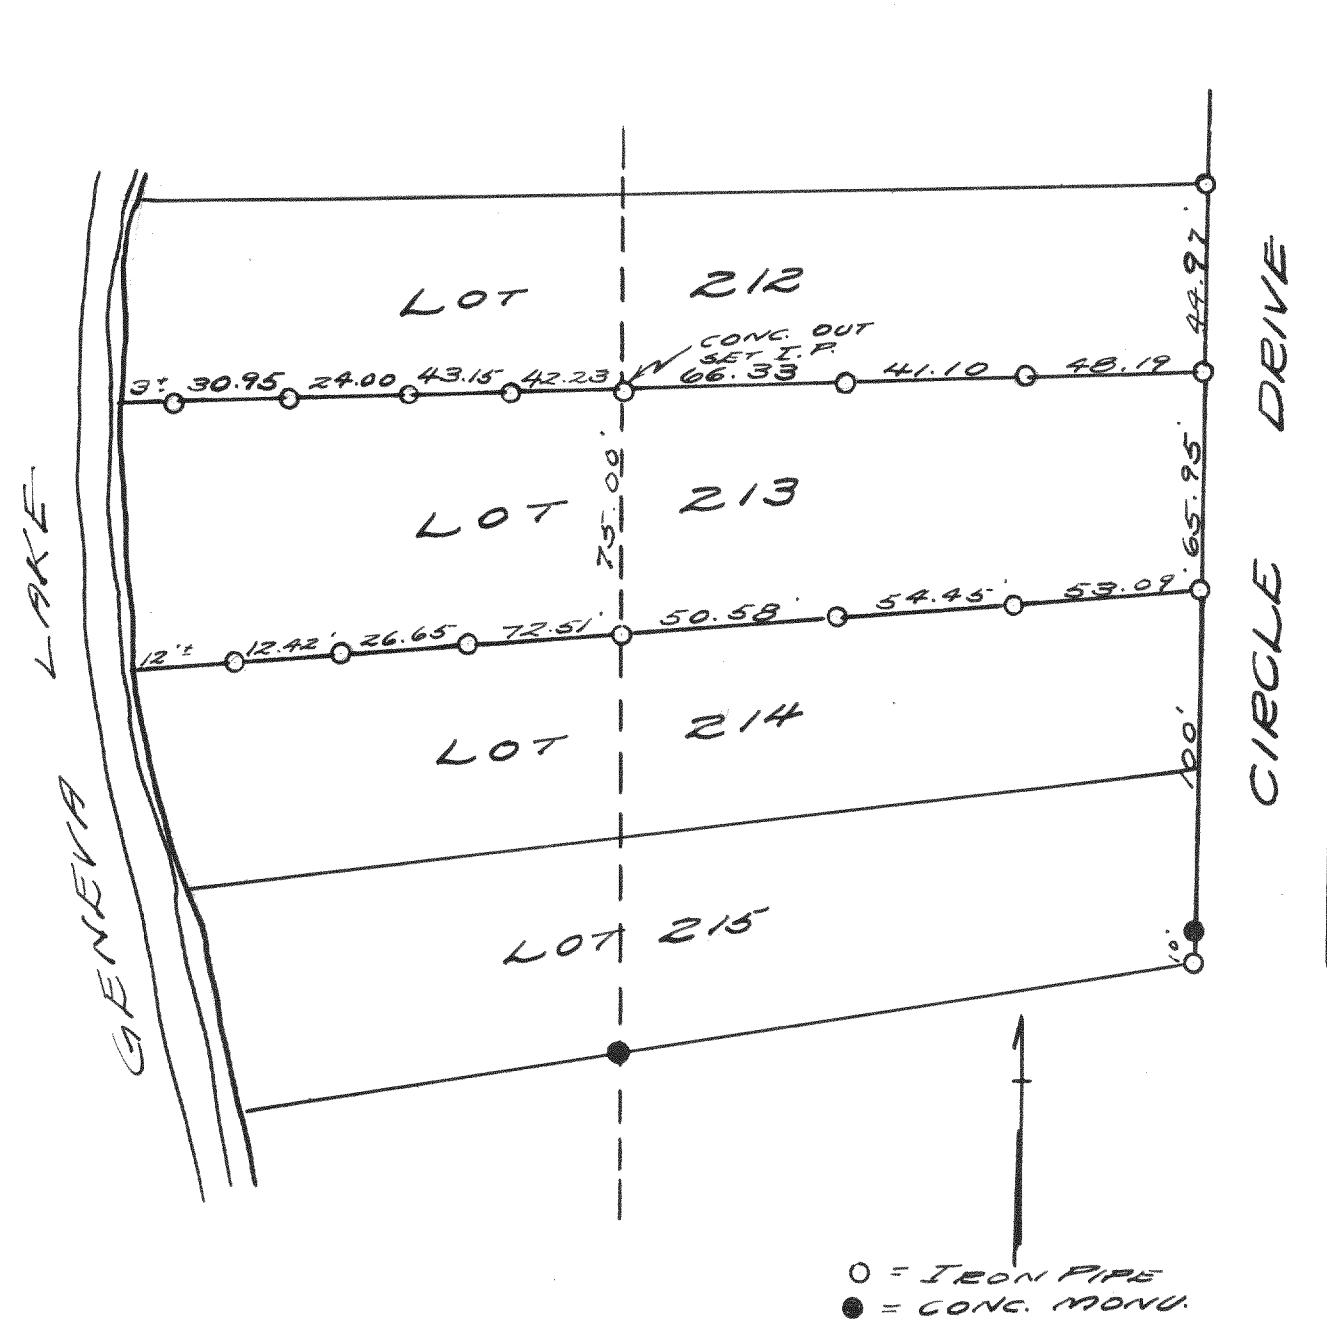


PLAT OF SURVEY OF LOT 213 OF THE
THIRD ADDITION TO CEDAR POINT PARK,
IN THE VILLAGE OF WIS. BAY, WALWORTH CO.
WISCONSIN.

JUNE, 1941

Lloyd L. Jensen
S.E.J.

SURVEY NO. 128

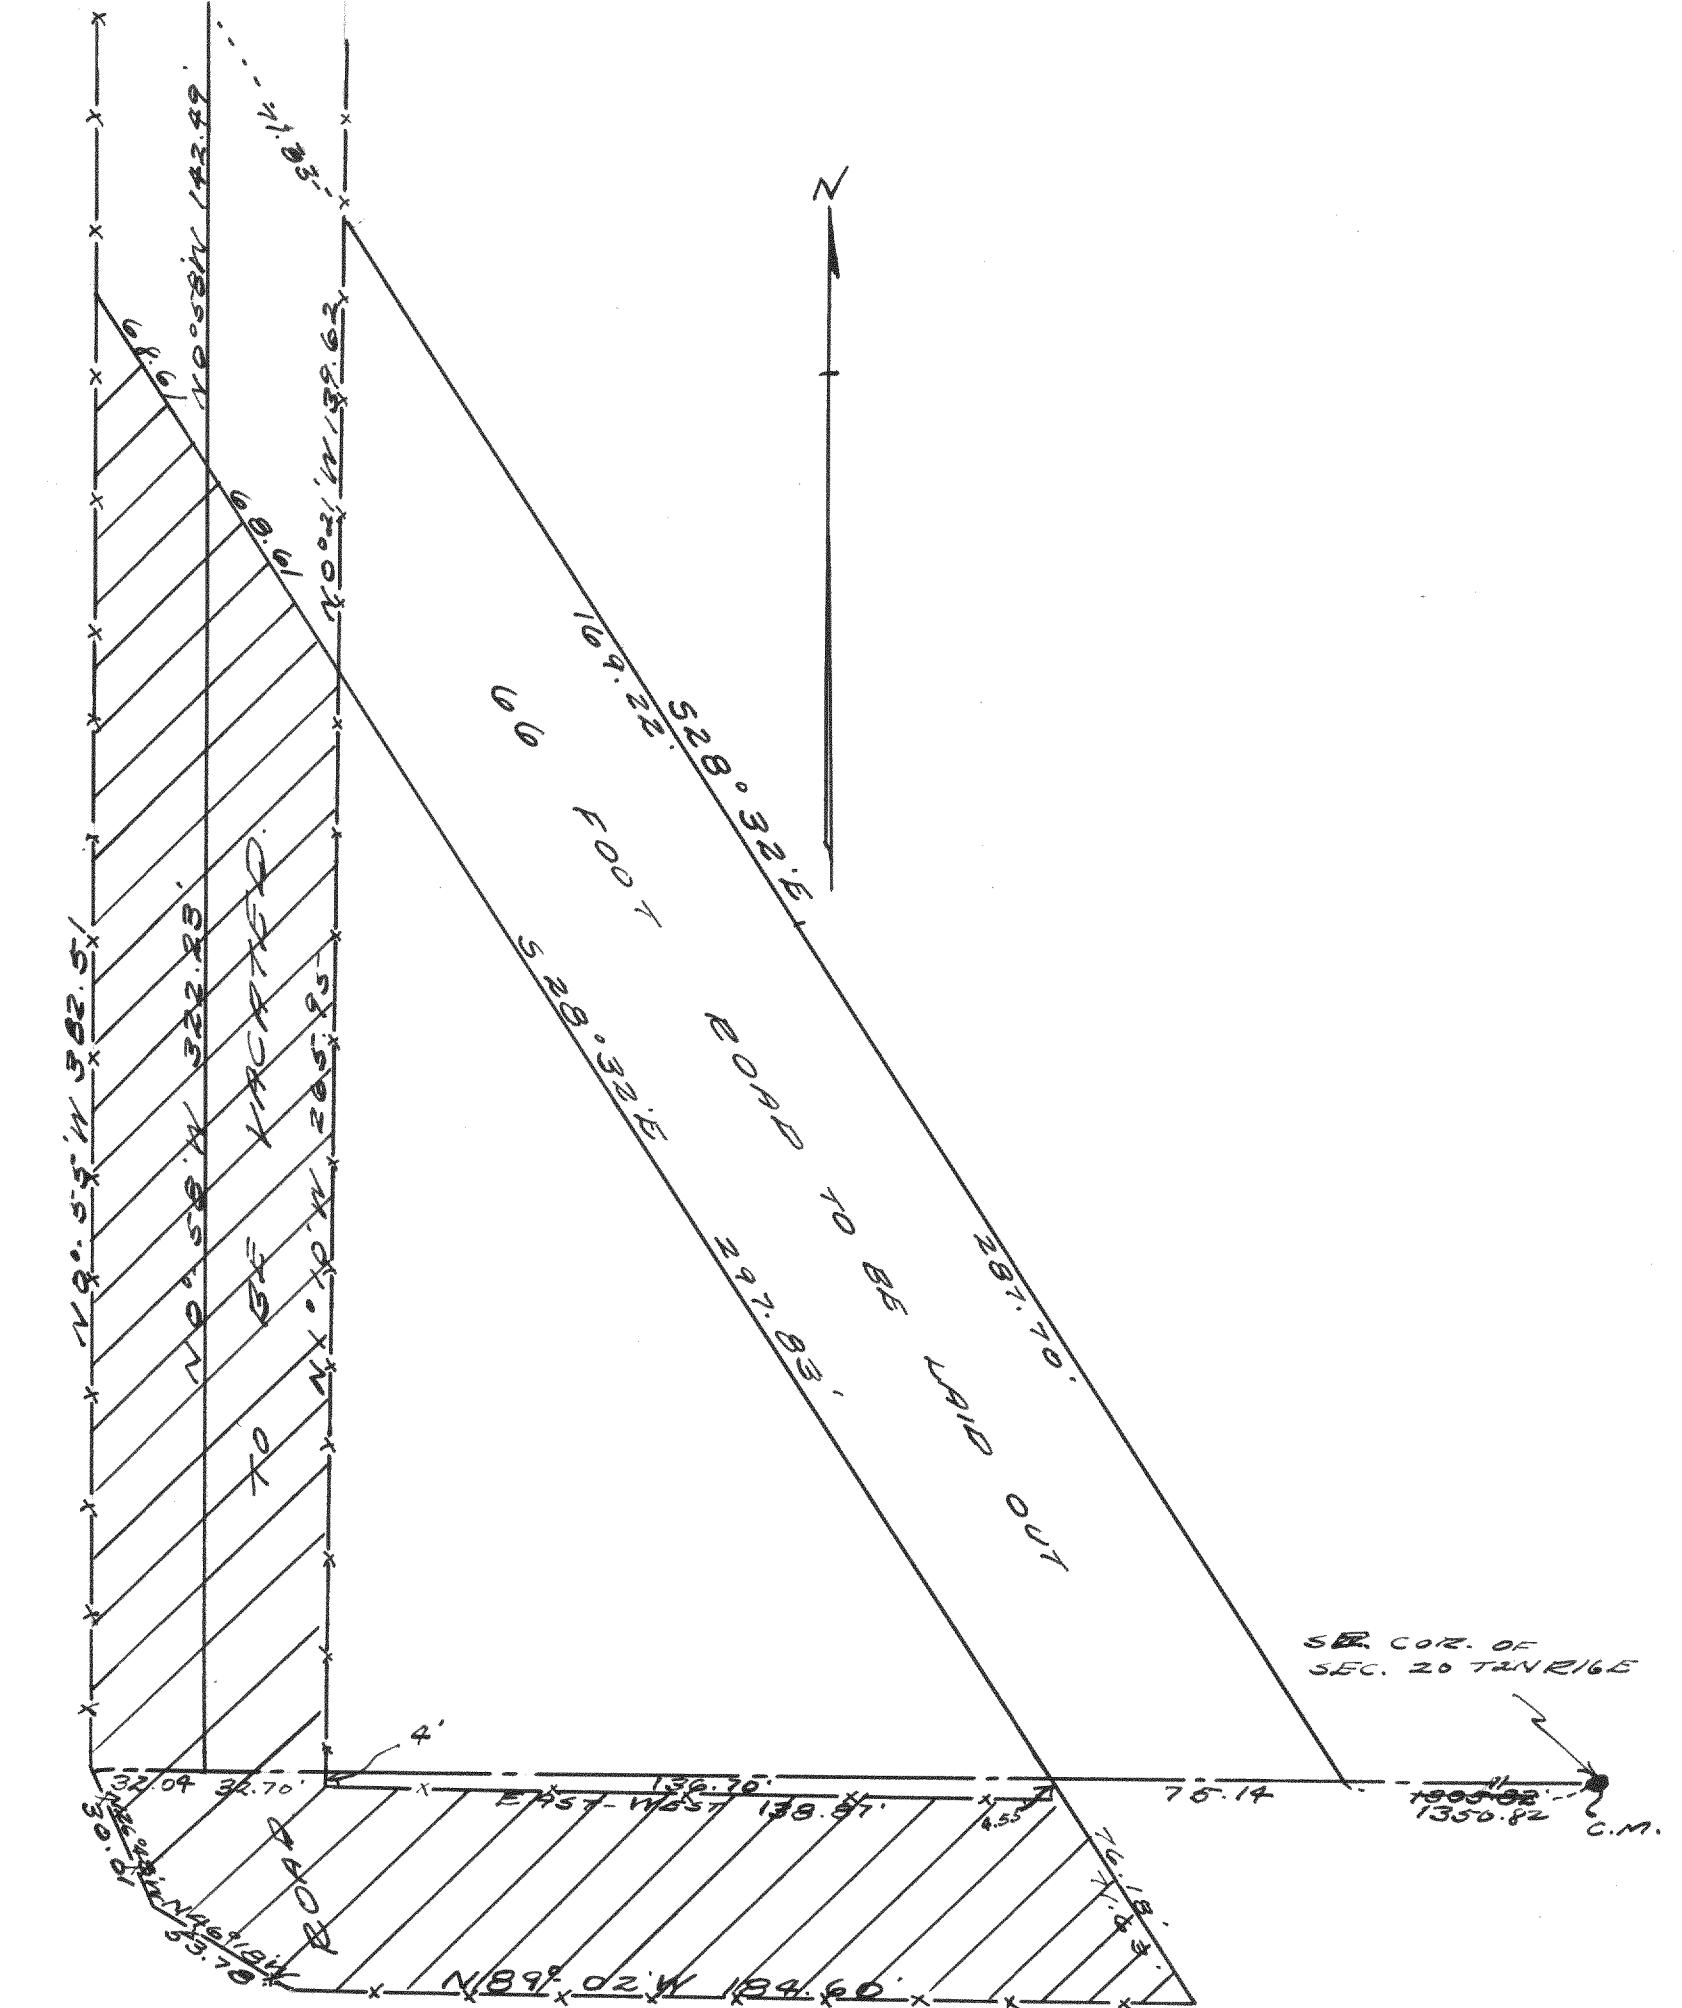

PLAT OF SURVEY OF A ROAD TO BE LAID OUT
AND A ROAD TO BE VACATED IN THE SE $\frac{1}{4}$ OF
SECTION 20 TZN R16E, WALWORTH CO., WISC.
FEB., 1942

FEB., 1942

Lloyd L. Jensen
K.E.J.