


2427

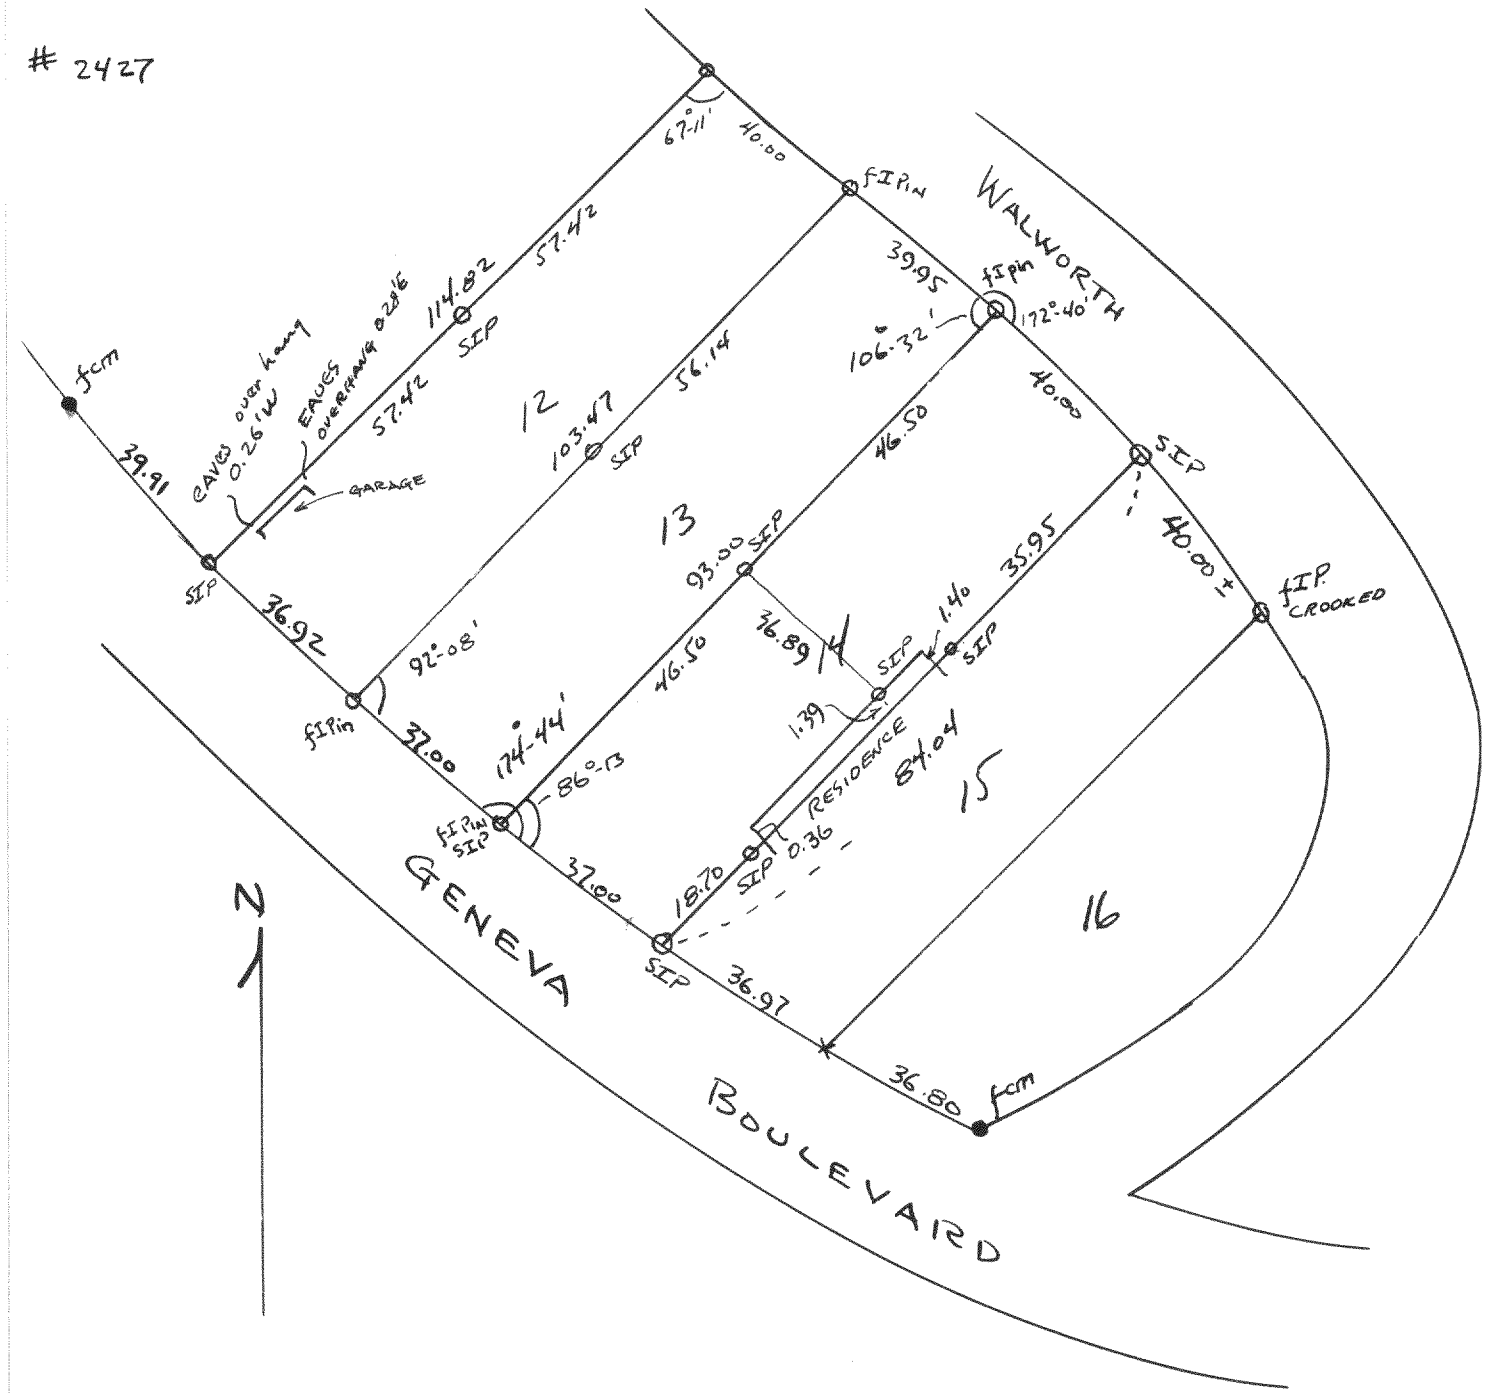

Plat of Survey of lots 12 & 14, Block 7
 Glenwood Springs, Village of Fontana,
 Walworth County, Wisconsin
 Oct 26, 1951

Lloyd S. Jensen 923
 County Surveyor


2428



Plat of survey of lots 69, 70 & 71 of Unit 2 Country Club
 Estates, Village of Fontana, Walworth County, Wisconsin
 Nov. 6, 1951

Lloyd S. Jensen 923
 County Surveyor

2429

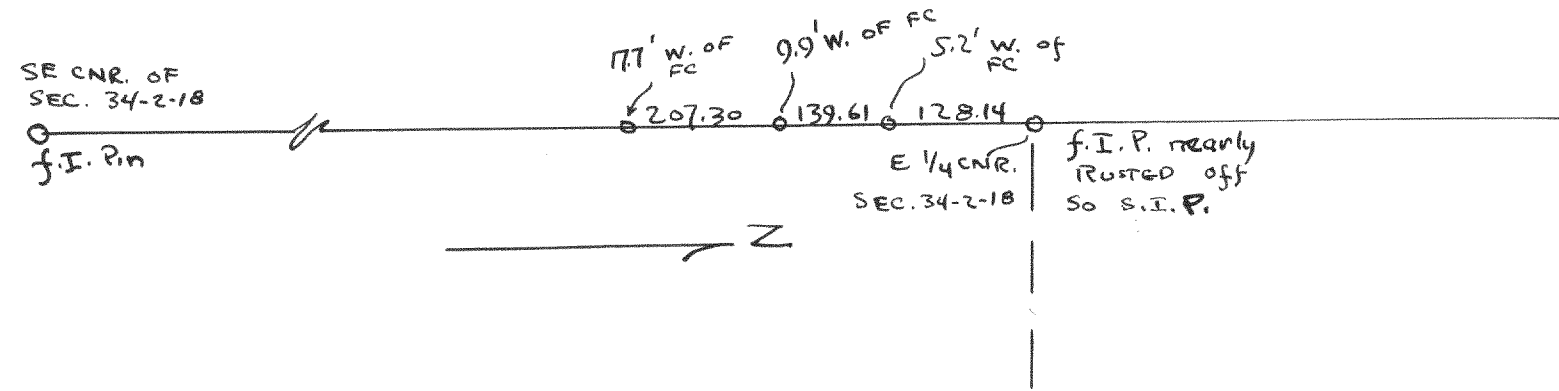

Plat of iron pipe set on the $\frac{1}{2}$ of the East line of Section 34-2-18
 Walworth County, Wisconsin
 1951

Lloyd S. Jensen 923
 County Surveyor