



2437

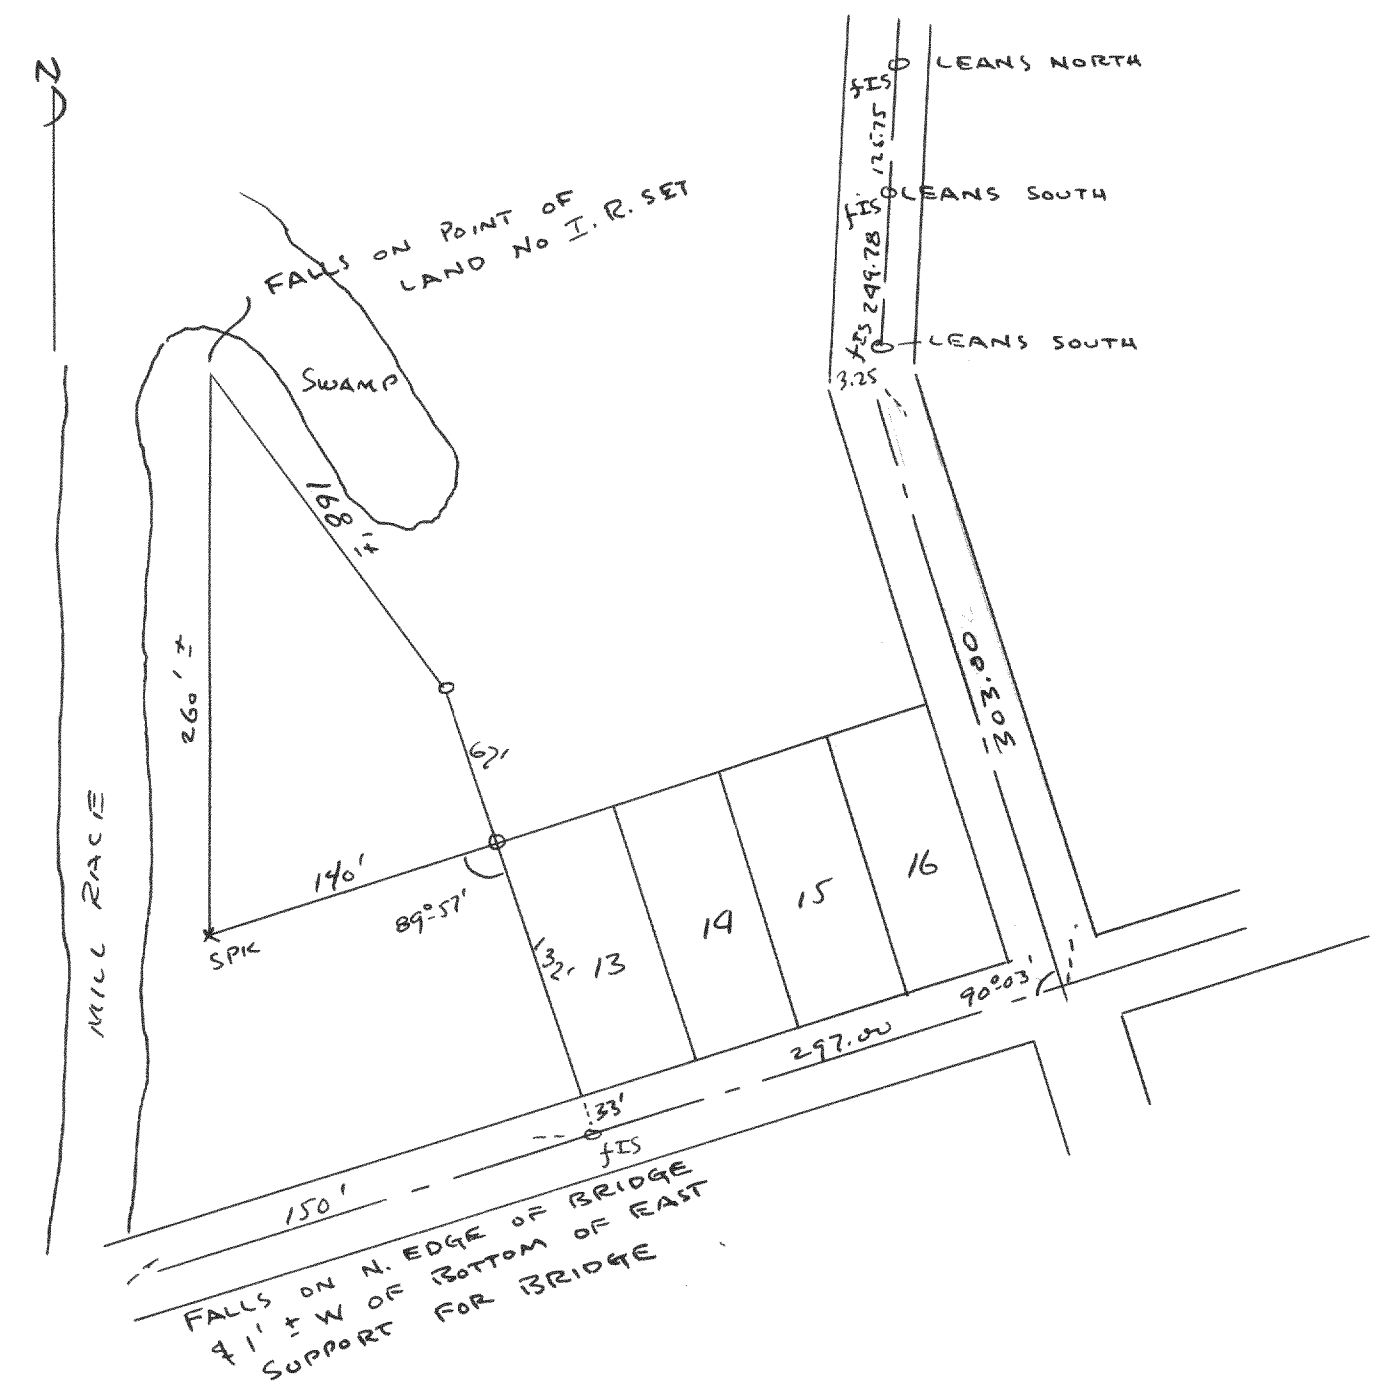

Plat of survey of parcel of land located between Lot 13 of Original Town and the Mill Race, Village of Lyons, Walworth County, Wisconsin
 April 18, 1951

Lloyd L. Jensen JCB
 County Surveyor

2438

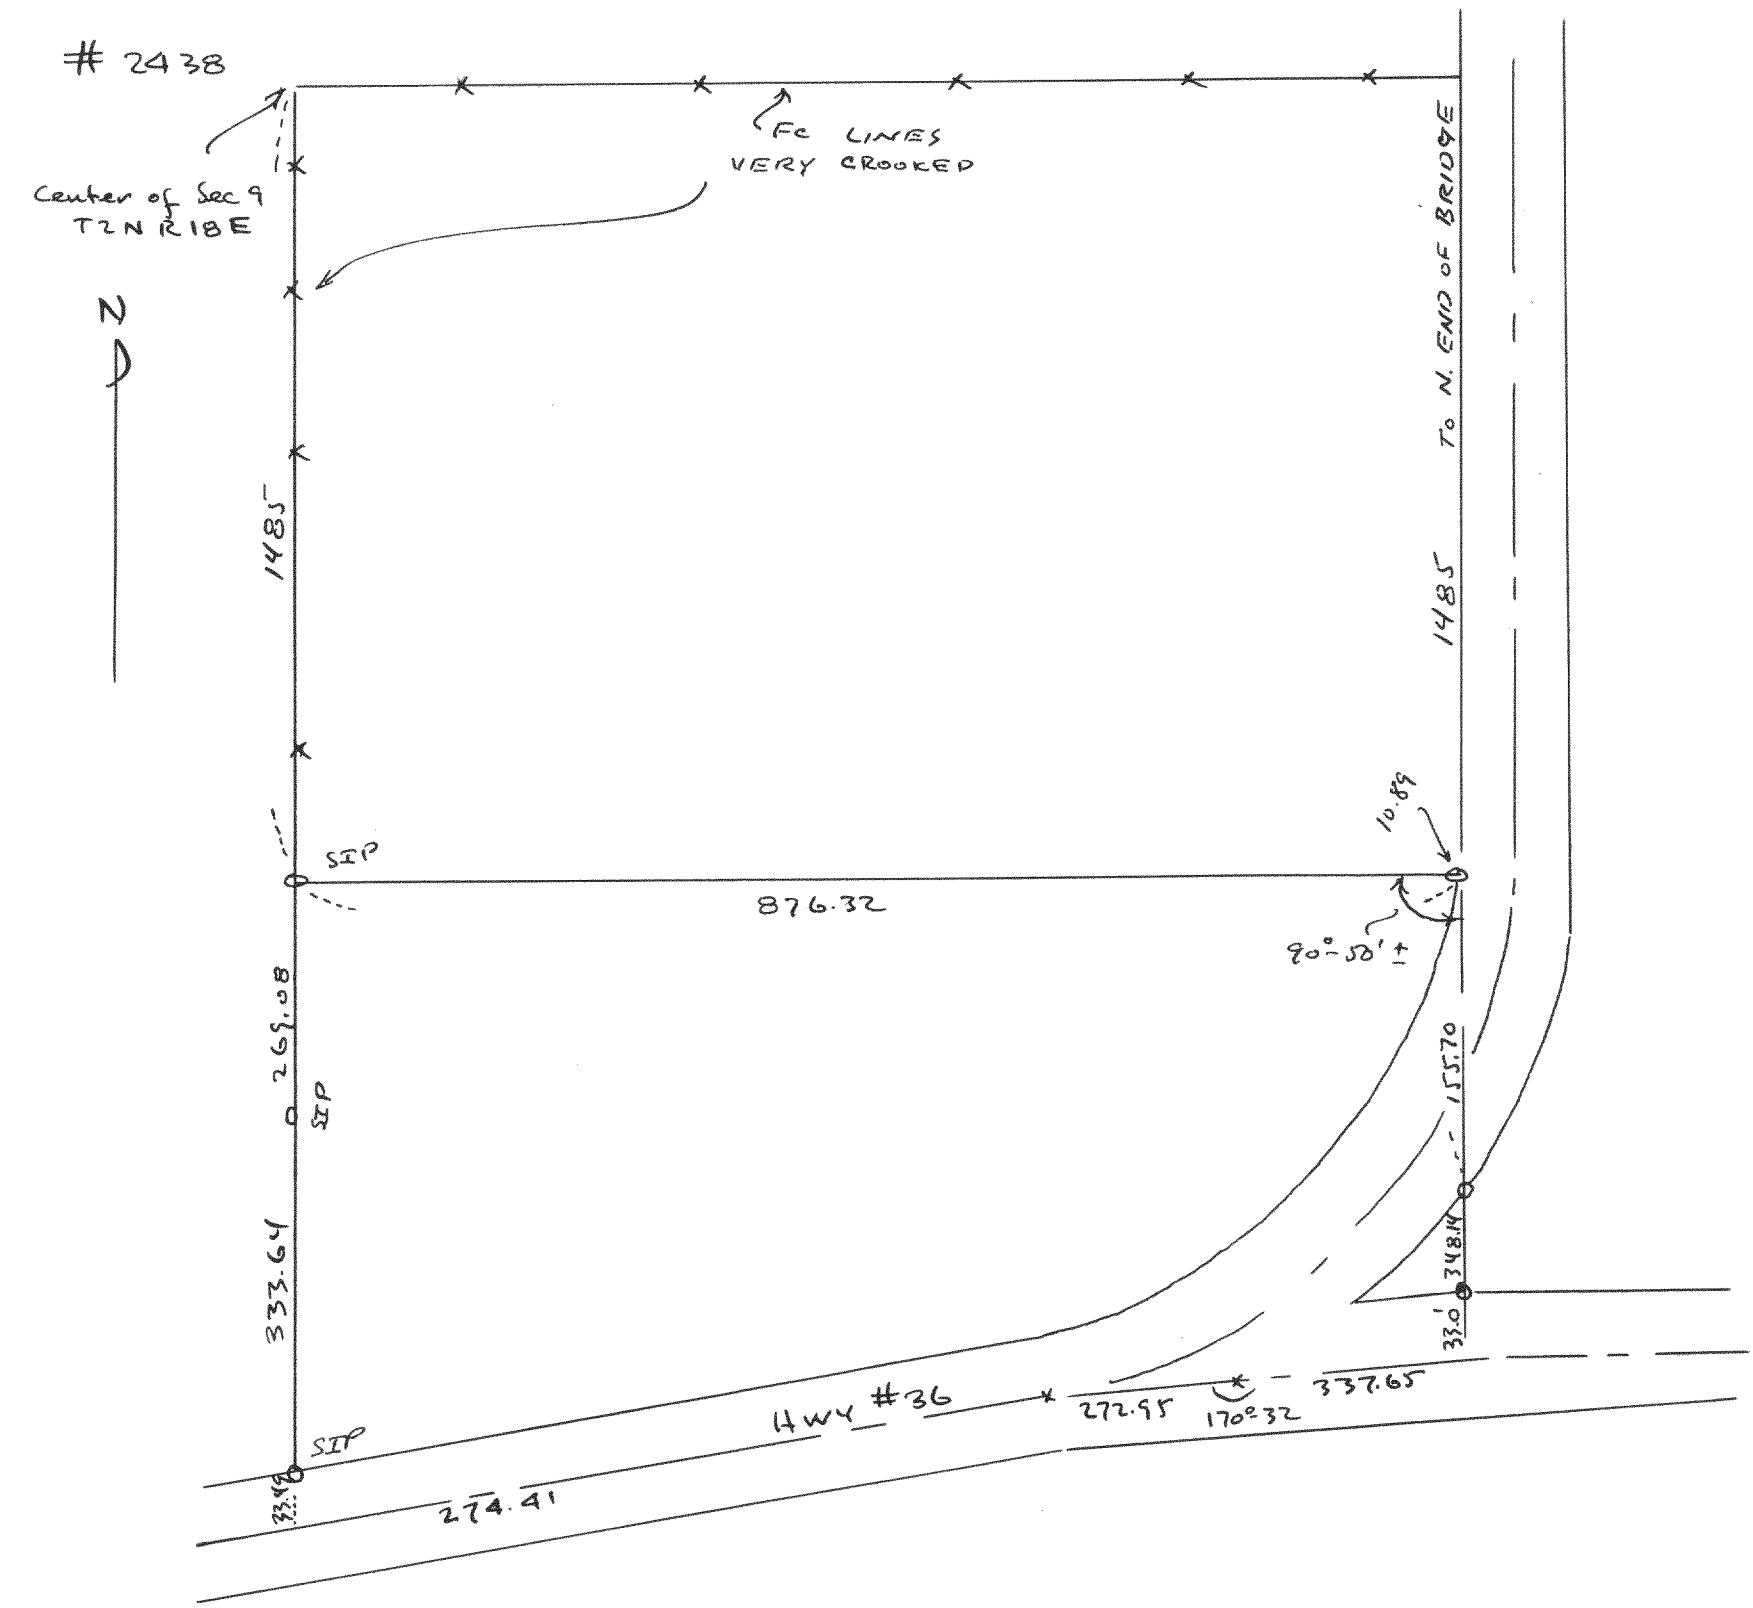

Plat of survey of Fellows property located in the SE 1/4 of Sec 9, T2N R18E Walworth County, Wisconsin
 Sept 14, 1951

Lloyd L. Jensen JCB
 County Surveyor