



2498

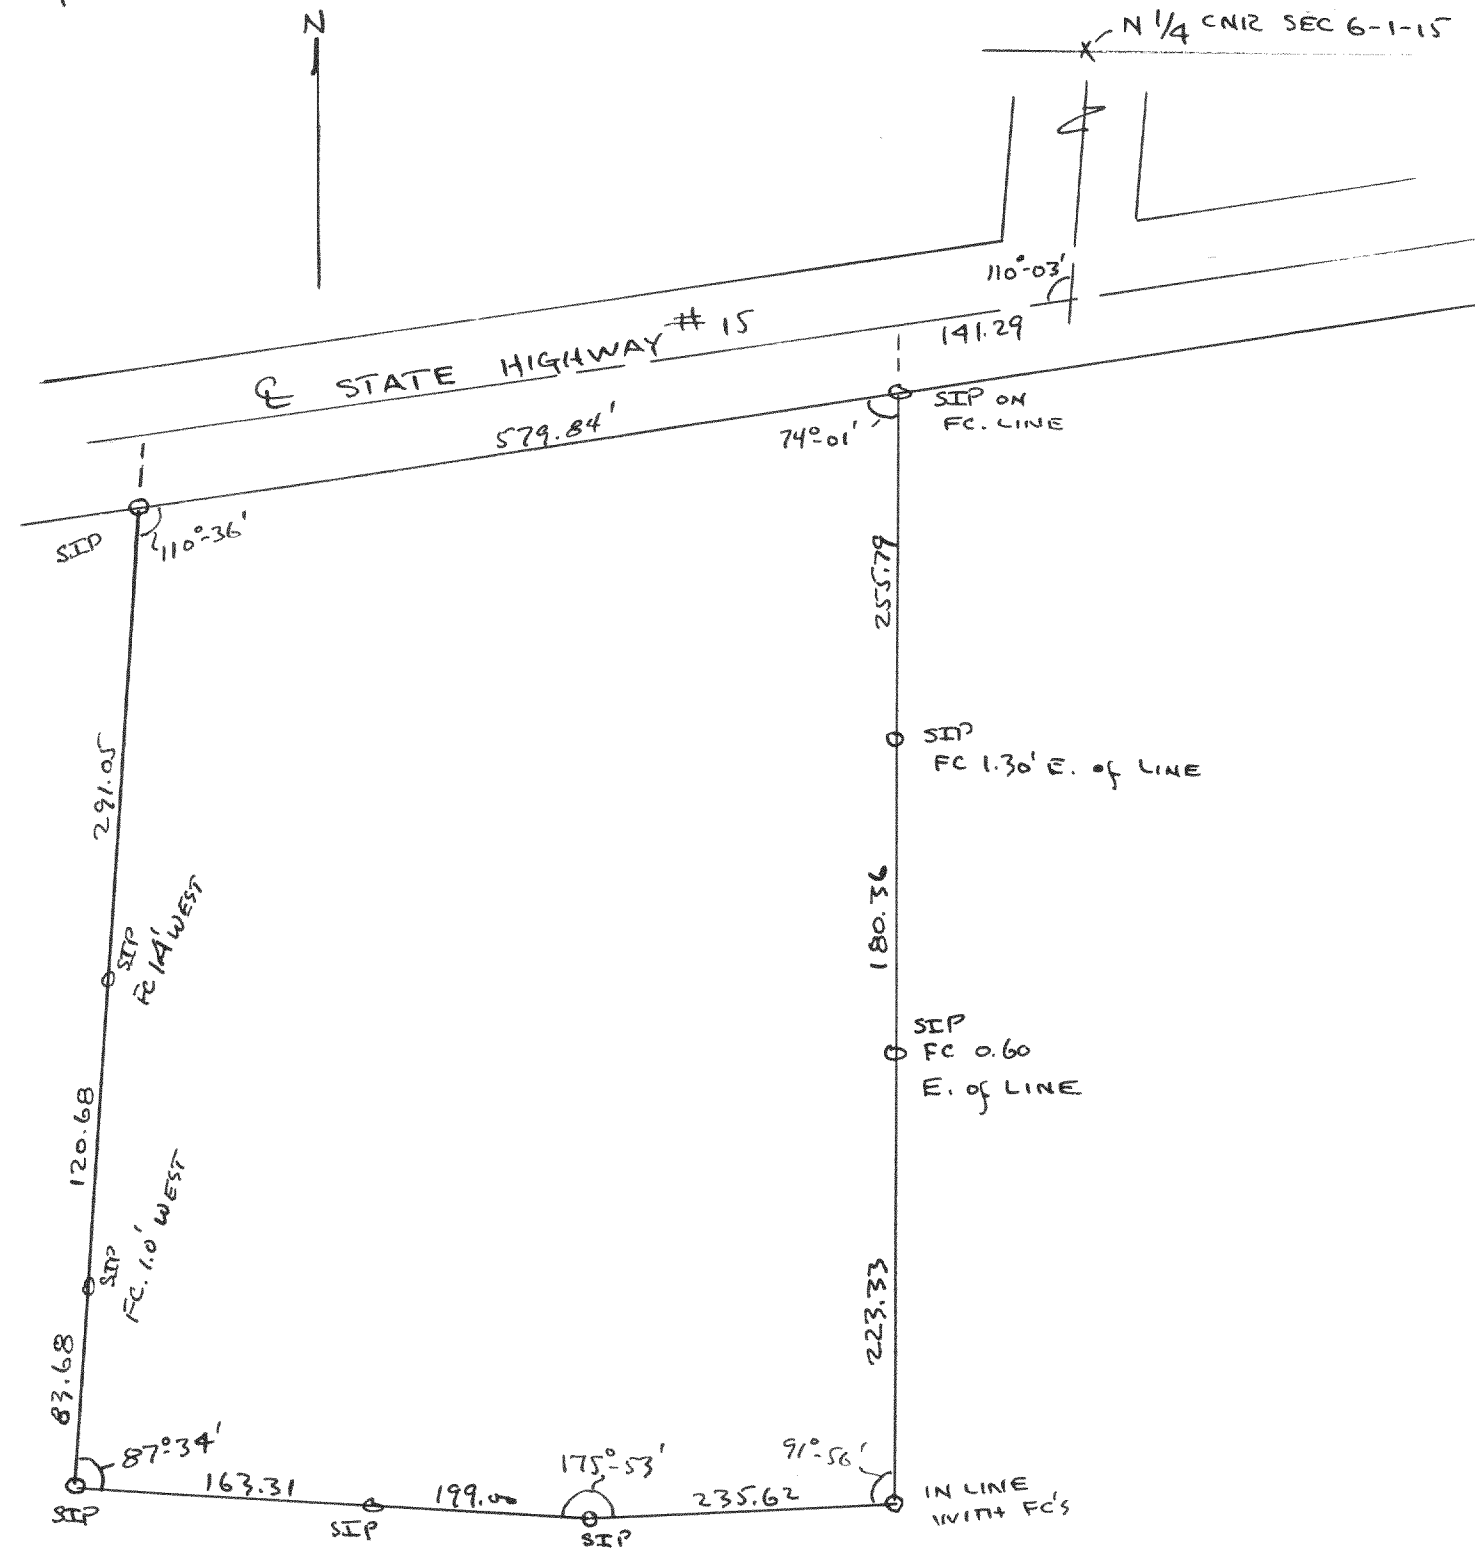

Plat of survey of the Gargas Property located in allens
 Grove, Section 6, TIN RISE, Walworth County, Wisconsin
 1951
 Lloyd L. Jensen ges
 County Surveyor

2499

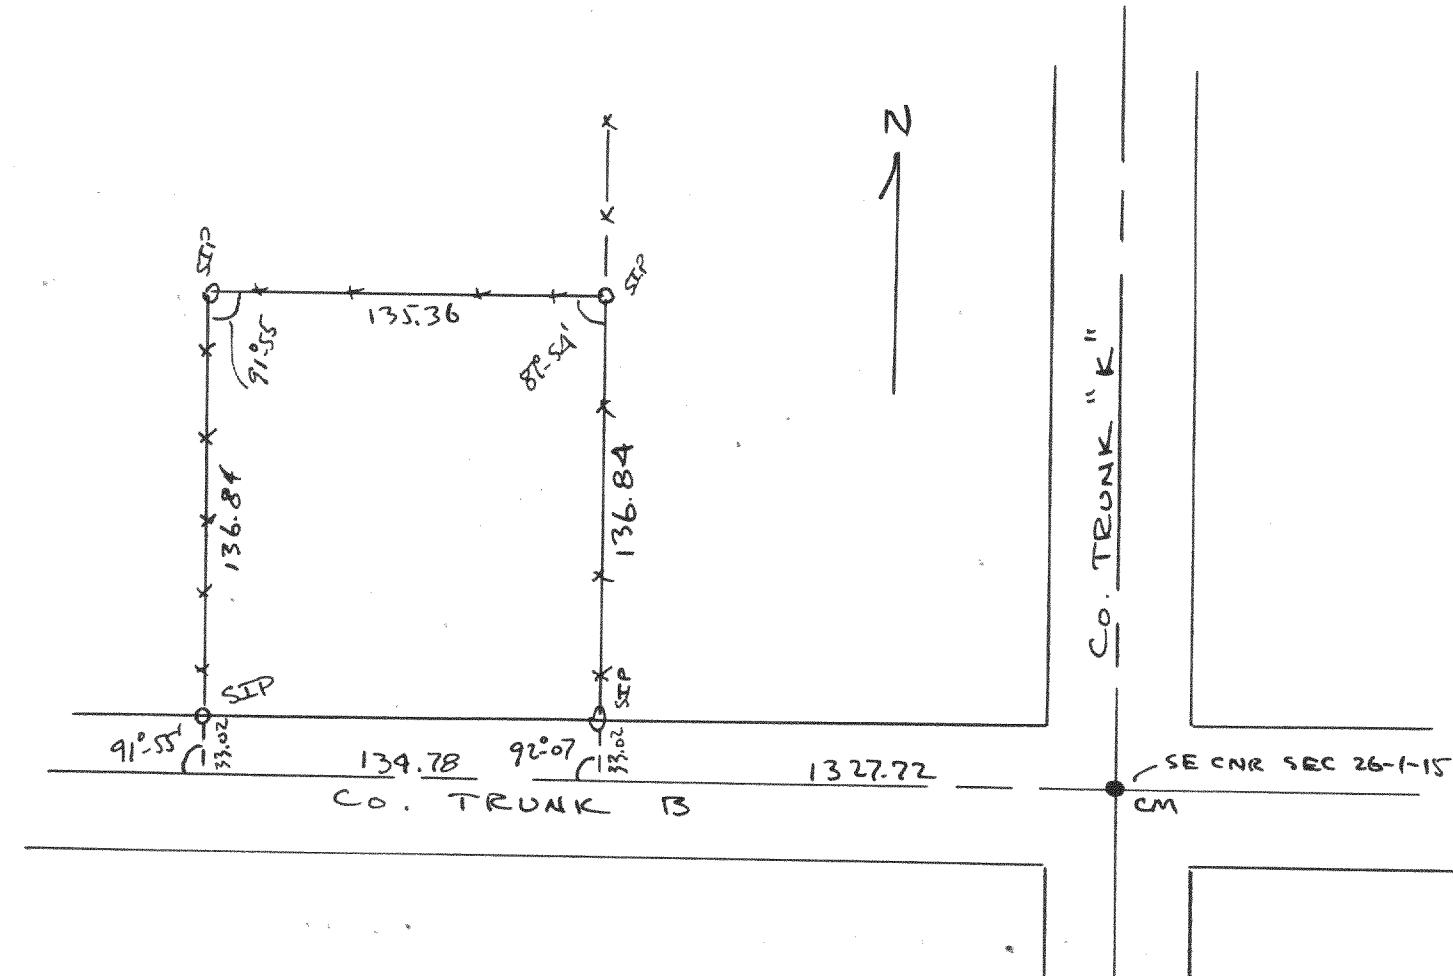

Plat of survey of the property occupied by the school located
 in the SE 1/4 of Section 26, TIN RISE, Walworth County, Wisconsin
 Aug. 21, 1951
 Lloyd L. Jensen ges
 County Surveyor