


#1317

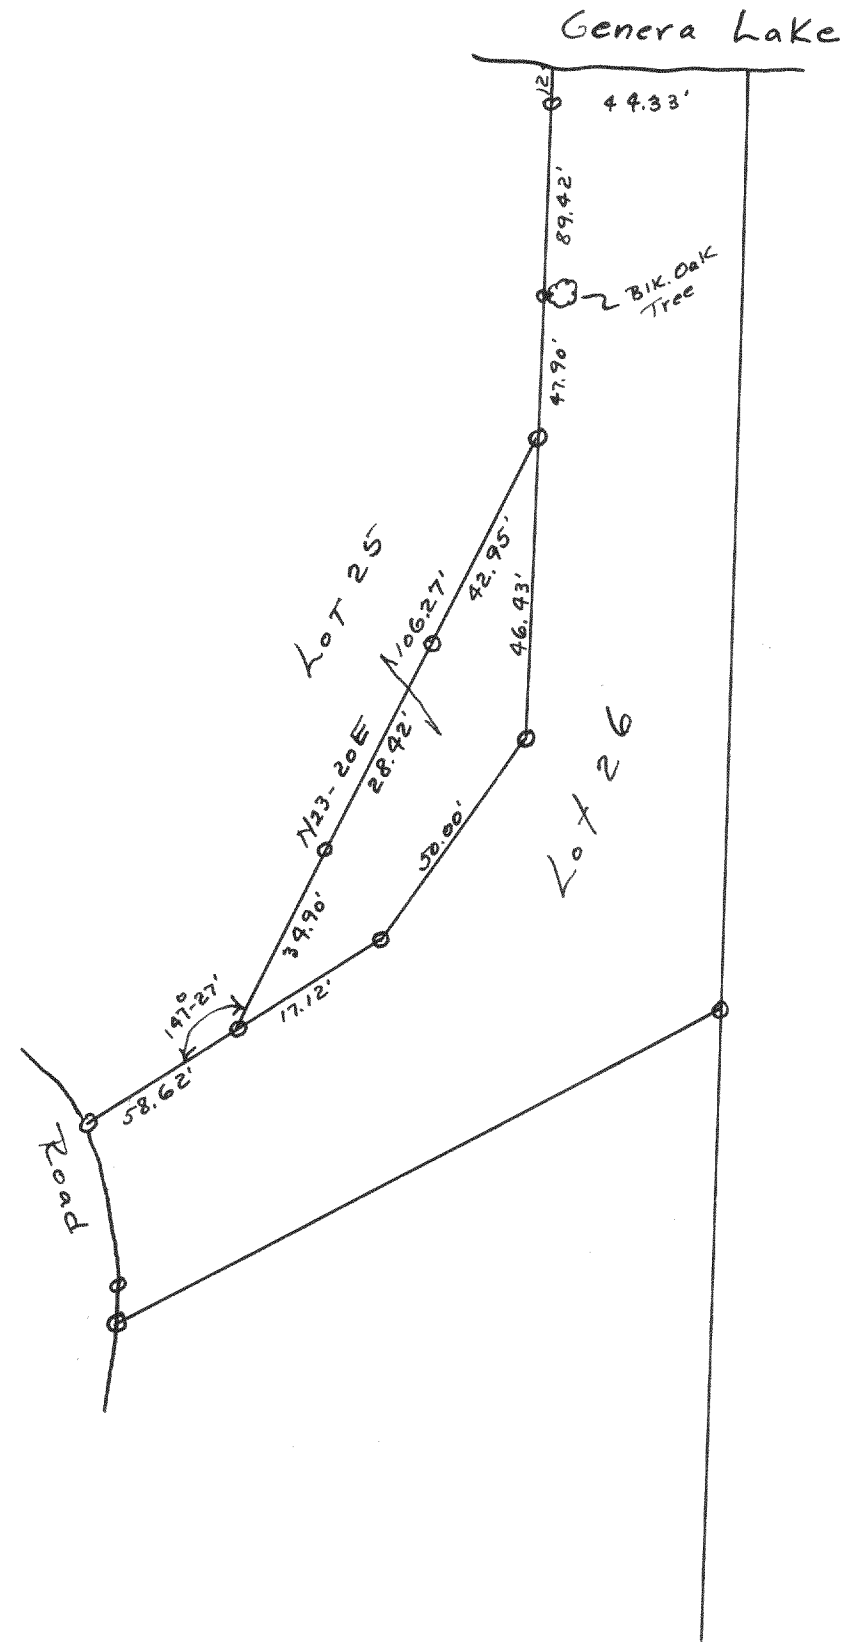


Plot of survey of part of Lot 25 of
Block I of Indian Hills Subd.
Village of Fontana Wisconsin.

July 1942

Lloyd D. Jensen
County Surveyor

#1318

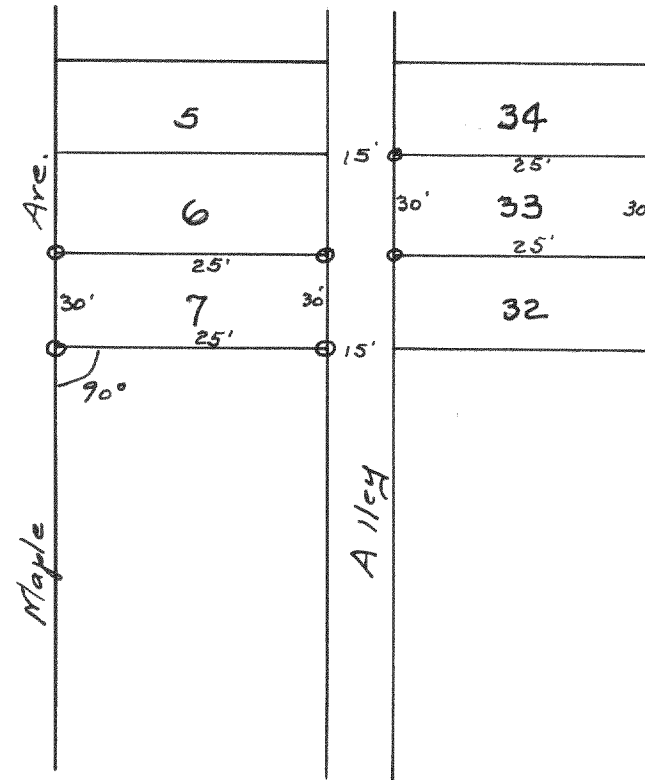

Plot of survey of lots 7 and 33
of Addition to Glenwood Springs

Sept. 30, 1942

Lloyd D. Jensen
County Surveyor