


#1330

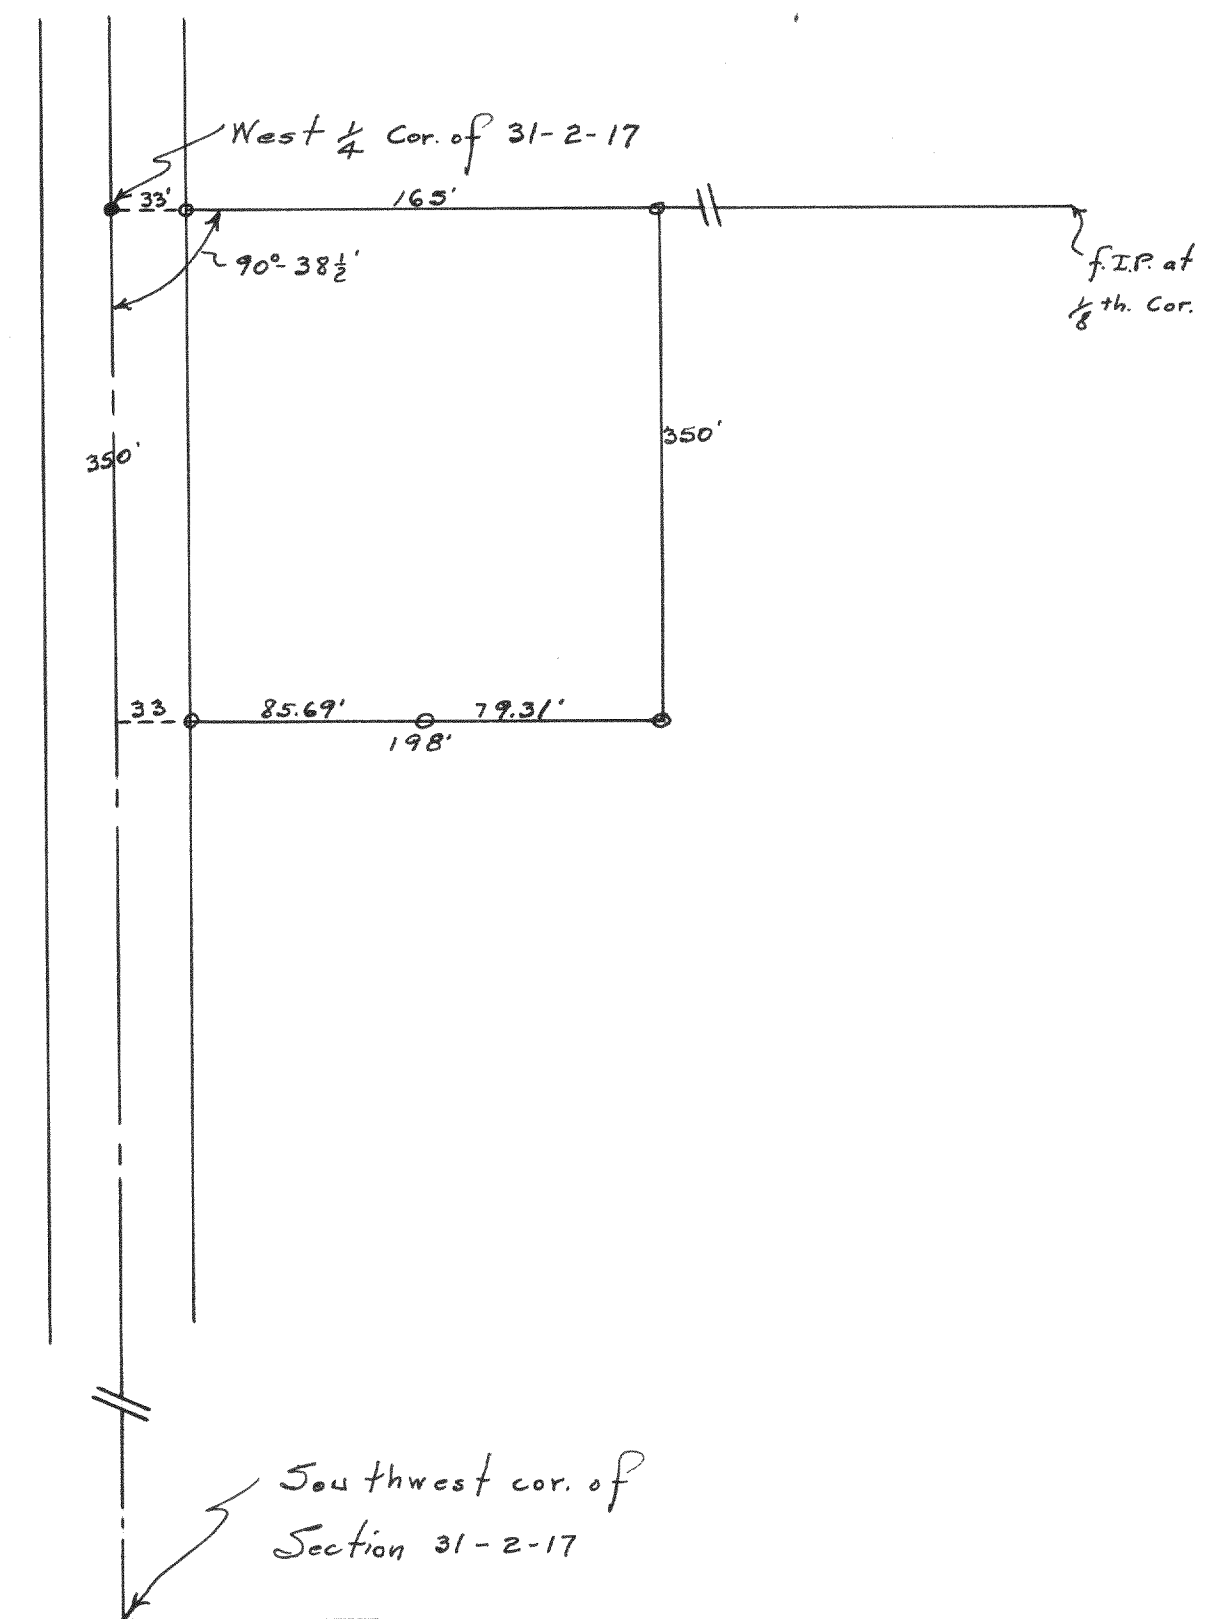


Plot of survey of land for Frank Johnson - dividing up part of their home property.

July 1942

Lloyd L. Jensen
County Surveyor

#1331

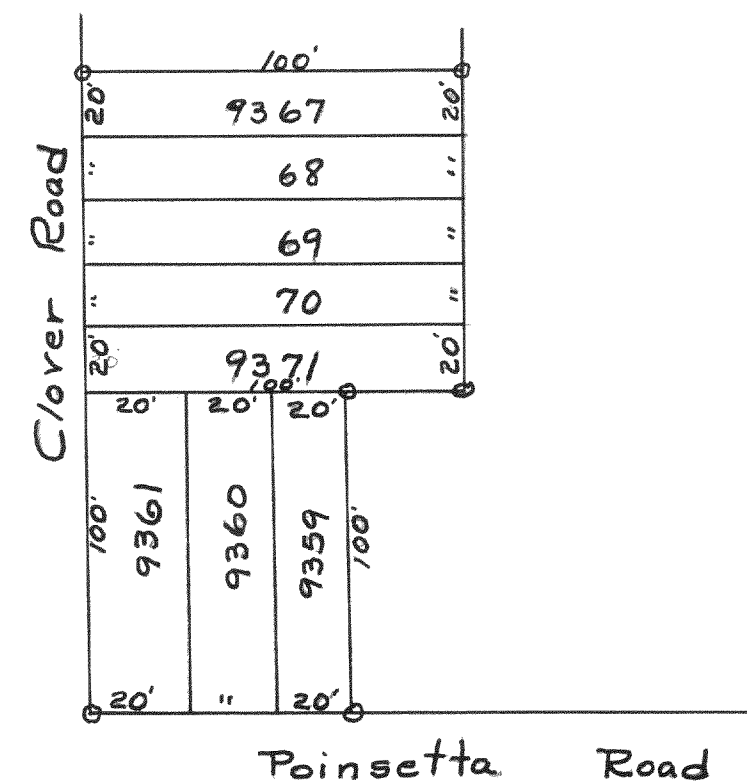

Plot of survey of Lots at Bell Lake Subdivision.

Sept. 1941

Lloyd L. Jensen
County Surveyor