


#3056

LOT 1 OF ADDITION "A"
TO COUNTRY CLUB ESTATES
LOCATED IN THE VILLAGE
OF FONTANA ON GENEVA
LAKE, WALWORTH COUNTY
WISCONSIN
MAY 1955


LLOYD L. JENSEN
COUNTY SURVEYOR

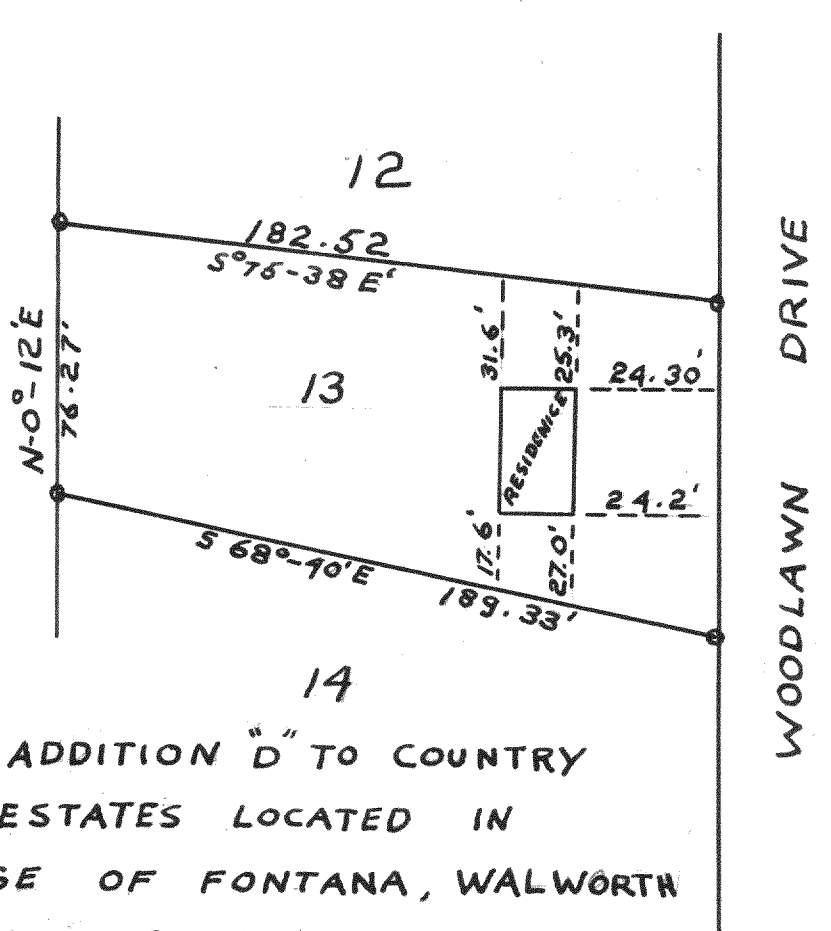

#3058

LOT 13 ADDITION "D" TO COUNTRY
CLUB ESTATES LOCATED IN
VILLAGE OF FONTANA, WALWORTH
COUNTY, WISCONSIN

JULY 1955
LLOYD L. JENSEN
COUNTY SURVEYOR

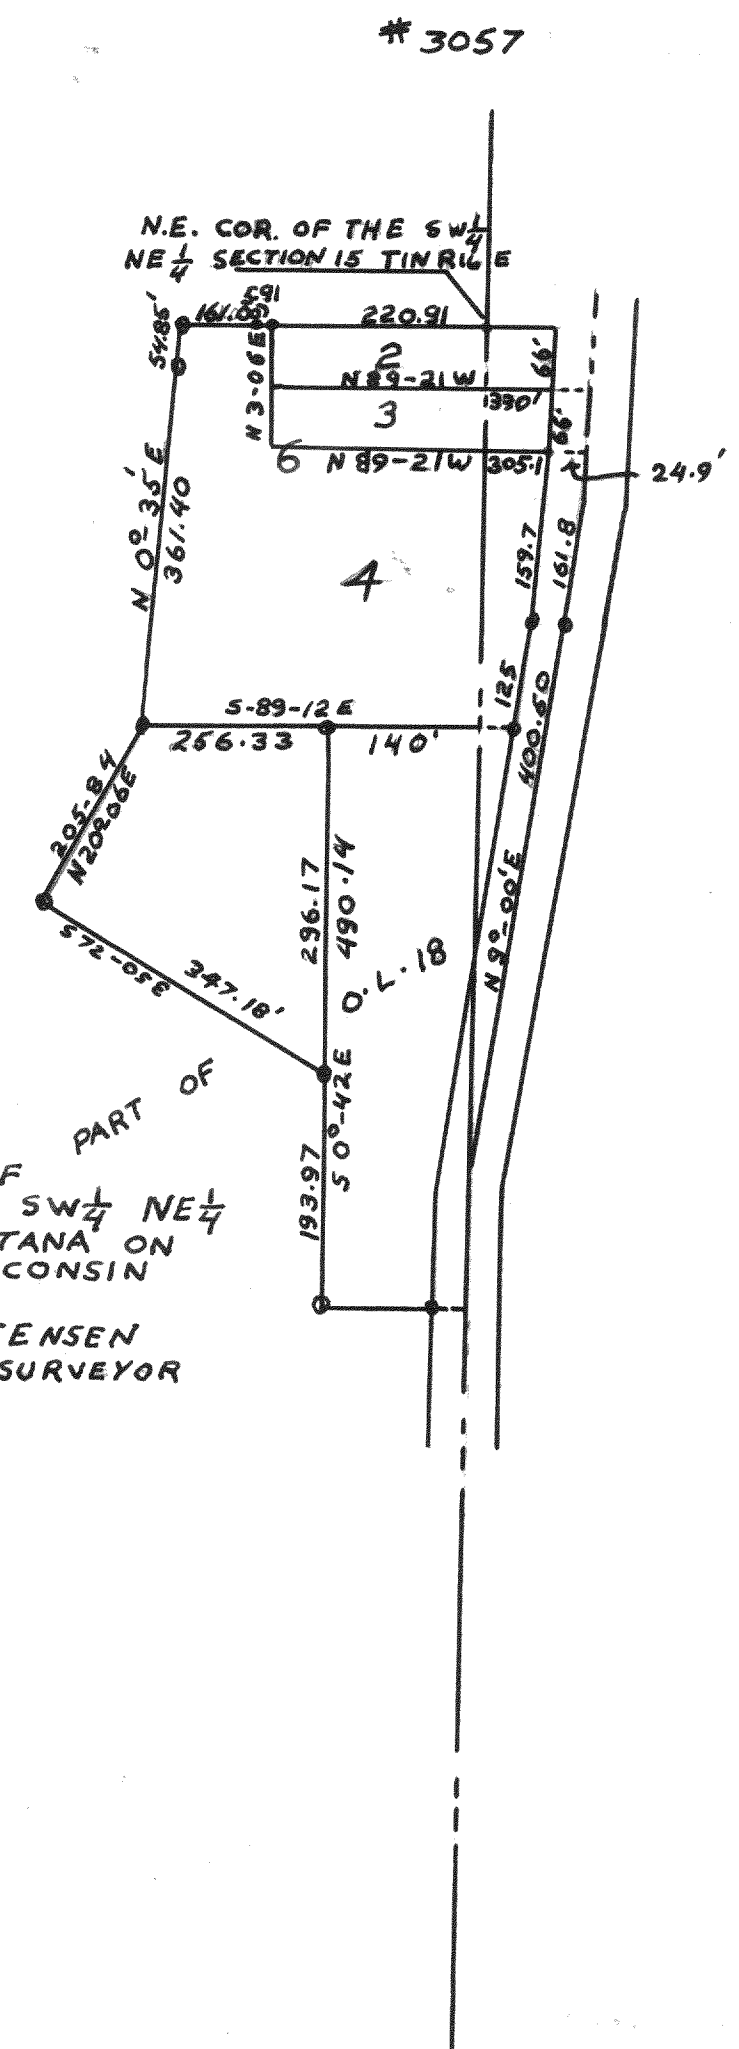

#3057

LOTS 3 & 4; BLOCK 6 OF C.L.
DOUGLASS ADD. AND PART OF O.L. 18 OF
ASSESSORS PLAT NO. 1 LOCATED IN THE SW 1/4 NE 1/4
SECTION 15, T16R16E VILLAGE OF FONTANA ON
GENEVA LAKE, WALWORTH COUNTY, WISCONSIN
APRIL 1955

LLOYD L. JENSEN
COUNTY SURVEYOR