


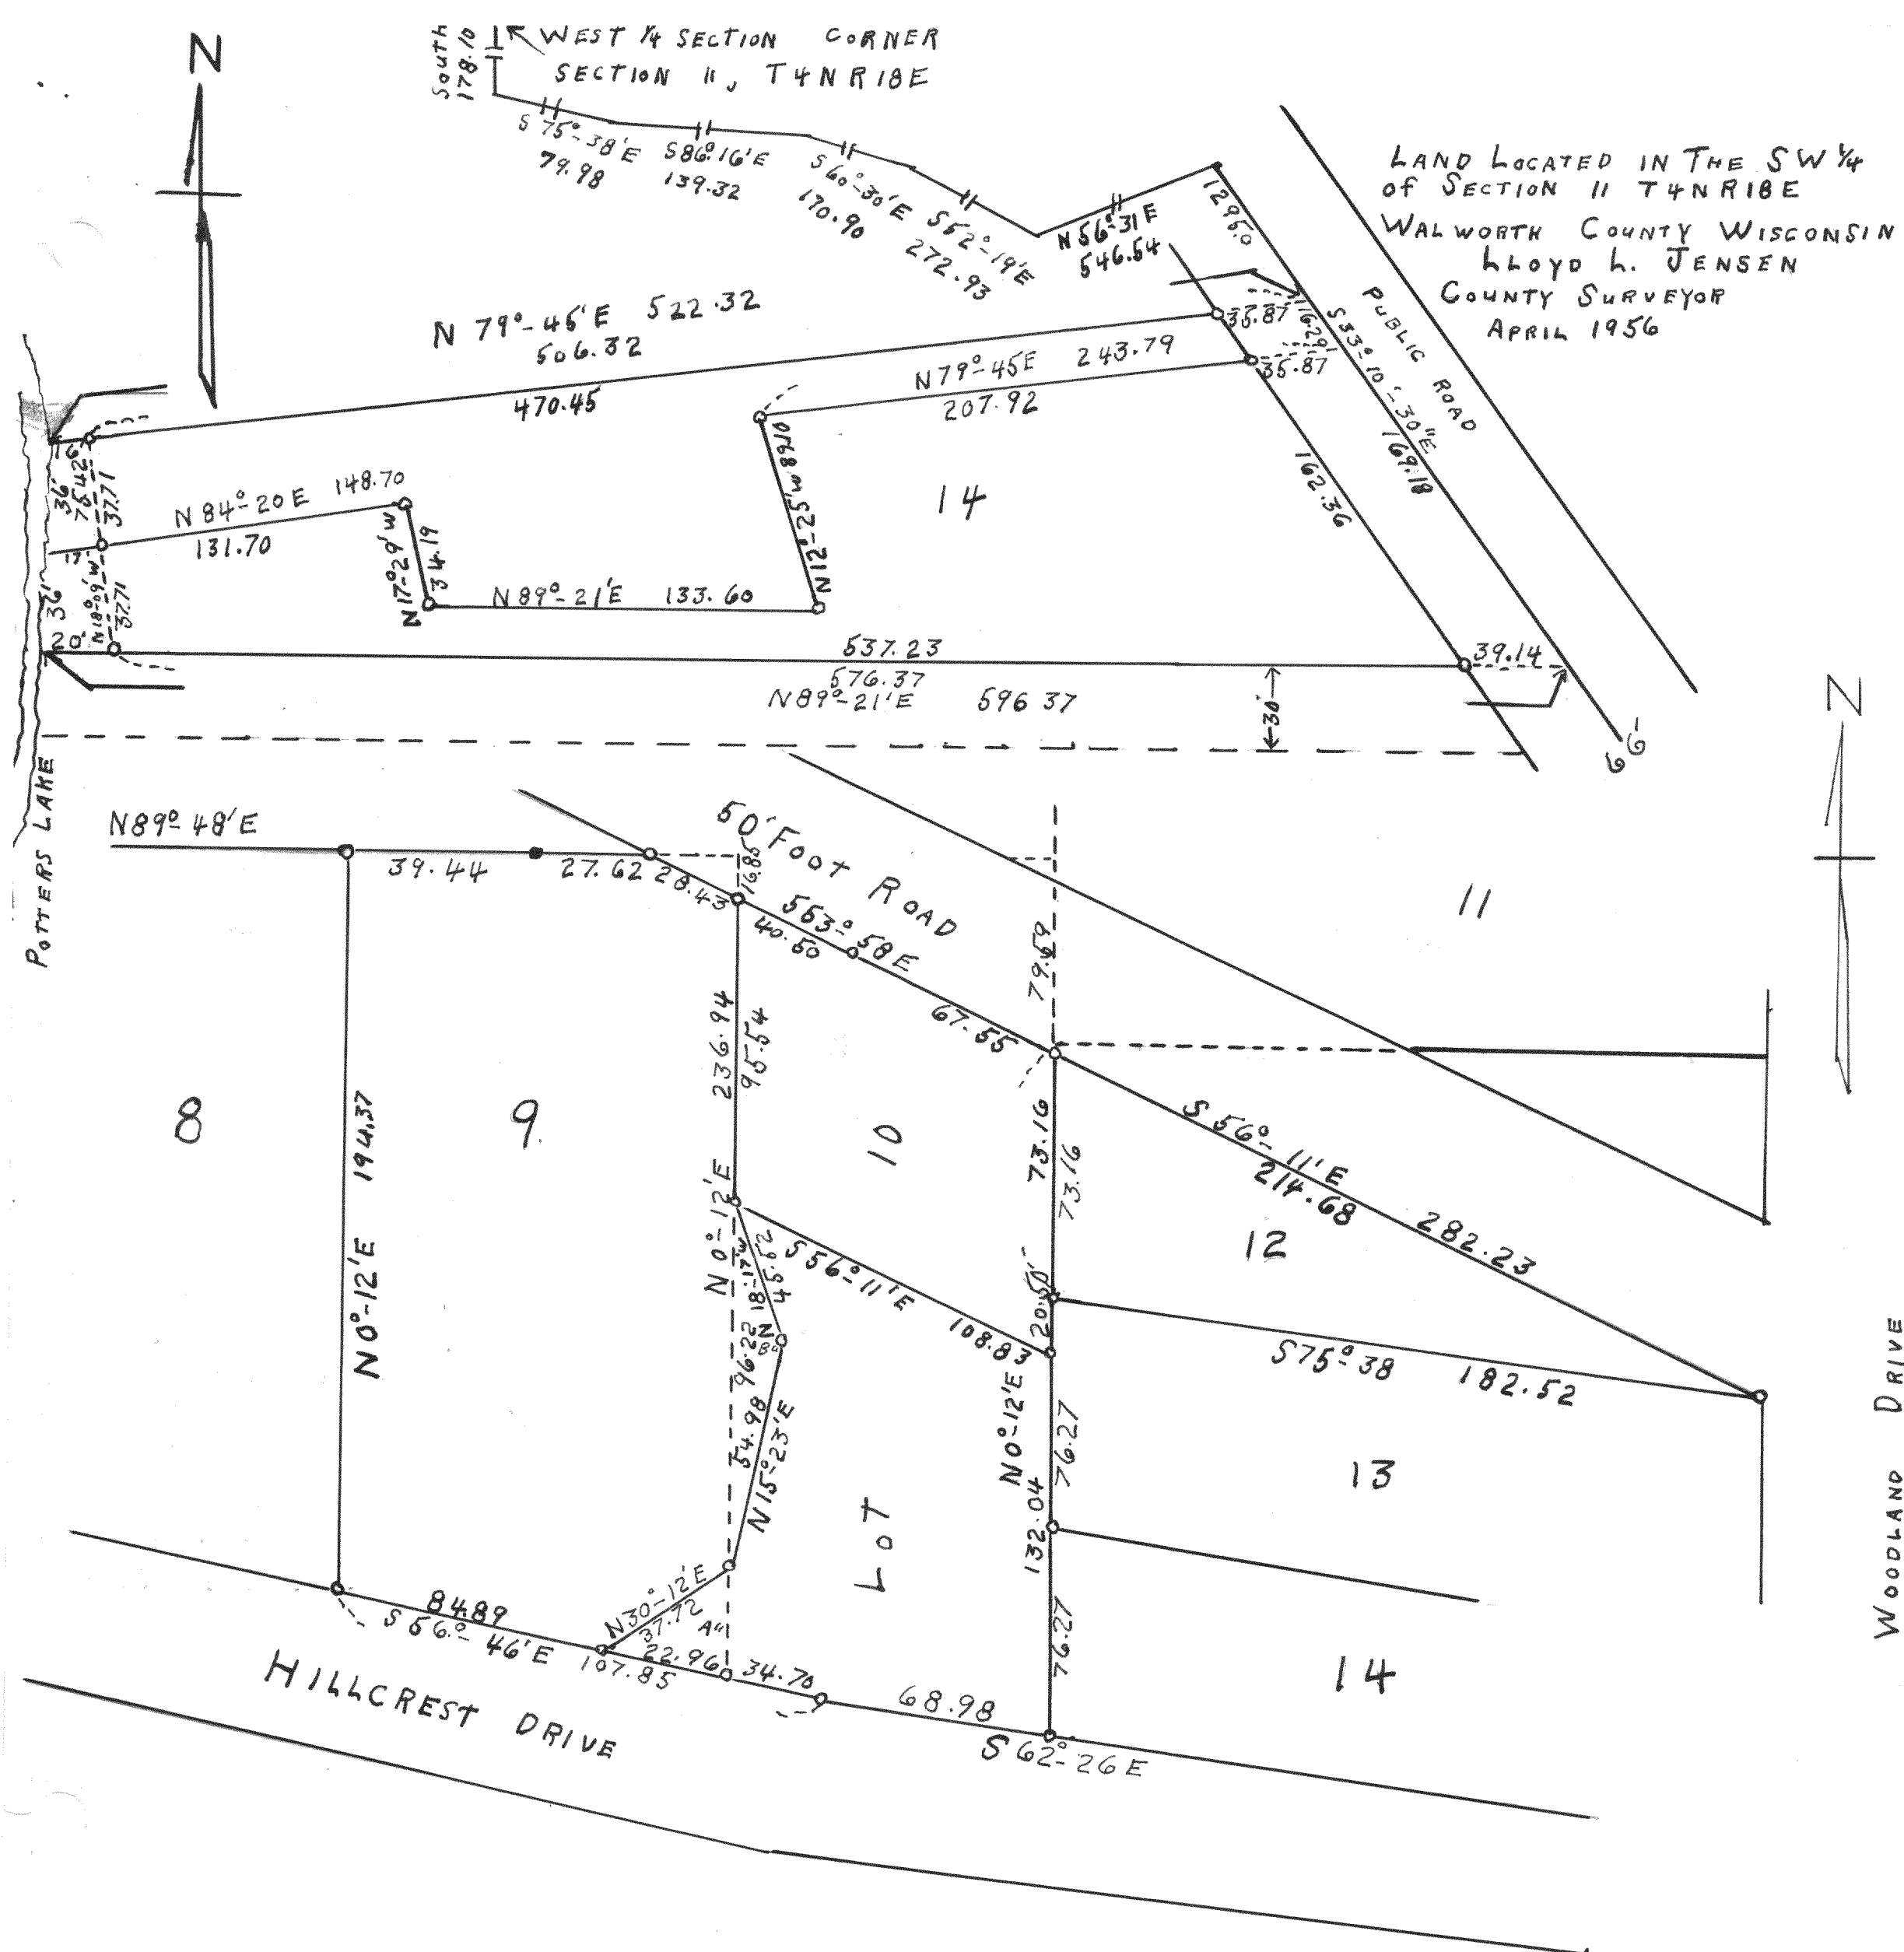

3087

3088

LOTS 9 AND 10 OF ADDITION
"D" TO COUNTRY CLUB ESTATES
LOCATED IN THE
VILLAGE OF FONTANA ON GENEVA LAKE
WALWORTH COUNTY WISCONSIN
LLOYD L. JENSEN
COUNTY SURVEYOR
APRIL 1986