




2656

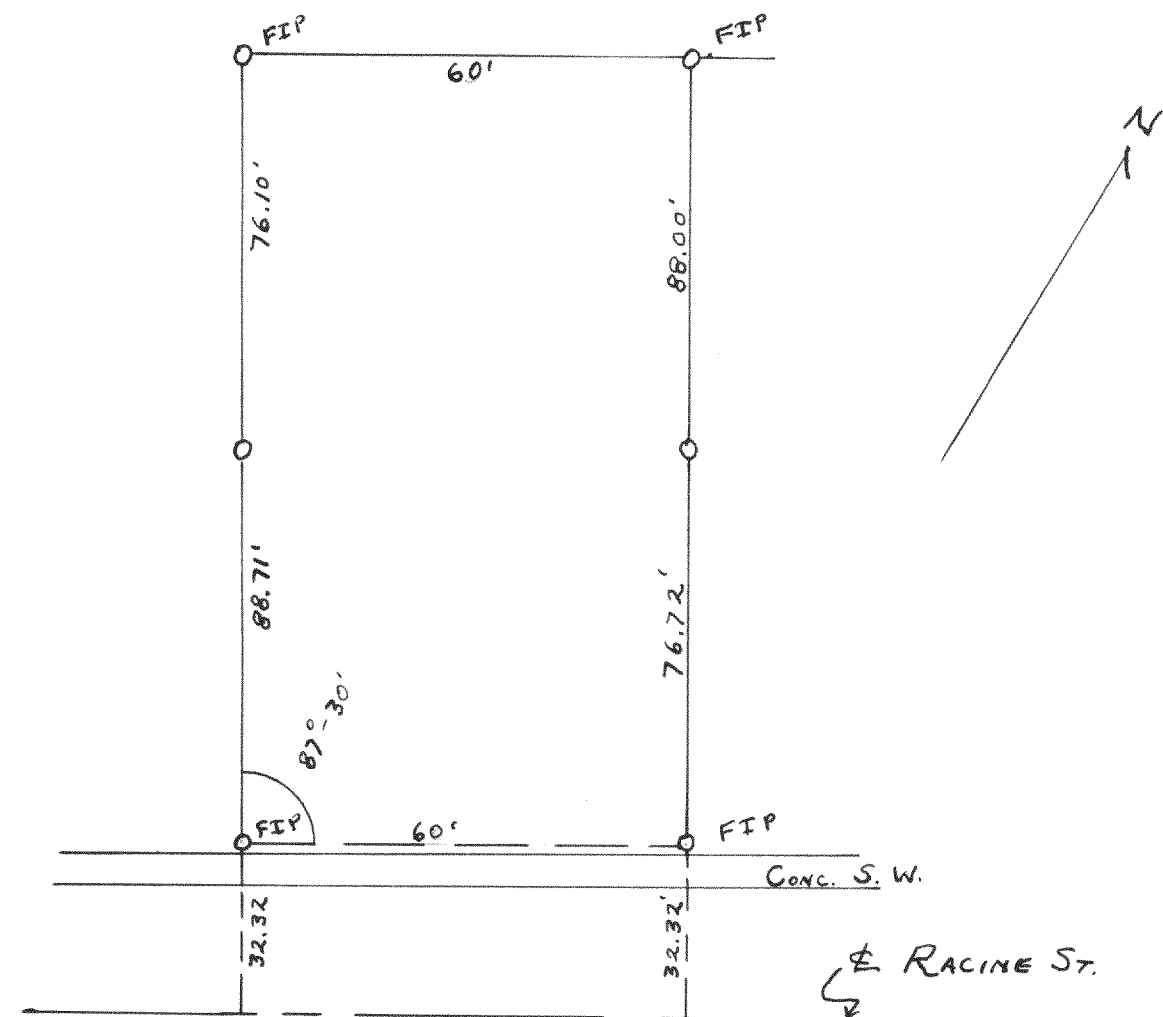

2658

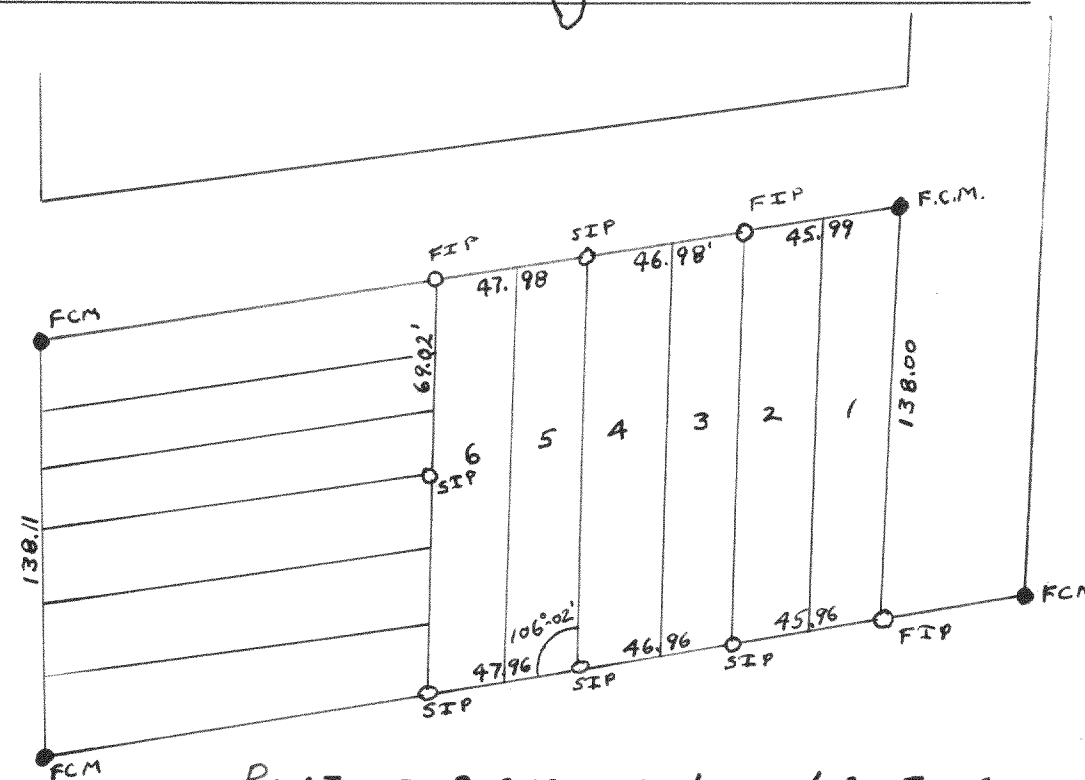

2657

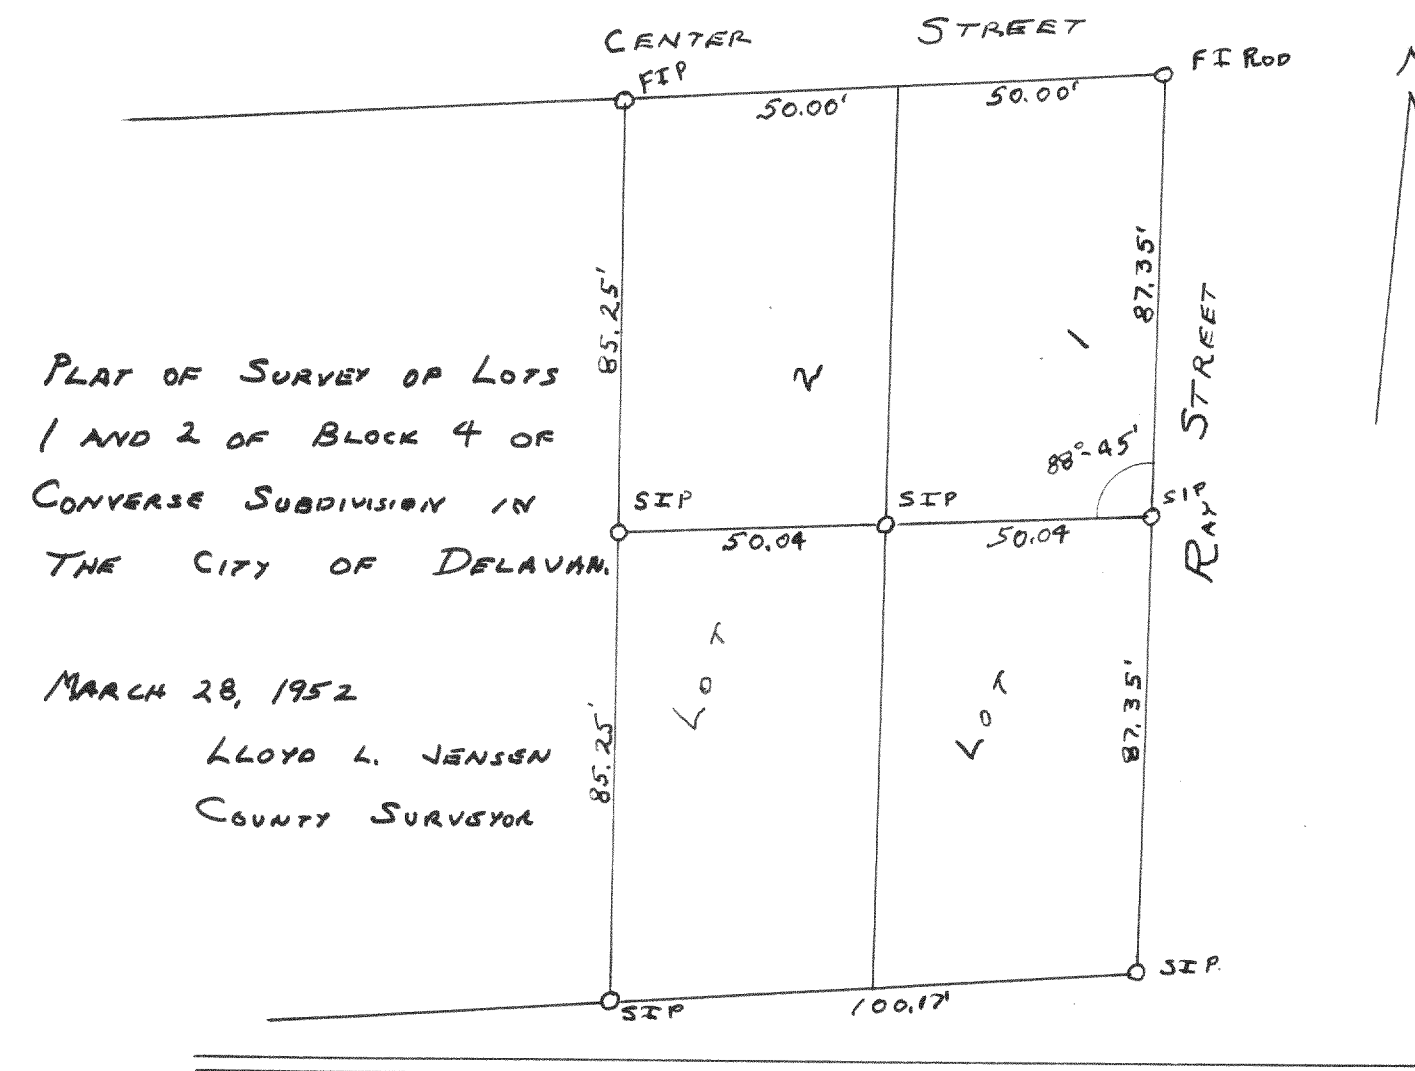

2659

