


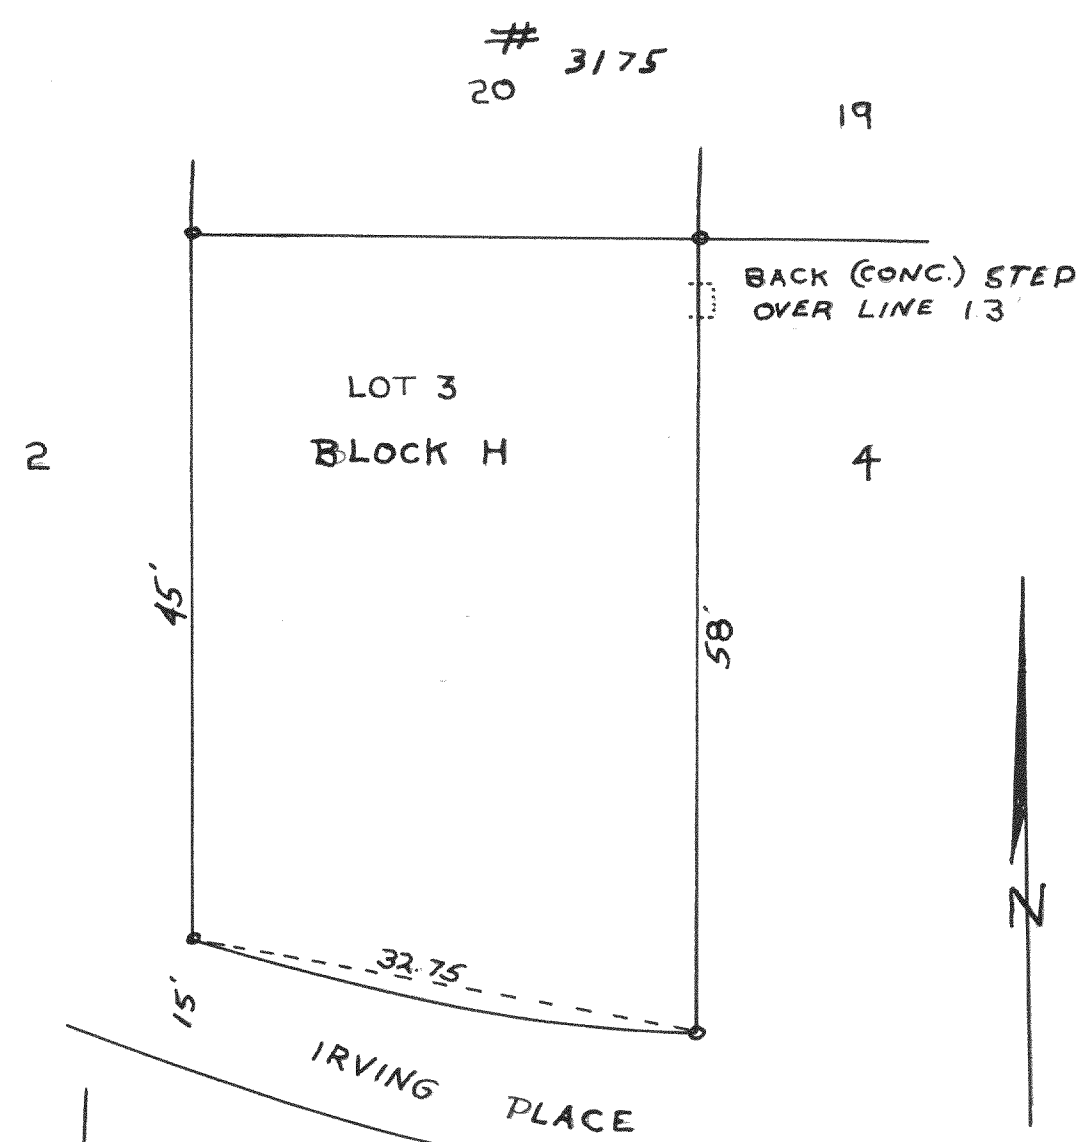

PLAT OF SURVEY OF LOT 3 OF
BLOCK H. OF DELAVAN LAKE ASSEMBLY
GROUNDS LOCATED IN T2N R16E
WALWORTH COUNTY, WISCONSIN
LLOYD L. JENSEN
COUNTY SURVEYOR
MAY 1956

