



3187

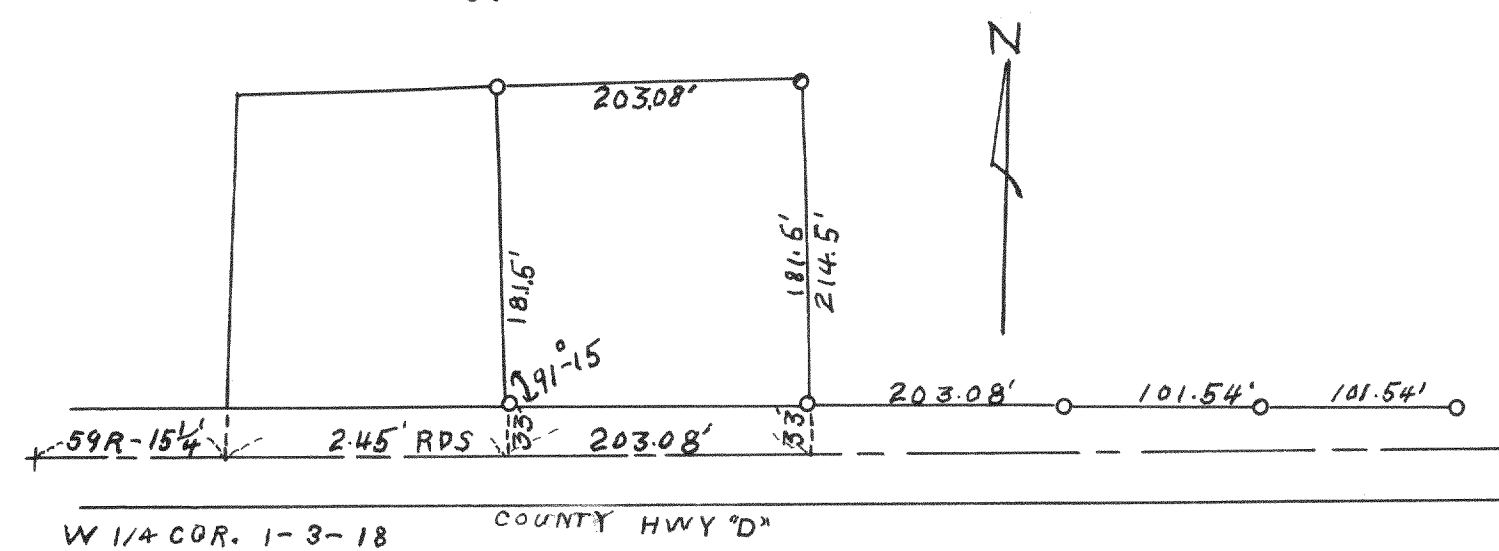


PLAT OF SURVEY OF LAND IN
NW 1/4 SECTION 1 T3N R18E
WALWORTH COUNTY WISCONSIN
NOV. 1956 LLOYD L. JENSEN
SURVEYOR

3196

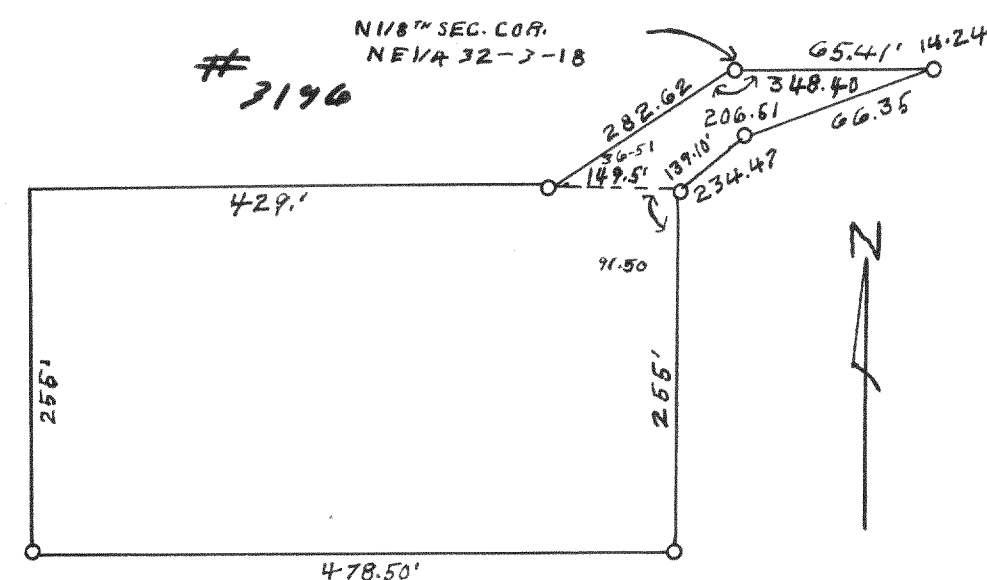


PLAT OF SURVEY OF LAND IN
NE 1/4 SECTION 32 T3N R18E
WALWORTH COUNTY WISCONSIN
MAR 1955 LLOYD L. JENSEN
SURVEYOR

3193

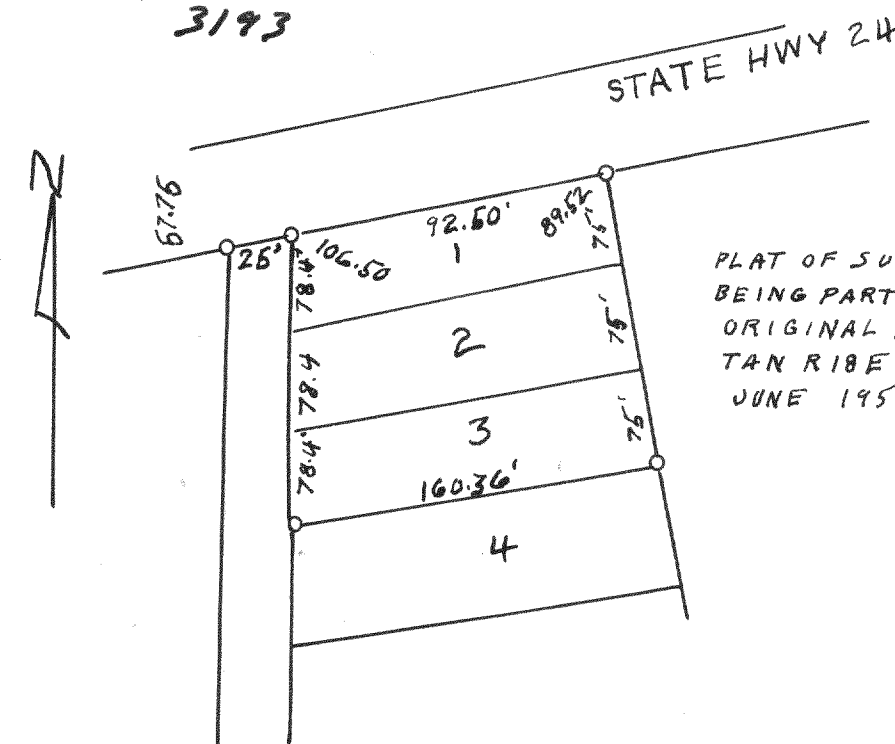


PLAT OF SURVEY OF LOTS 1-3 HUNTERS BLOCK
BEING PART OF LOTS 1-2 OF BLOCK 2 OF
ORIGINAL PLAT OF BEULAH LAKE
TAN RIBE WALWORTH COUNTY WISCONSIN
JUNE 1956 LLOYD L. JENSEN
SURVEYOR

3188

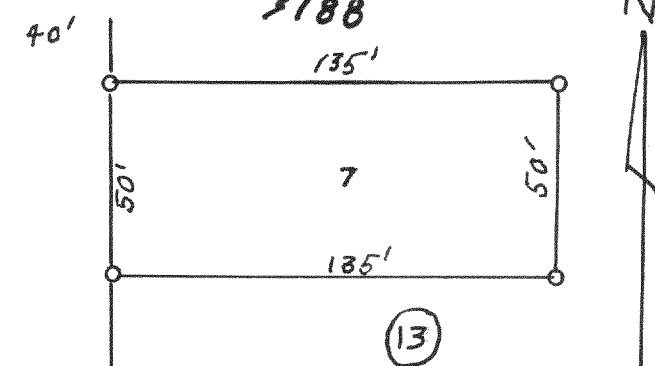


PLAT OF SURVEY OF LOT 7 BLOCK 13
OF MIRAMAR T4N R18E
WALWORTH COUNTY WISCONSIN
MAR. 1955 LLOYD L. JENSEN
SURVEYOR

3191

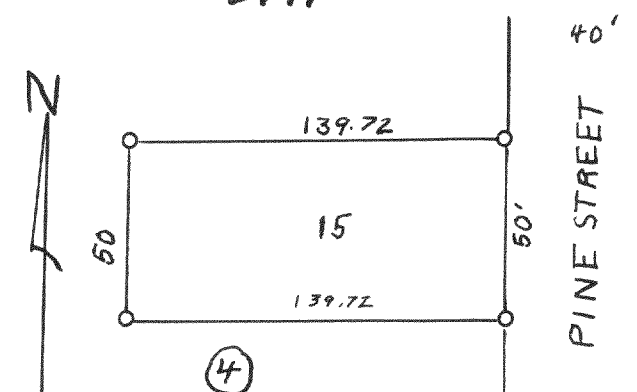

PLAT OF SURVEY OF LOTS 15
BLOCK 4 MIRAMAR T4N R18E
WALWORTH COUNTY WISCONSIN
JUNE 1955 LLOYD L. JENSEN
SURVEYOR


3194

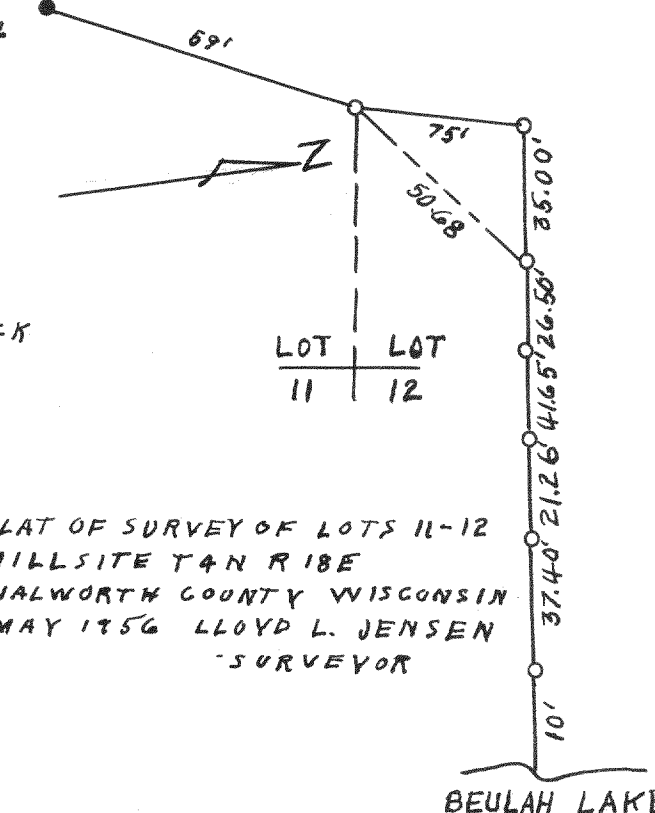

PLAT OF SURVEY OF LOTS 11-12
MILLSITE T4N R18E
WALWORTH COUNTY WISCONSIN
MAY 1956 LLOYD L. JENSEN
SURVEYOR


3189

PLAT OF SURVEY OF LAND IN
NE 1/4 SECTION 3, T4N R18E
WALWORTH COUNTY WISCONSIN
JULY 1956 LLOYD L. JENSEN
SURVEYOR

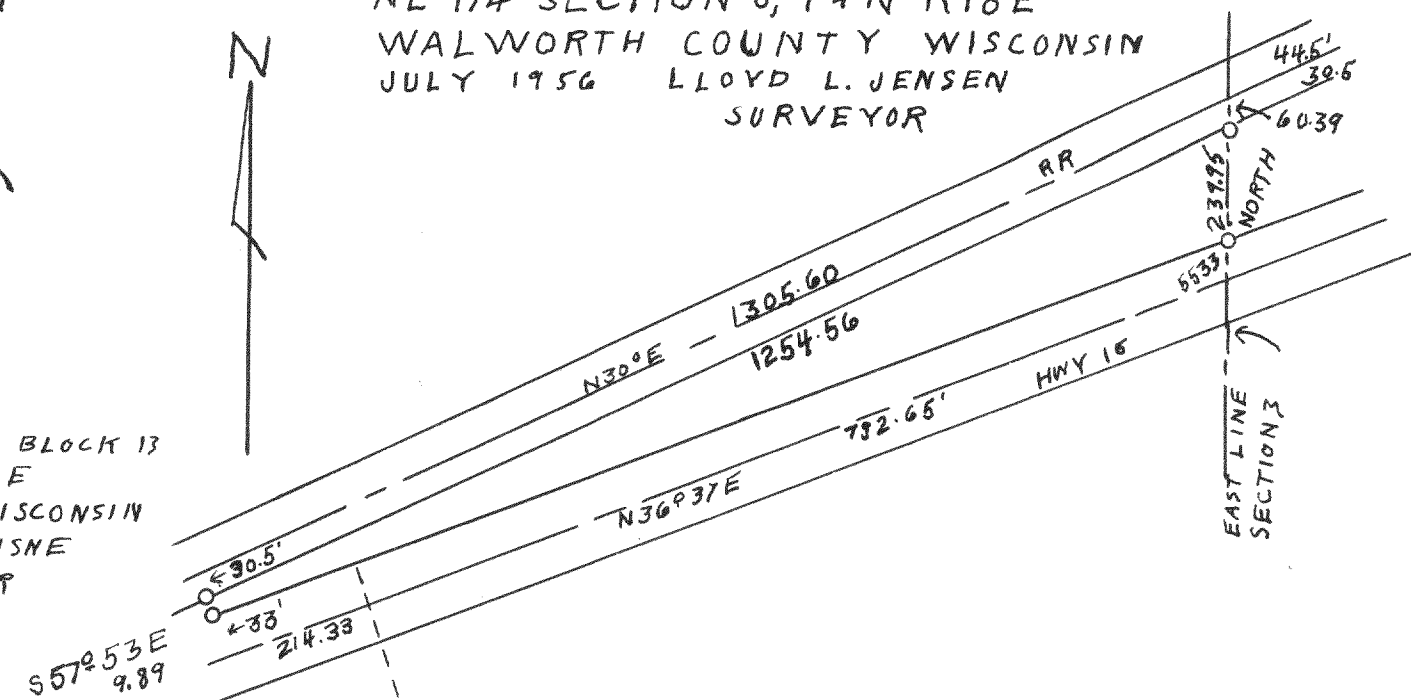

PG OF CURVE

3192

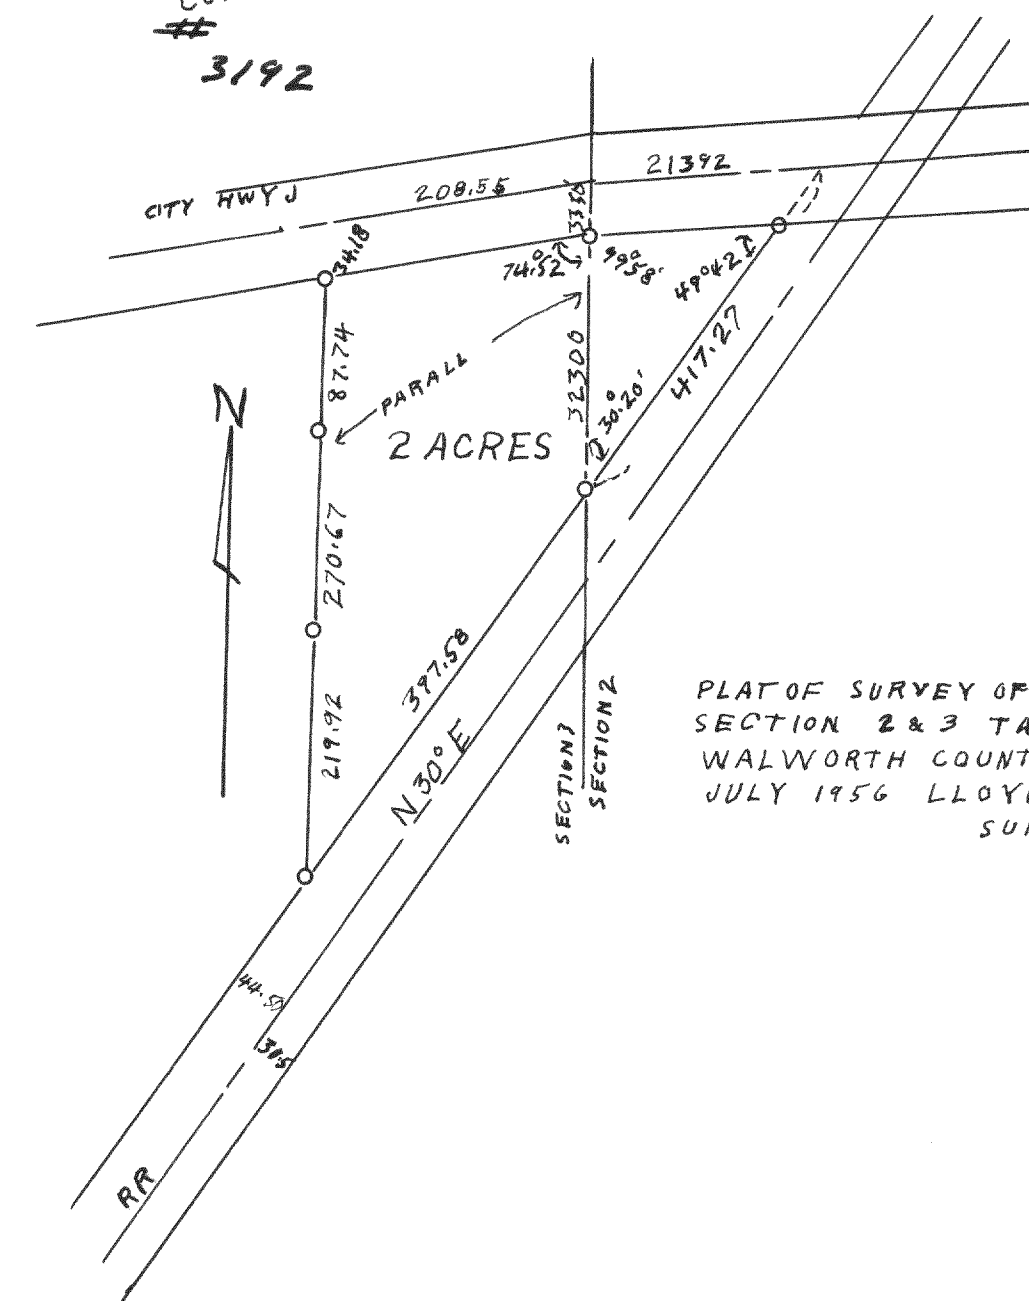

PLAT OF SURVEY OF LAND IN
SECTION 2 & 3 T4N R18E
WALWORTH COUNTY WISCONSIN
JULY 1956 LLOYD L. JENSEN
SURVEYOR