




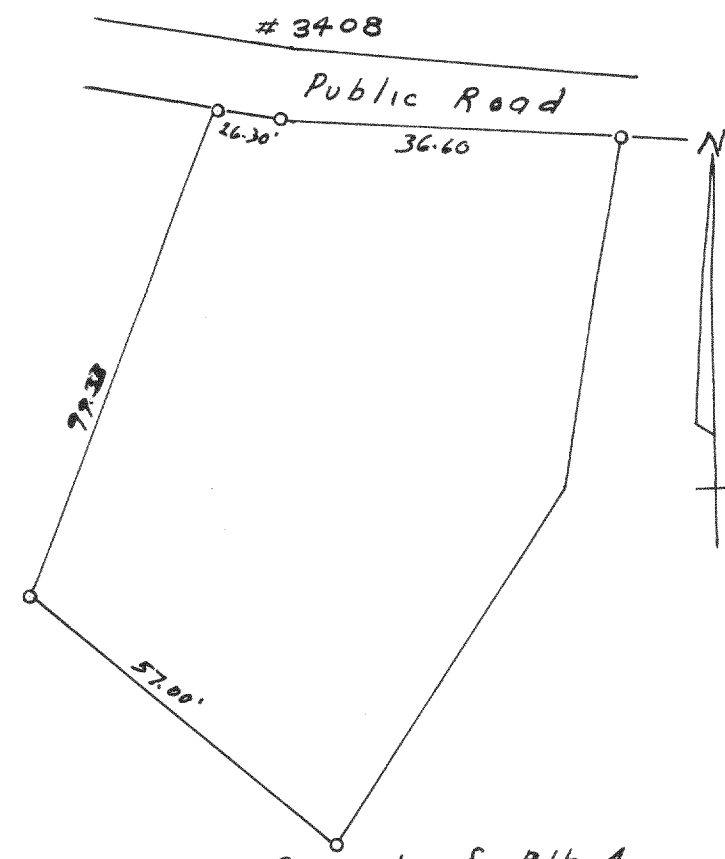


Survey of part of Blk 4
Green Lake Park
3408

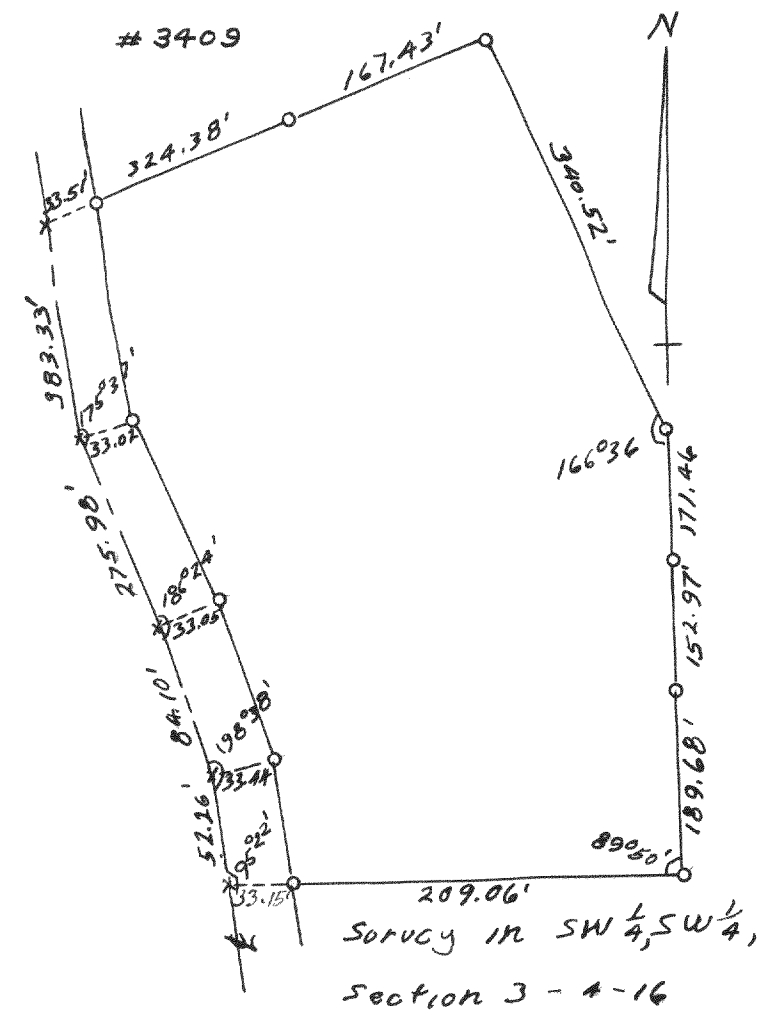


Survey in SW $\frac{1}{4}$, SW $\frac{1}{4}$,
Section 3 - 4 - 16
3409

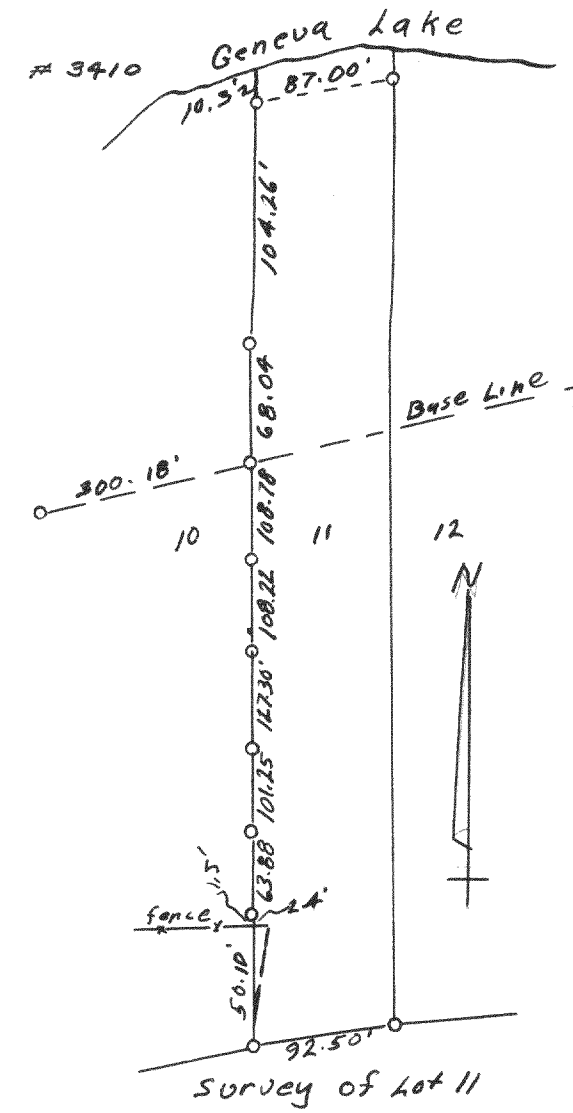


Survey of Lot 11
The Birches
3410

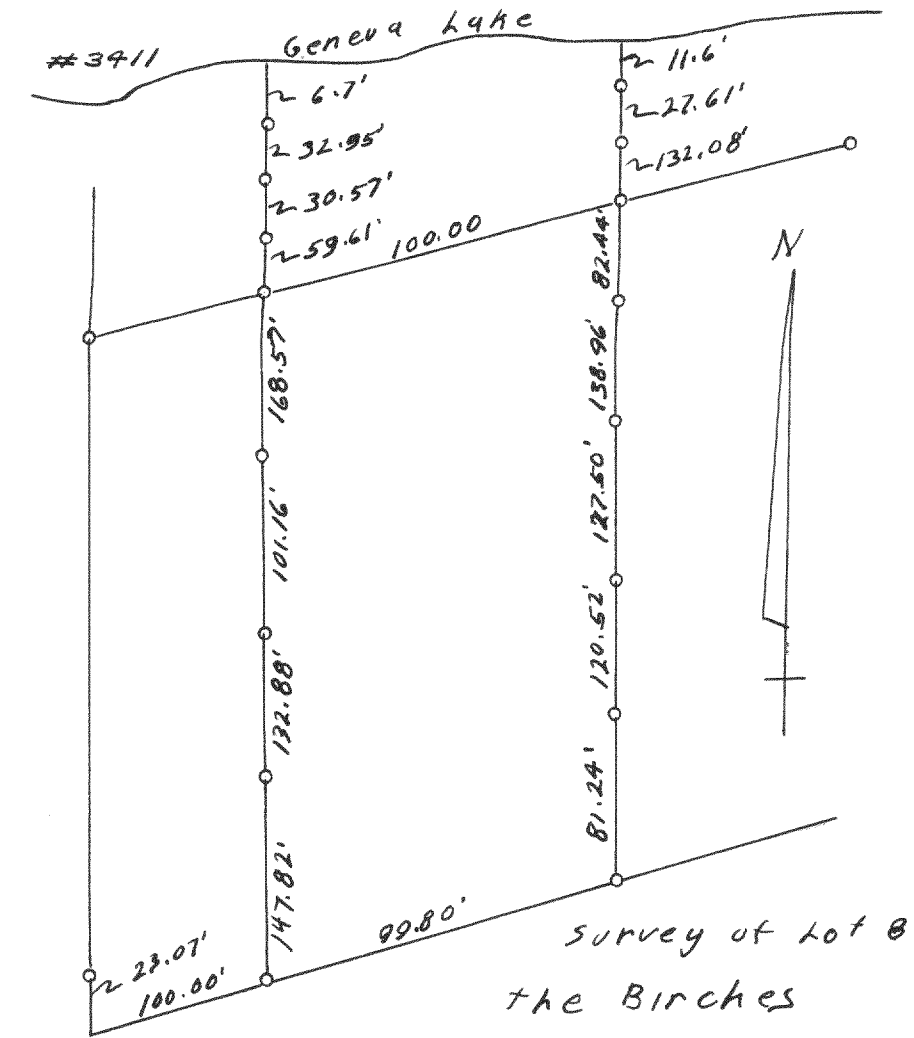


Survey of Lot 8
the Birches
3411

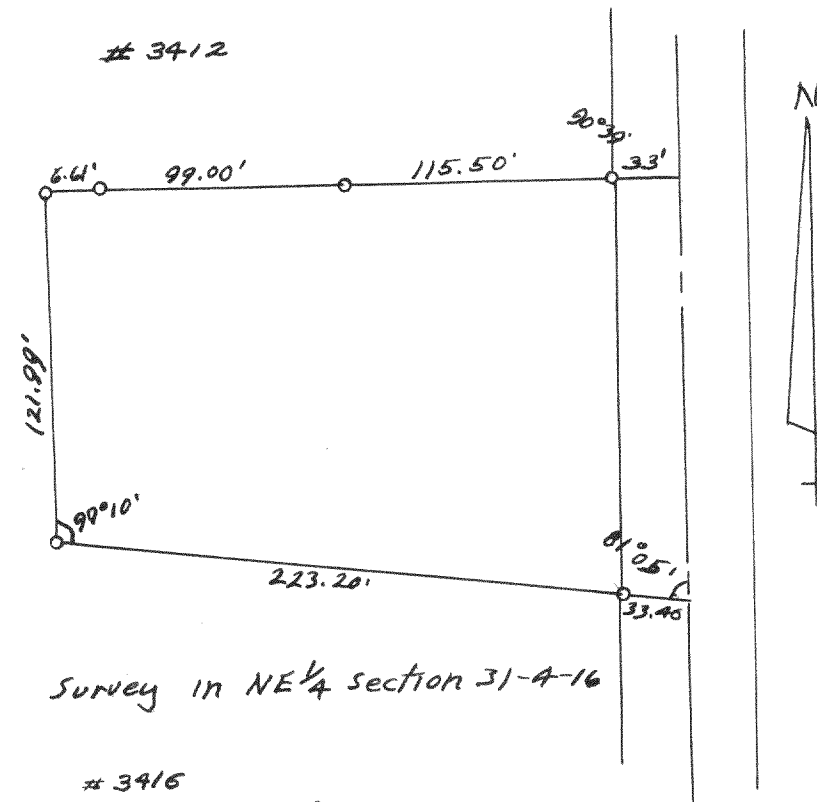


Survey in NE $\frac{1}{4}$ section 31-4-16
3412

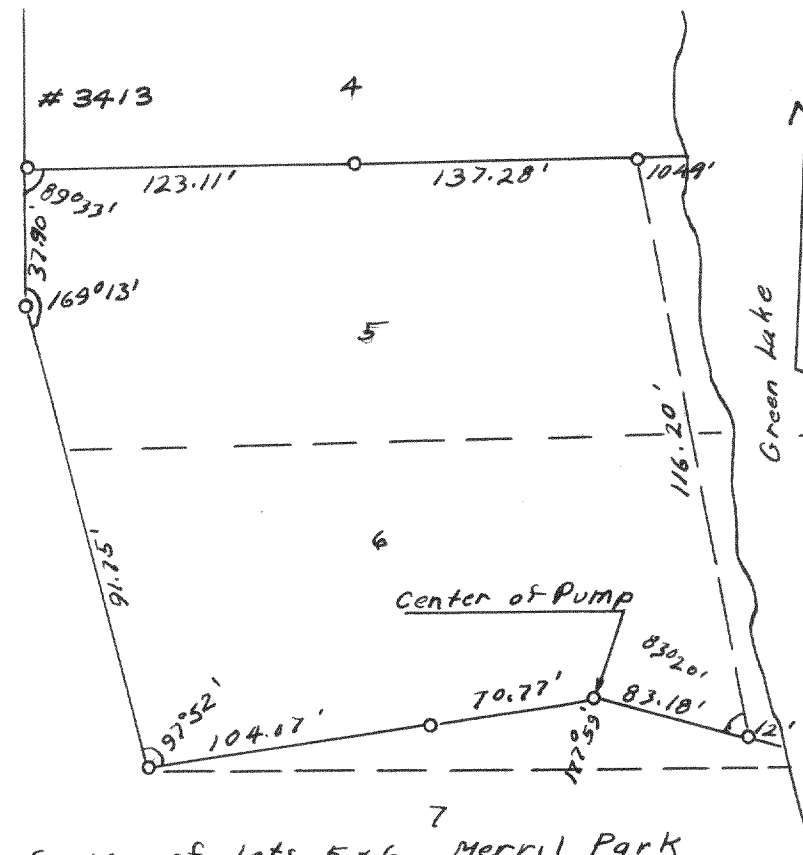


Survey of Lots 5 & 6 Merrill Park
SW $\frac{1}{4}$ Section 26 - 4 - 16
3413

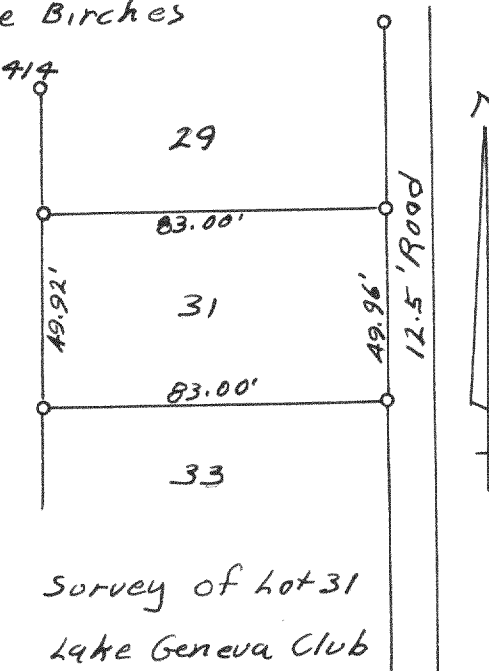


Survey of Lot 31
Lake Geneva Club
3414

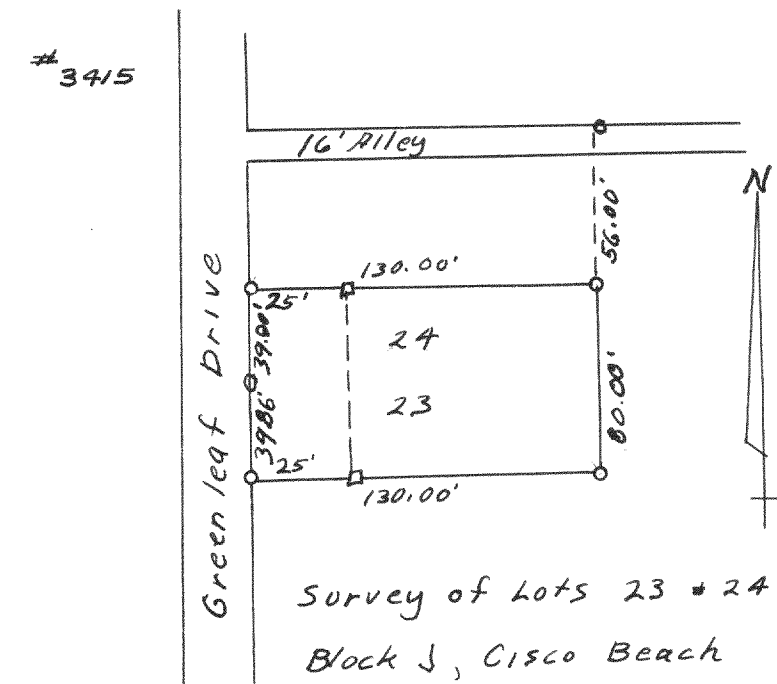


Survey of Lots 23 & 24
Block J, Cisco Beach
3415

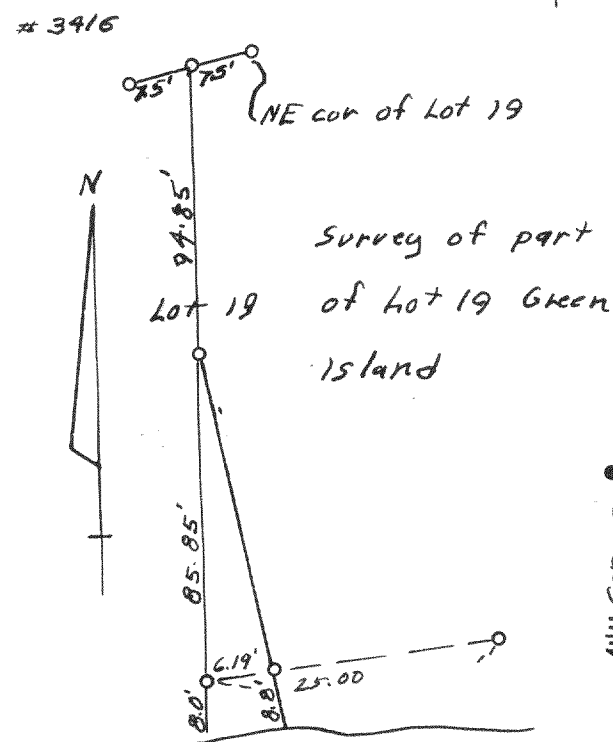


Survey of part
of Lot 19 Green
Island
3416

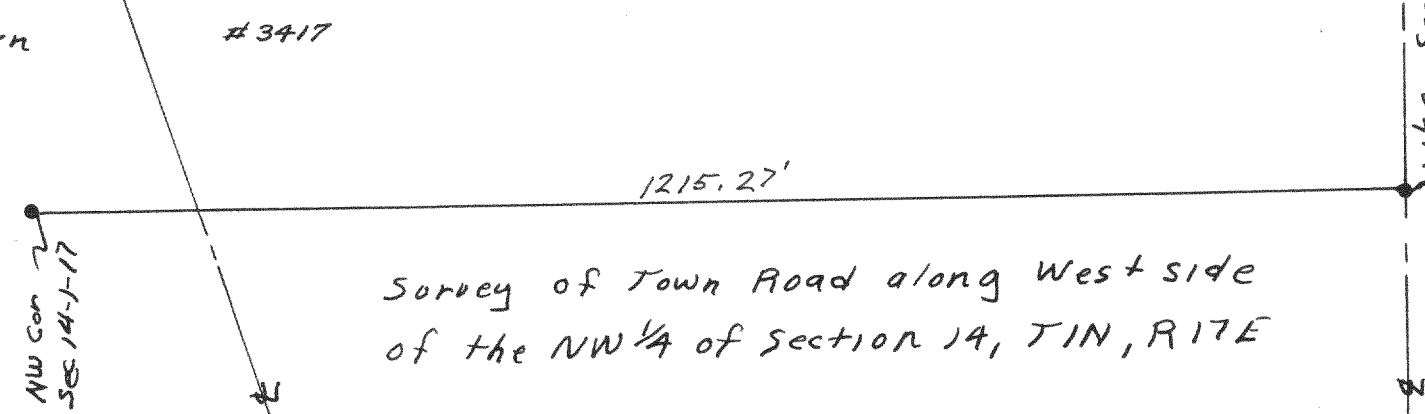

Survey of Town Road along West side
of the NW $\frac{1}{4}$ of Section 14, T1N, R17E
3417

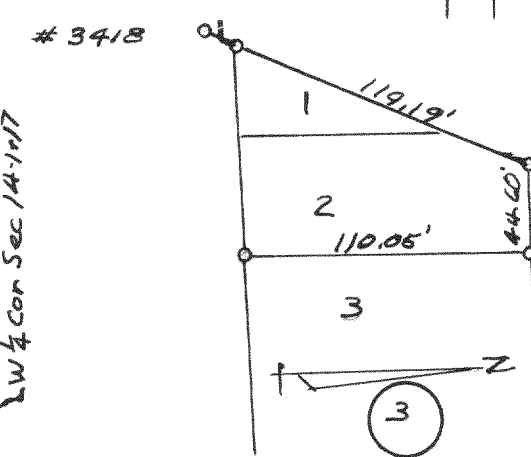

Survey of Lots 1 & 2
Block 3 Sunset Hills
Subdivision
3418

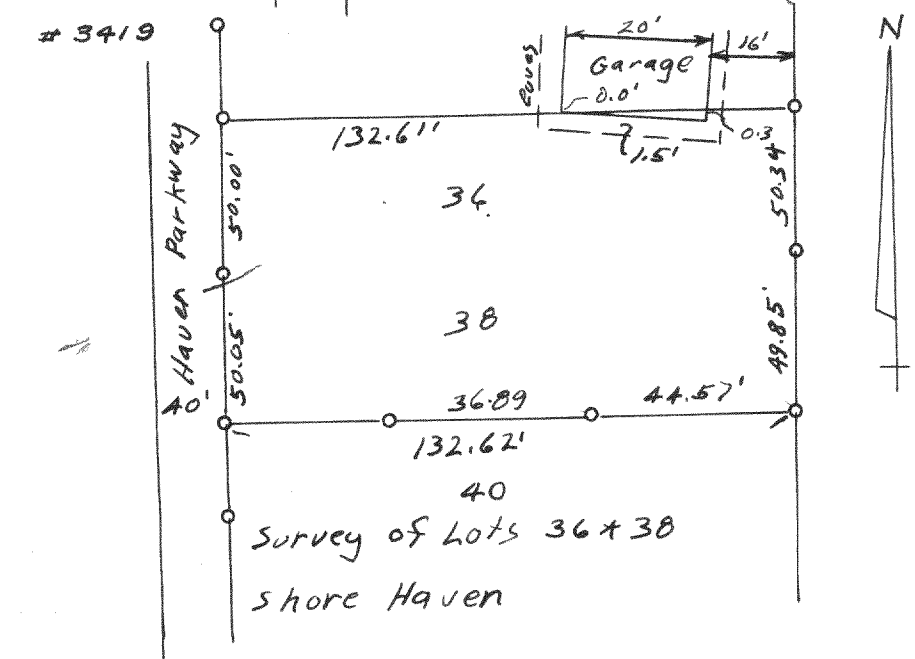

Survey of Lots 36 & 38
Shore Haven
3419