



2675

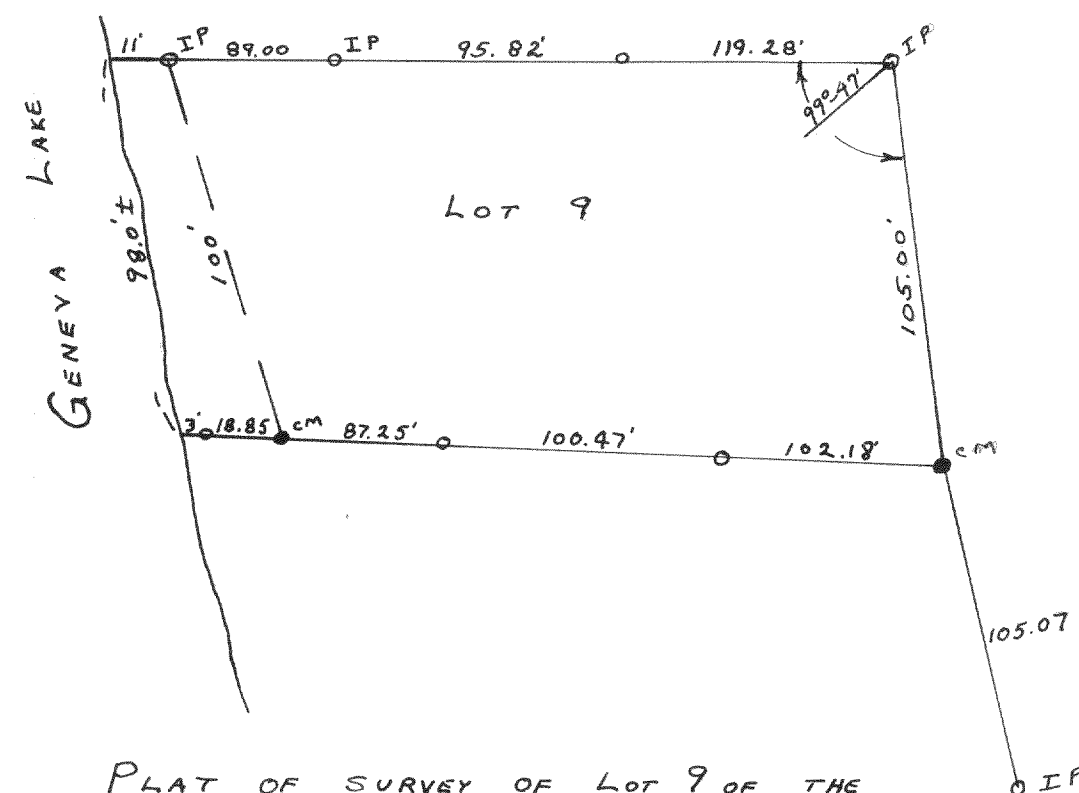

PLAT OF SURVEY OF LOT 9 OF THE
UNRECORDED PLAT OF THE BERCHES
SUBDIVISION IN SECTION 9 T1N, R17E
MARCH 27, 1952
Lloyd L Jensen SA
COUNTY SURVEYOR


2677

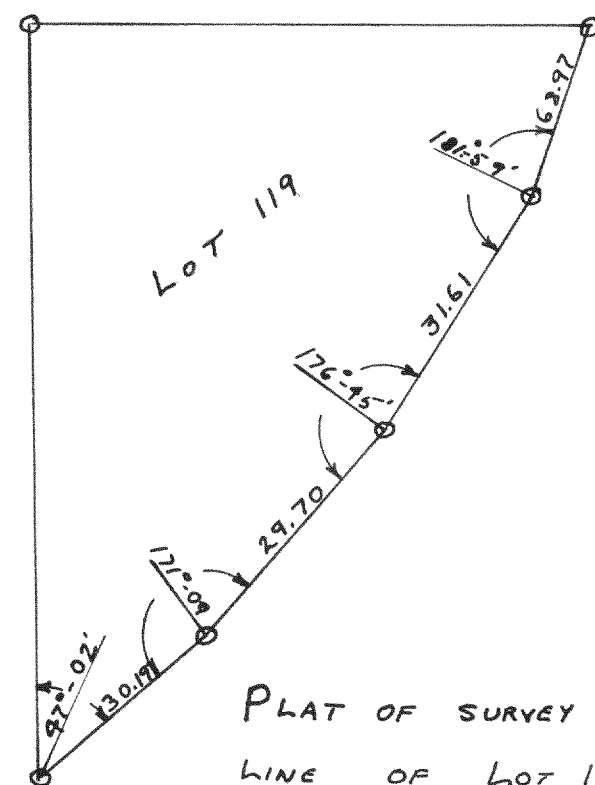

PLAT OF SURVEY OF FRONT OR ROAD
LINE OF LOT 119 OF LAKE GENEVA
BEACH SUBD.
1952

Lloyd L Jensen SA
COUNTY SURVEYOR

2676

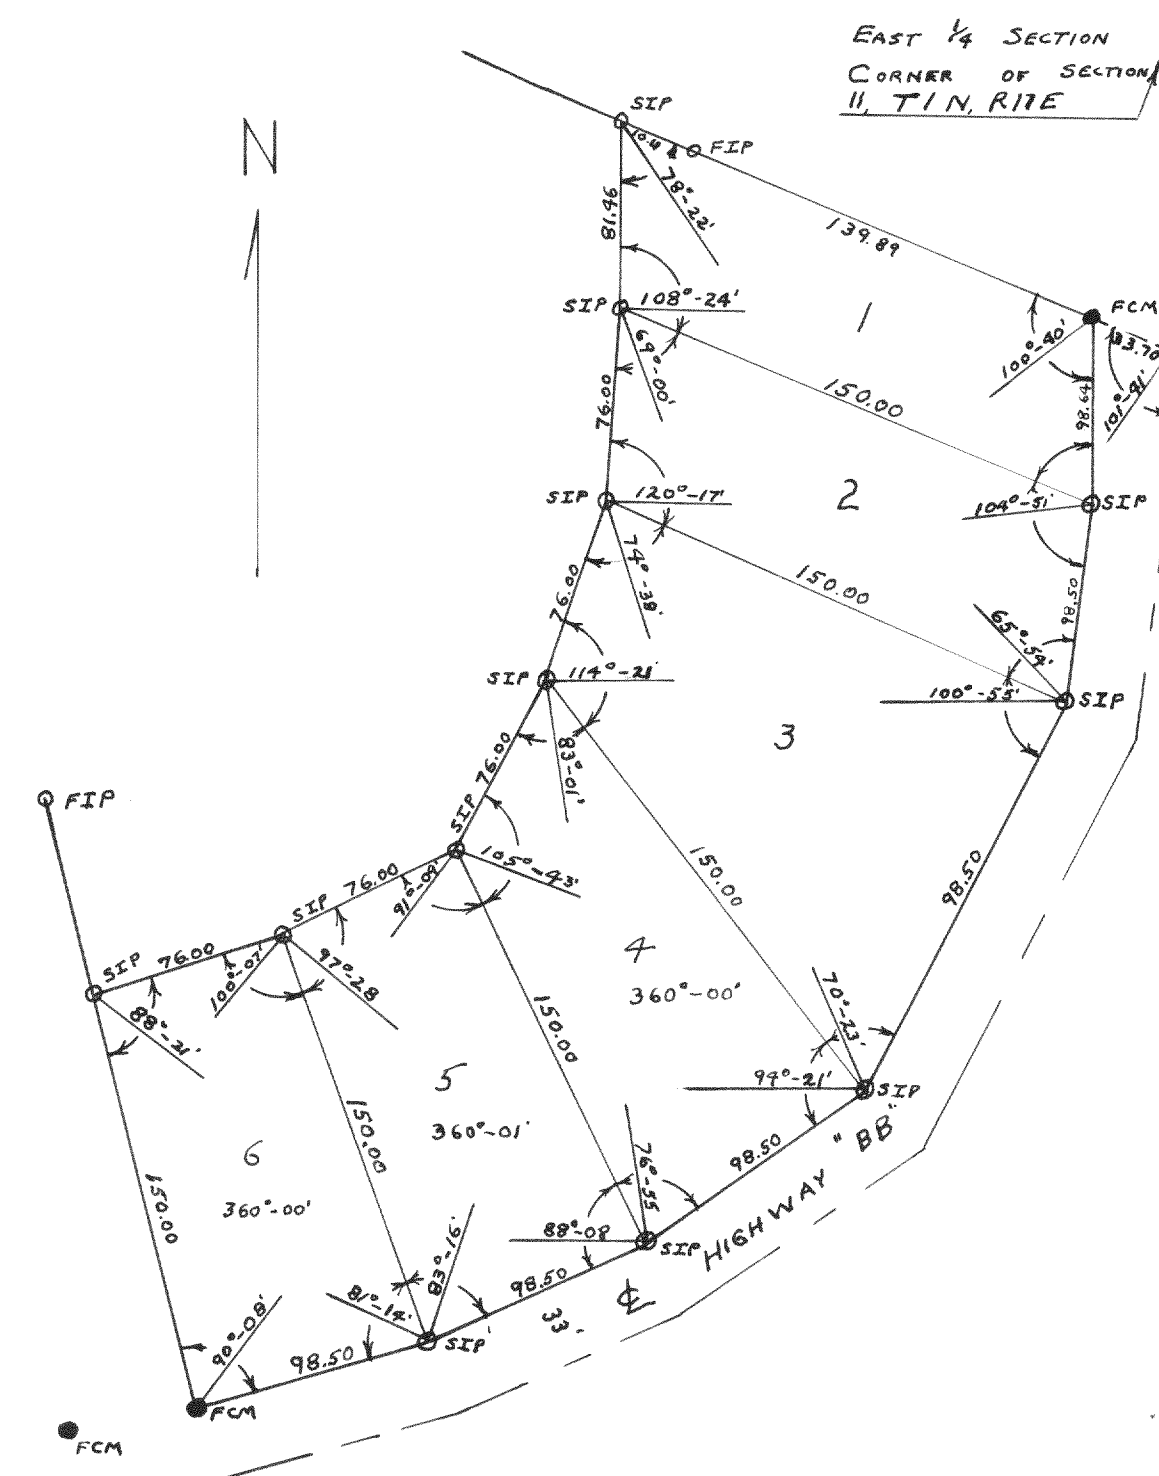

PLAT OF SURVEY OF LAND LOCATED
IN THE SOUTHEAST $\frac{1}{4}$ OF SECTION 11,
T1N, R17E WALWORTH COUNTY WISCONSIN.

APRIL 1, 1952

Lloyd L Jensen SA
COUNTY SURVEYOR