




Plot of Survey of a parcel of land
located in the NW 1/4 of SECTION 13
T1N, R1E, Village of Fontana,
Walworth County, Wisconsin.


Lloyd L. Jensen
County Surveyor

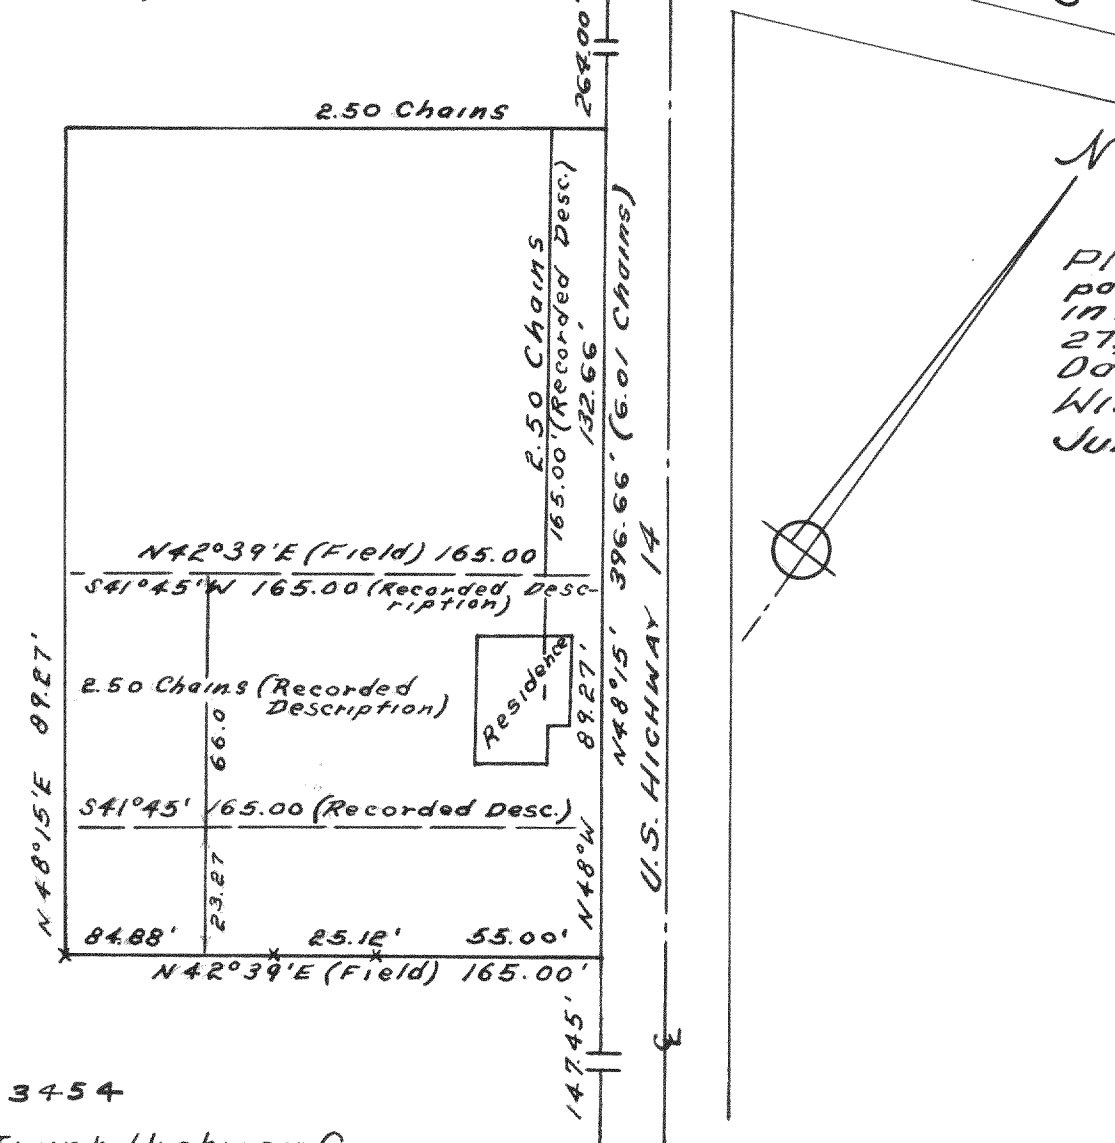

Plot of Survey of a
parcel of land located
in the SW 1/4 of Section
27, T2N, R15E, Village of
Darien, Walworth County,
Wisconsin

July 1957 Lloyd L. Jensen

County Surveyor

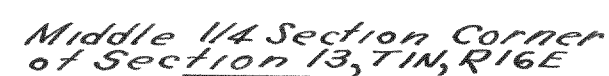

South Shore
Drive

3454

County Trunk Highway C-


NW Corner of the E 1/2 of the E 1/2
of the SW 1/4 of Sec. 20, T4N, R18E

Plot of Survey of Part of
Outlot 109 Village at Walworth,
in the NW 1/4 of Section 22, T1N,
R16E, Walworth County, Wisc-
consin and described as follows,
to wit: Commencing at the W-
1/4 Section corner at said Sec-
tion 22; thence N 99 feet; thence
S 89° 24' E, 33.00 feet to the place
of beginning, thence continue
S 89° 24' E, 66.00 feet along the N
line at said outlot; thence S 19.32
feet; thence N 89° 58' W, 66.00 feet
thence N 19.96 feet to the place at
beginning.

February 1958

Lloyd L. Jensen
County Surveyor

X Cross Cut in Concrete
O Iron pipe

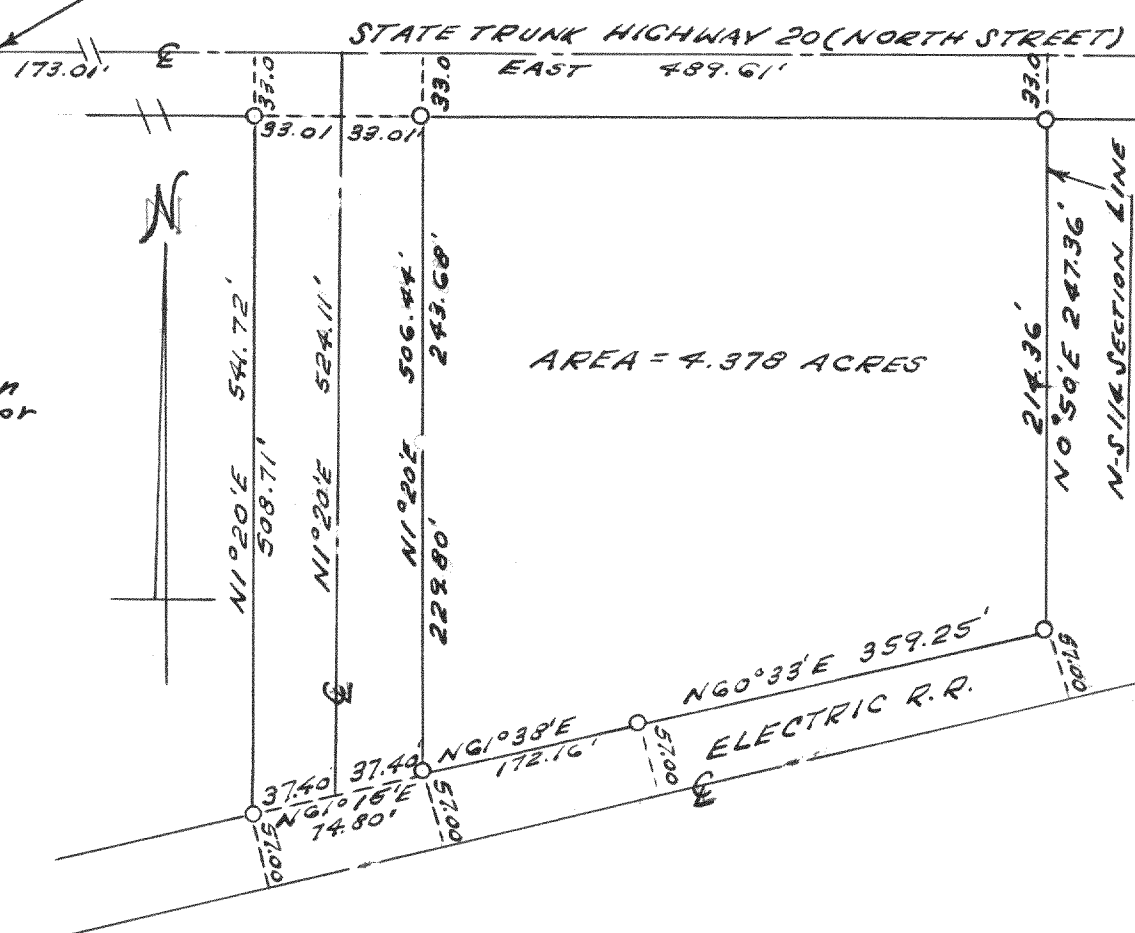

Plat of Survey
of Parcel of land
located in NE 1/4
of the NE 1/4 of the
SW 1/4 of Section 20,
T4N, R18E Village of
East Troy, Walworth
County, Wisconsin
December 1957

Lloyd L. Jensen
Surveyor