



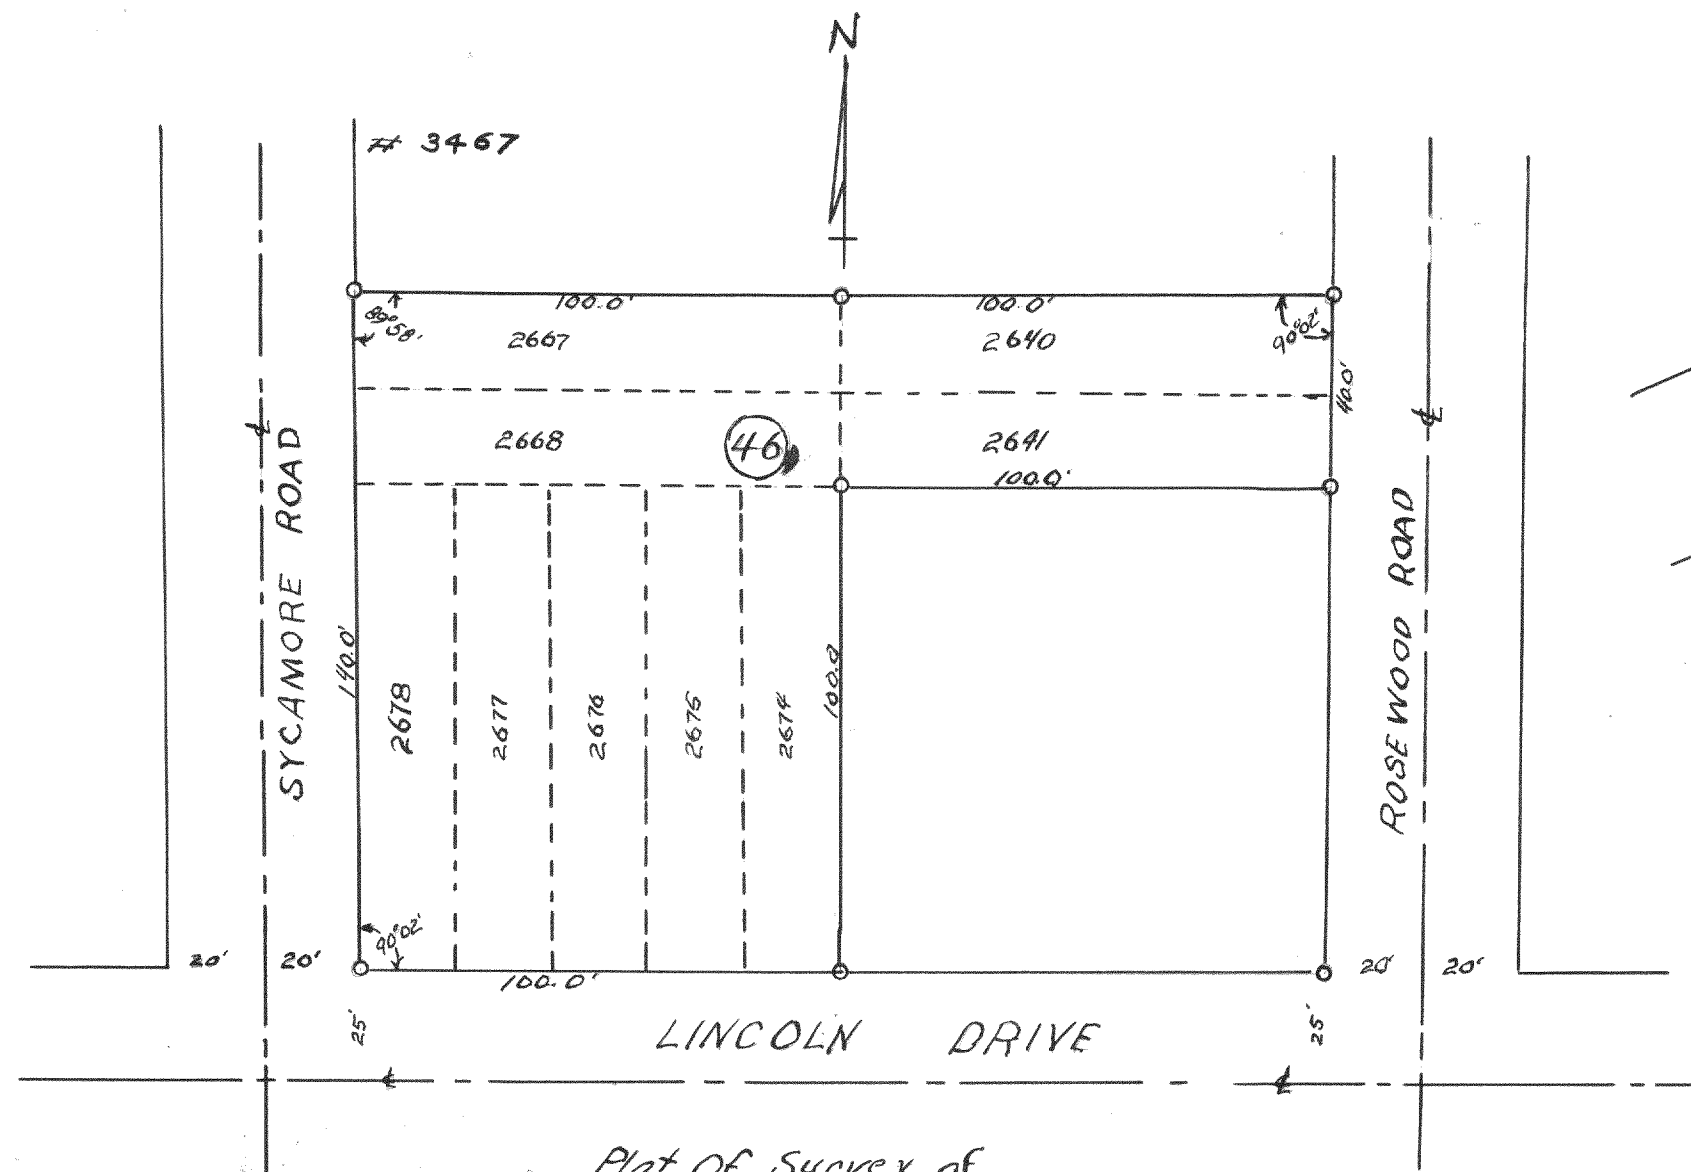


Plat of Survey of
Lots 2640, 2641, 2667, 2668,
2674-2678, Lake Como Beach,
T4N, R1E, Walworth County,
Wisconsin
October 30, 1957
Lloyd L. Jensen
County Surveyor

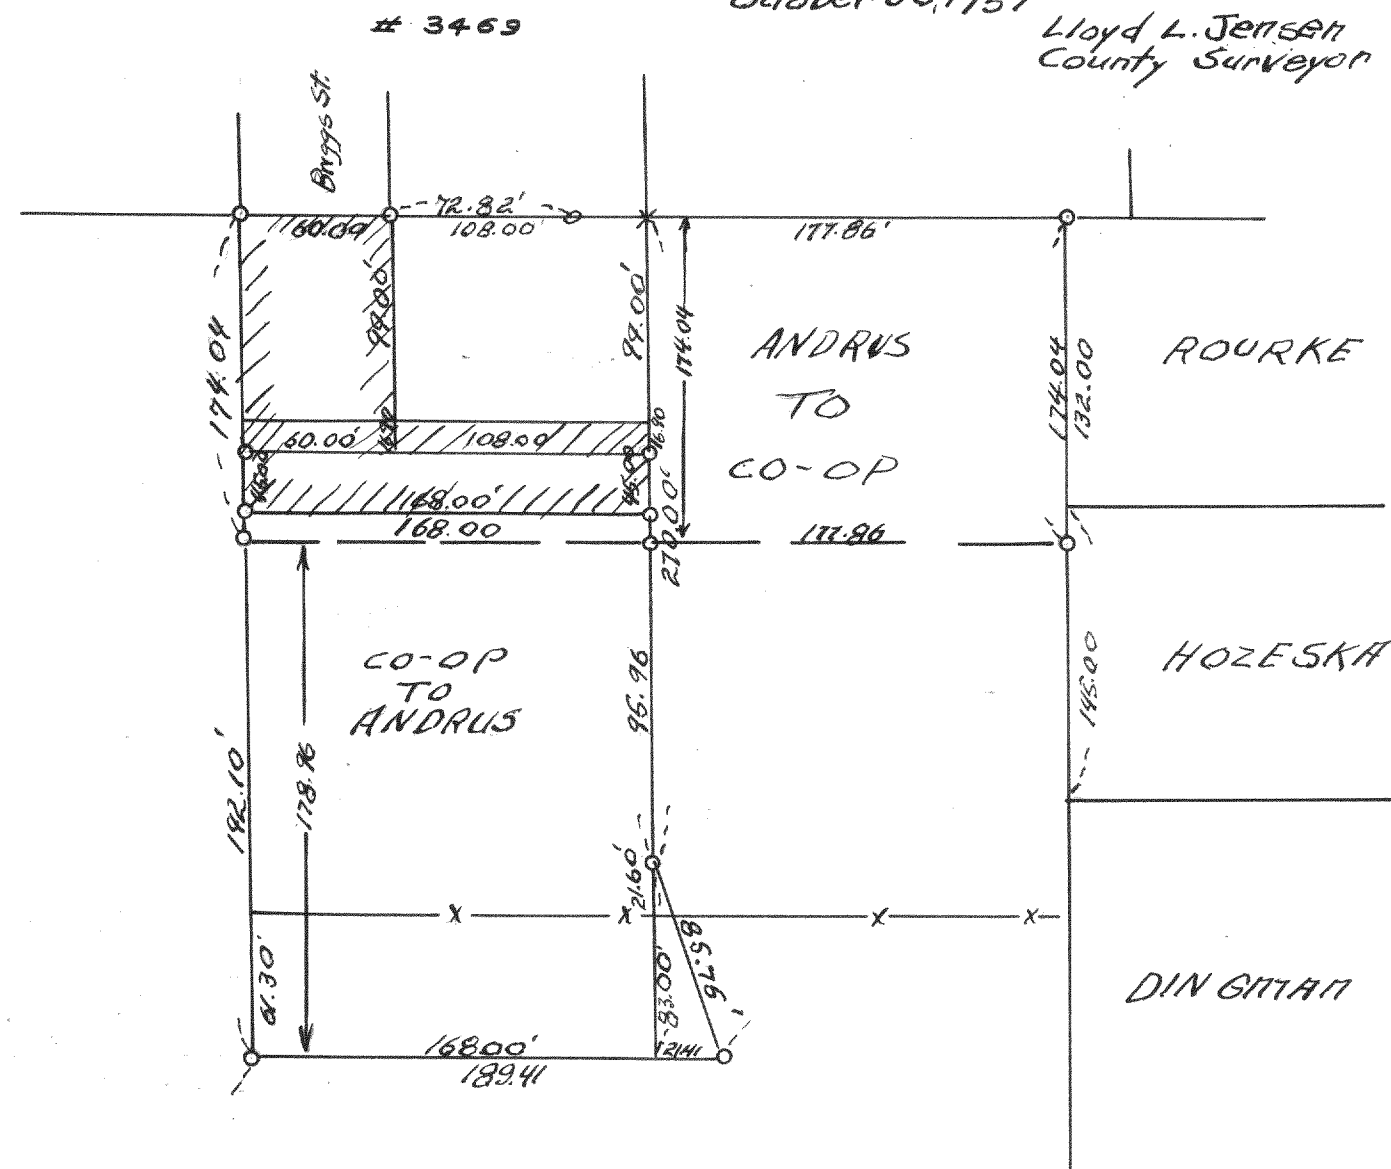

X CROSS CUT IN CONCRETE
O IRON PIPE

Plat of Survey of Parcel
of land located SE 1/4 of
Section 15, T4N, R1E,
Walworth County,
Wisconsin
Dec. 1957

Lloyd L. Jensen
County Surveyor

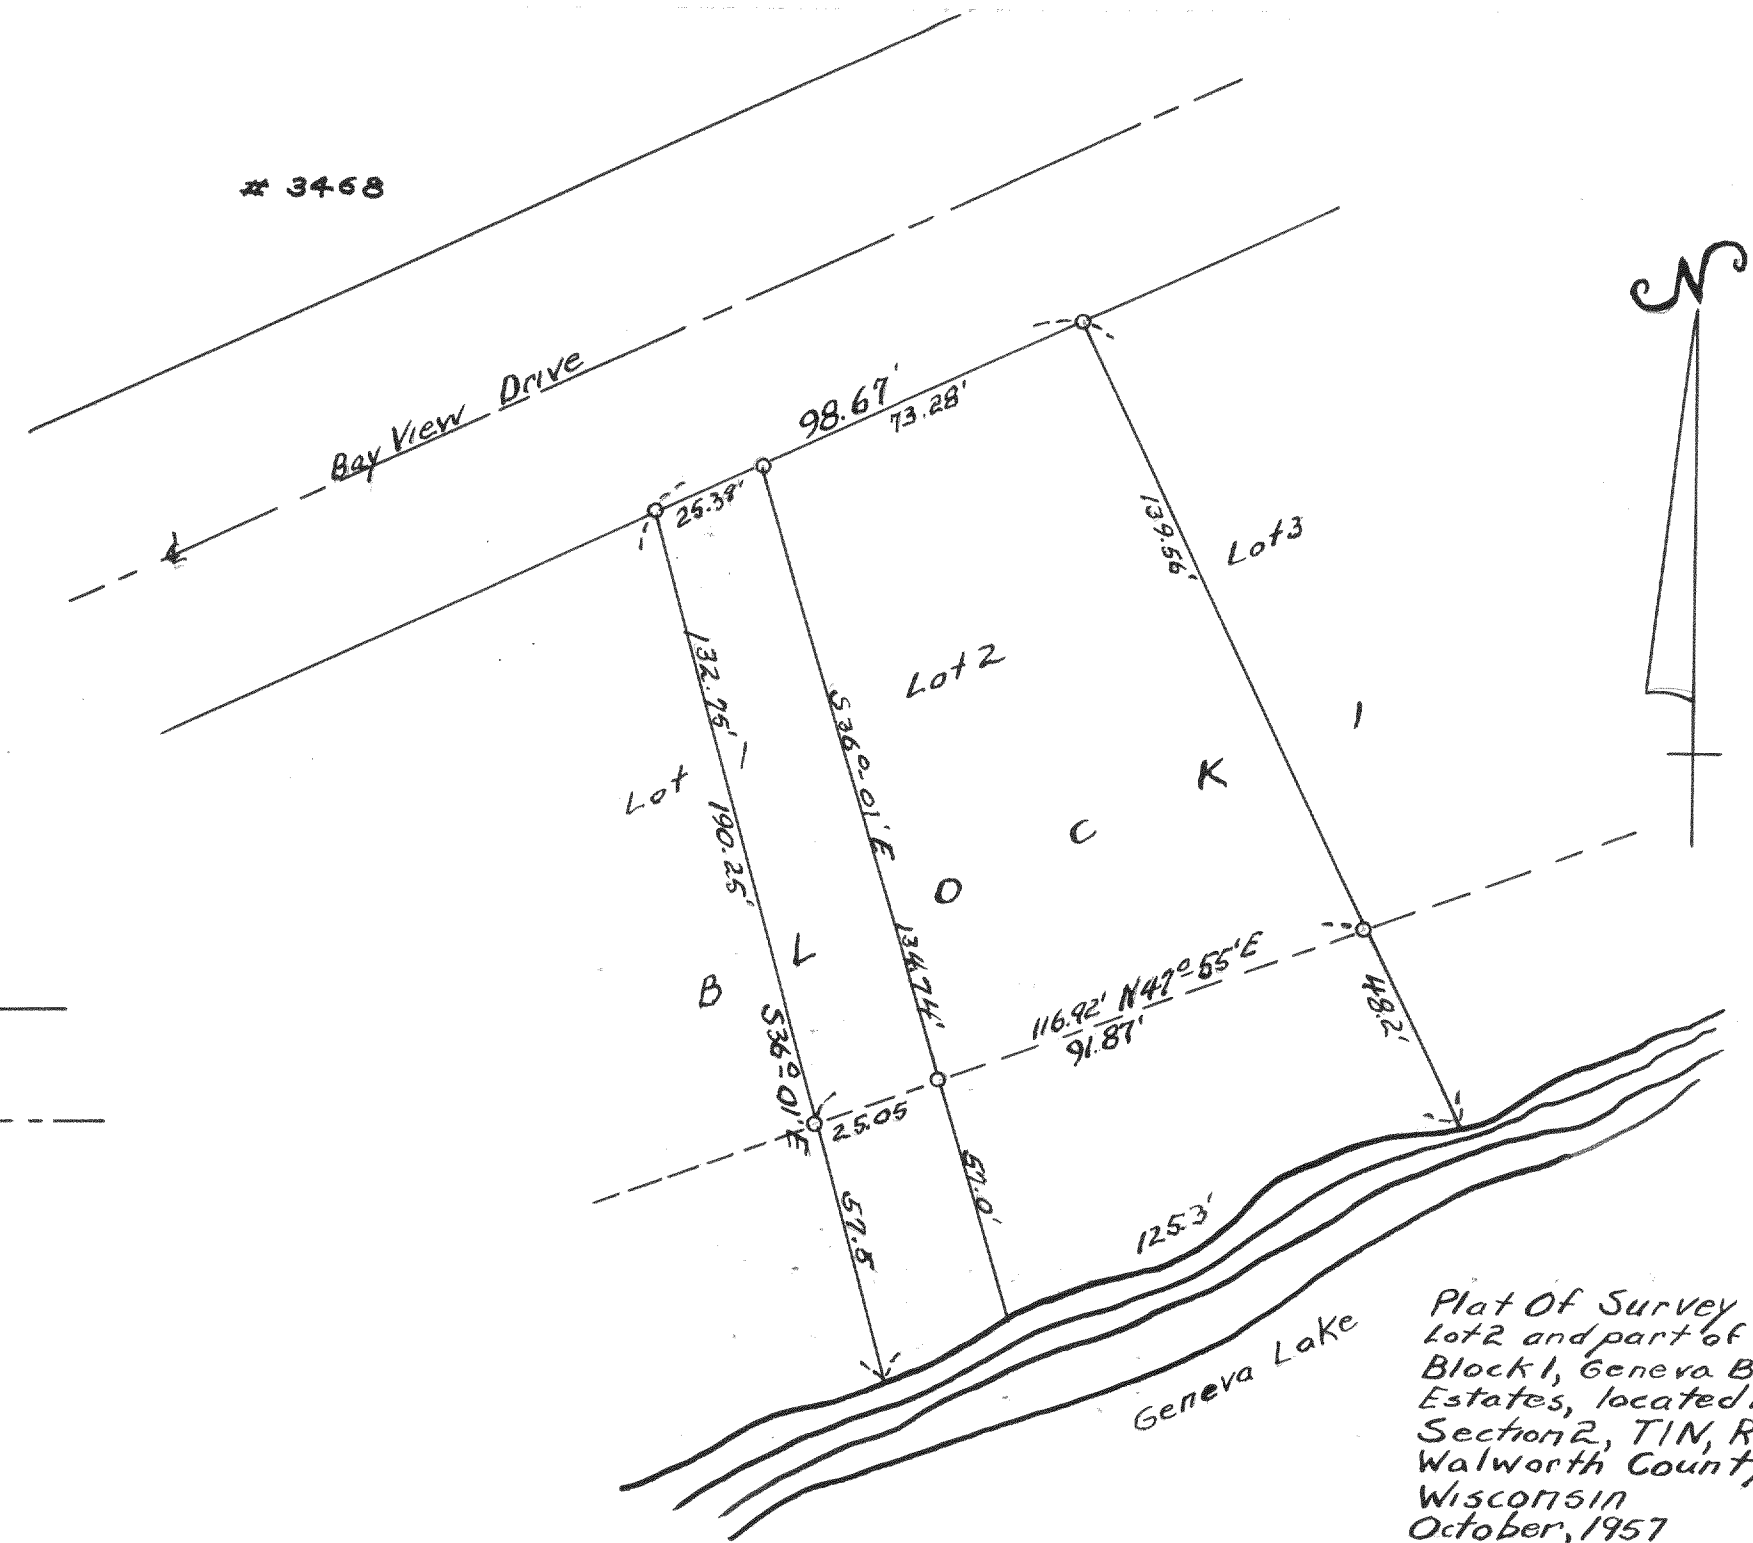

Plat of Survey of
Lot 2 and part of Lot 1,
Block 1, Geneva Bay
Estates, located in
Section 2, T1N, R1E,
Walworth County,
Wisconsin
October, 1957

Lloyd L. Jensen
County Surveyor