



3473

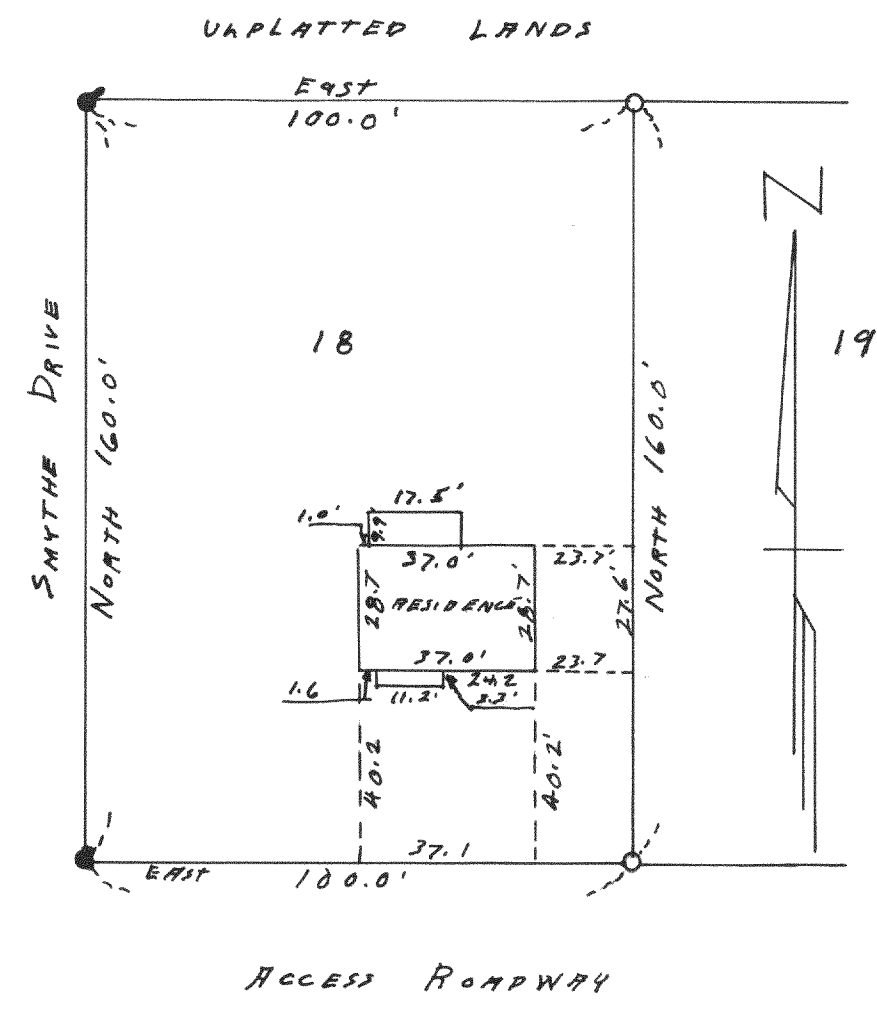


PLAT OF SURVEY OF LOT
18, BAYWOOD HEIGHTS SUBD.
LOCATED IN THE NW 1/4 OF
SEC. 1, T1N, R1E, VILLAGE OF
WILLIAMS BAY WALWORTH
COUNTY, WISCONSIN MAR 1958
LLOYD L. JENSEN
COUNTY SURVEYOR

3474

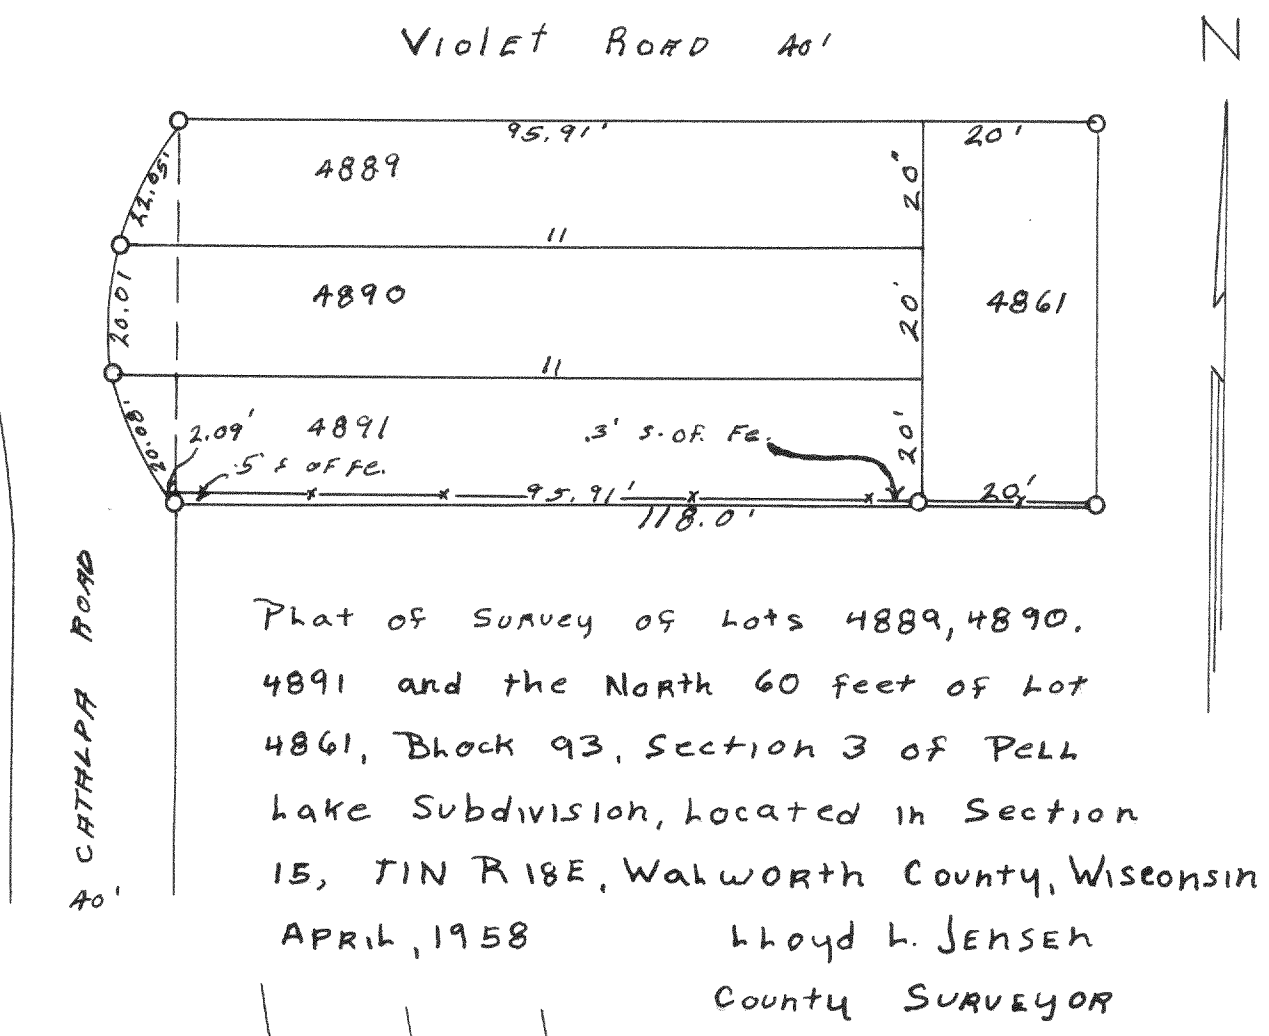


Plat of Survey of Lots 4889, 4890,
4891 and the North 60 feet of Lot
4861, Block 93, Section 3 of Pell
Lake Subdivision, located in Section
15, T1N R1E, Walworth County, Wisconsin
APRIL, 1958
LLOYD L. JENSEN
COUNTY SURVEYOR

3475

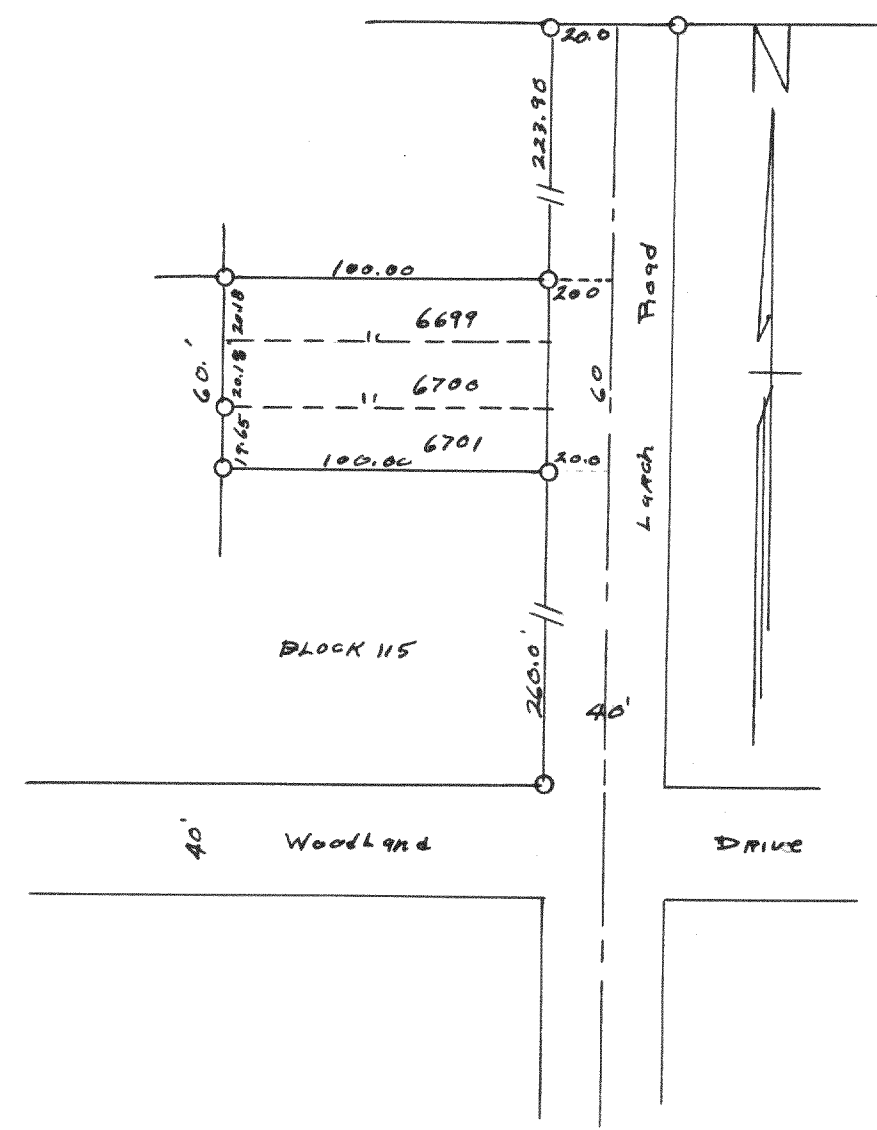

Plat of Survey of Lot 6699 to 6701,
Inclusive, Block 115, Lake Como Beach
Subdivision, located in the Northwest 1/4
Section 28, T2N, R1E, Walworth County,
Wisconsin
APRIL 21, 1958
LLOYD L. JENSEN
COUNTY SURVEYOR

3476

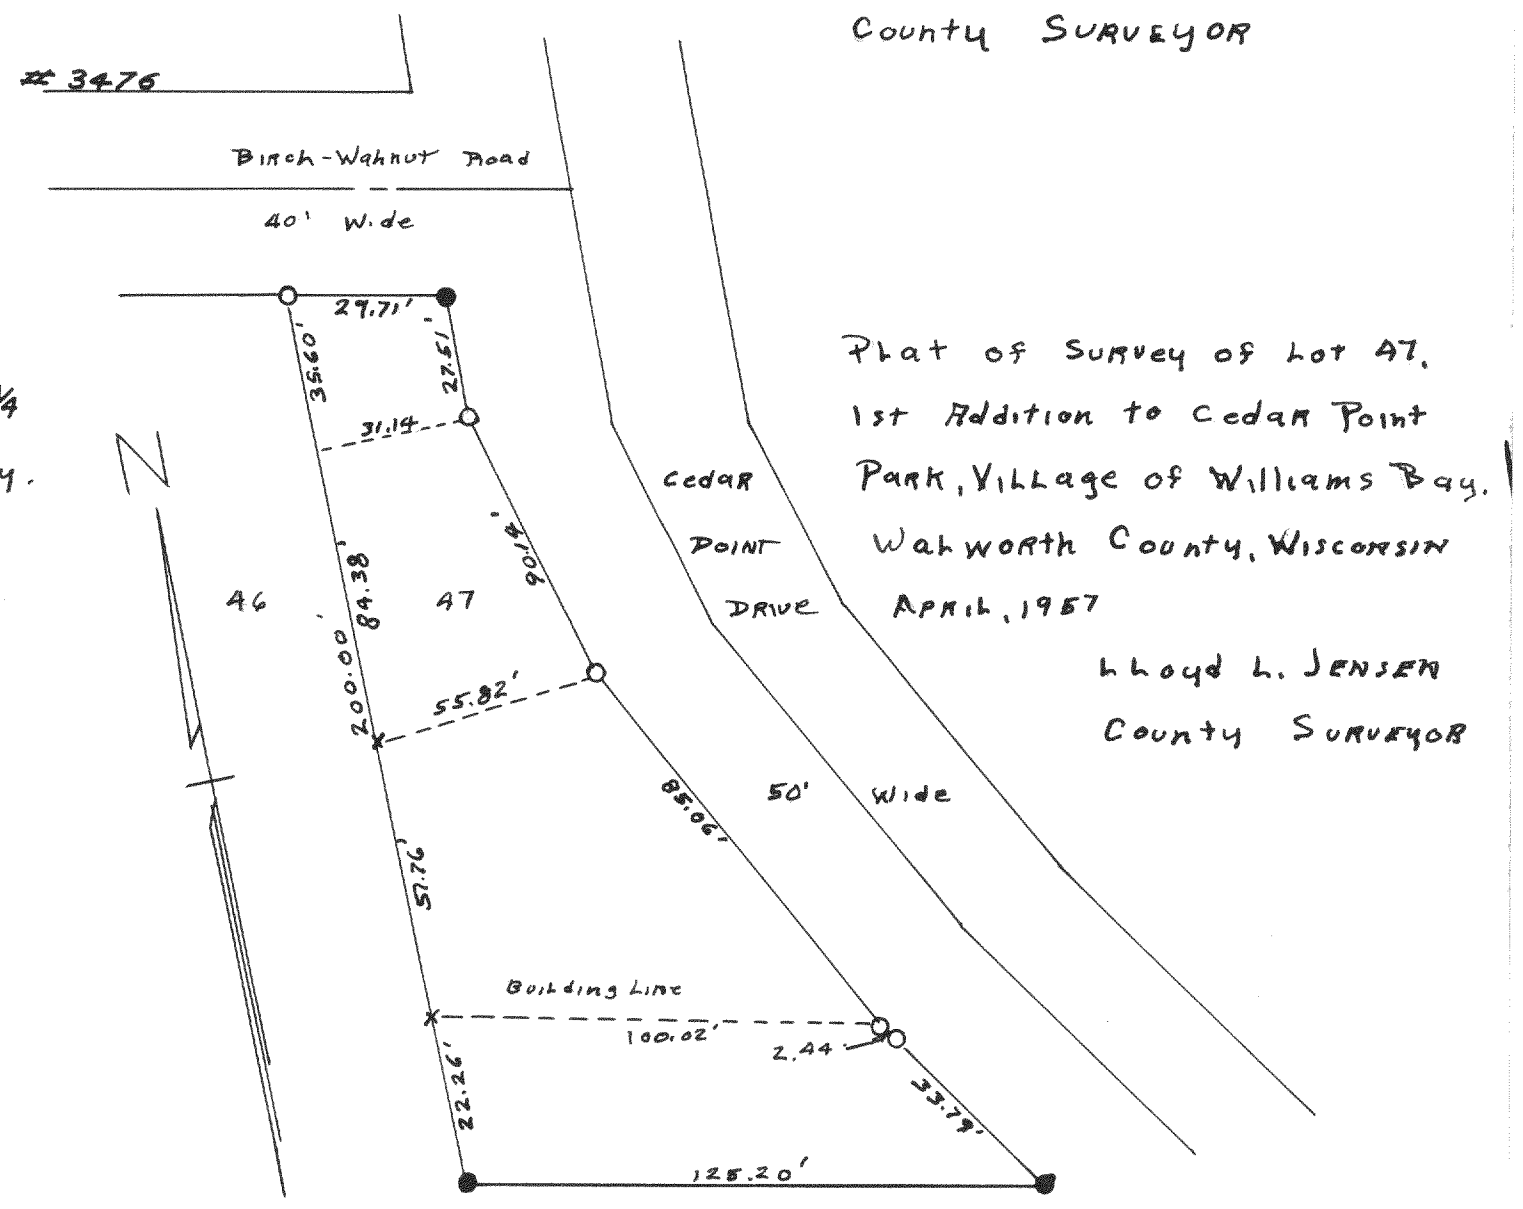

Plat of Survey of Lot 47,
1st Addition to Cedar Point
Park, Village of Williams Bay,
Walworth County, Wisconsin
APRIL, 1957
LLOYD L. JENSEN
COUNTY SURVEYOR