



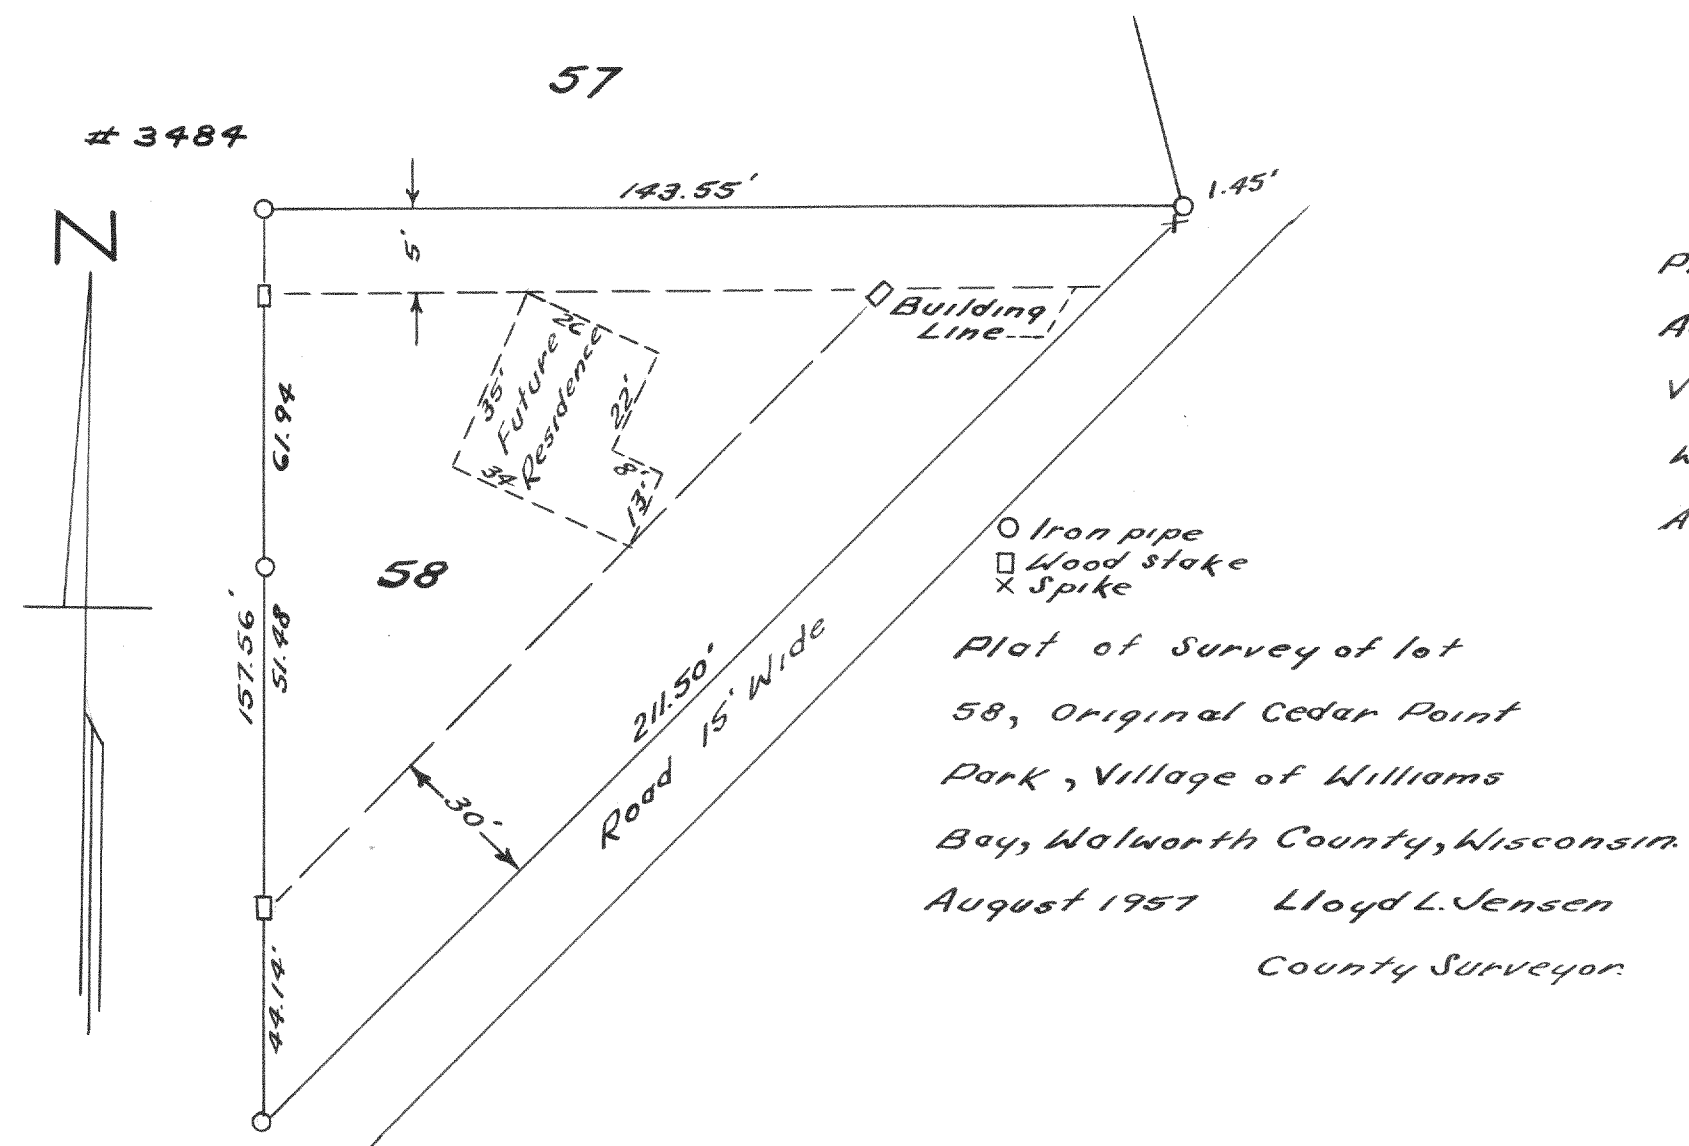

3485

Plot of Survey of lots
3290 to 3294 inclusive, and
lots 3300 to 3305, inclusive
BLOCK 58, Lake Como Beach
Subdivision, located in
the NW 1/4 of SECTION 27,
T2N, R1E, Walworth County,
Wisconsin.
April 1958 Lloyd L. Jensen
County Surveyor


○ Iron pipe

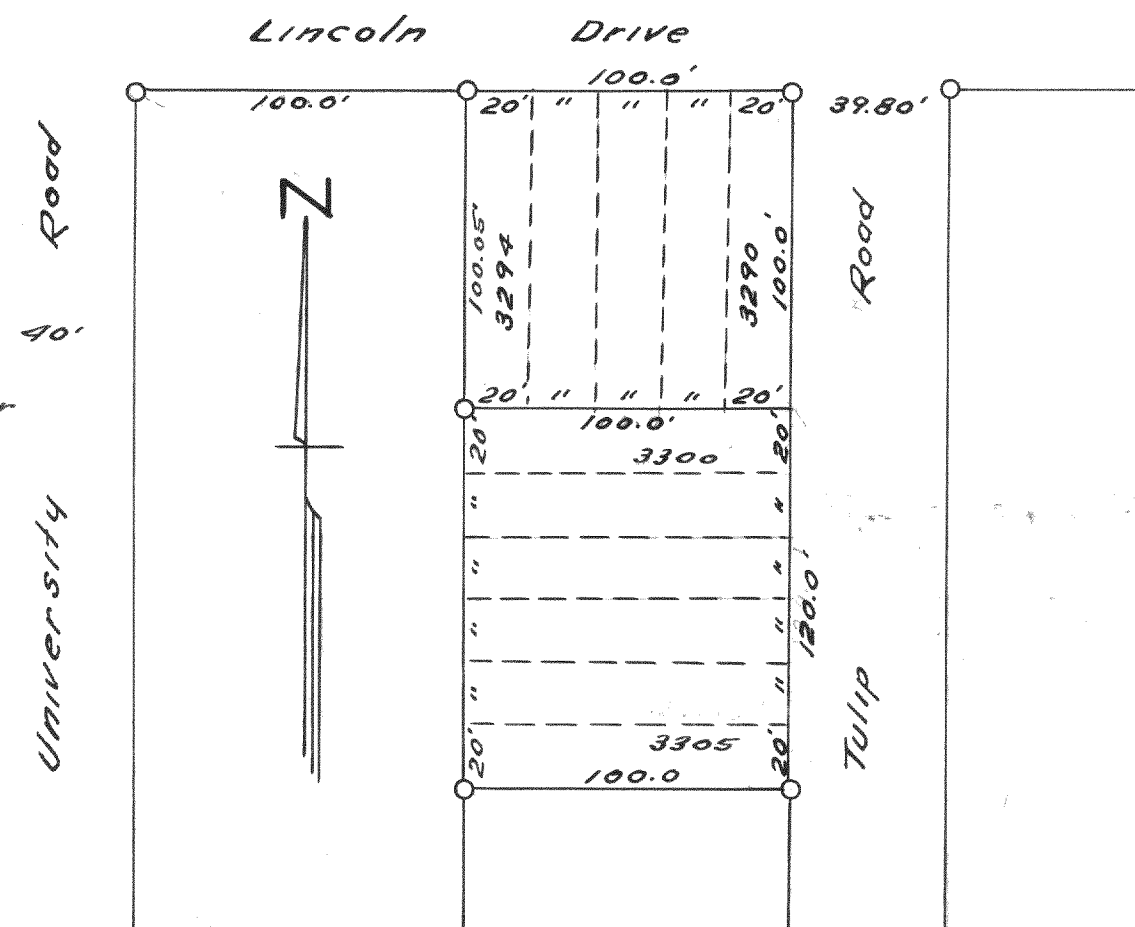

3485

Plot of Survey of lot 2, 1ST
Addition, Cedar Point Park
Village of Williams Bay
Walworth County, Wisconsin
August 1957 Lloyd L. Jensen
County Surveyor

○ Iron pipe

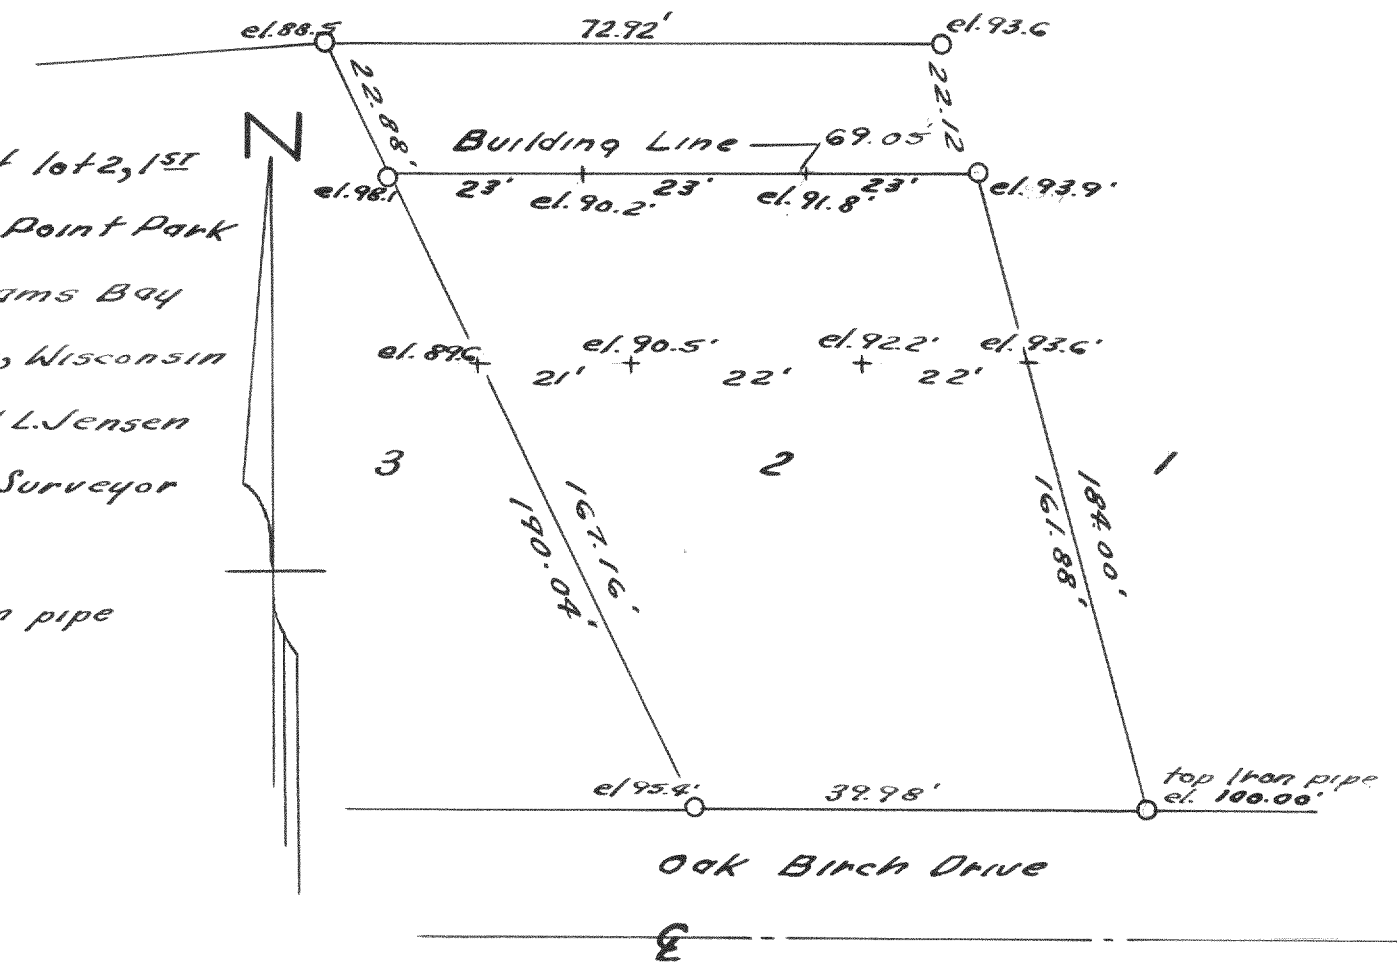

3487

Plot of Survey of lots
3186 to 3190 inclusive,
Block 56 Lake Como
Beach Subdivision
Located in the NORTHWEST
1/4 of SECTION 27, T2N, R1E
Walworth County, Wisconsin
April 1958 Lloyd L. Jensen
County Surveyor

○ Iron pipe

