


#2682

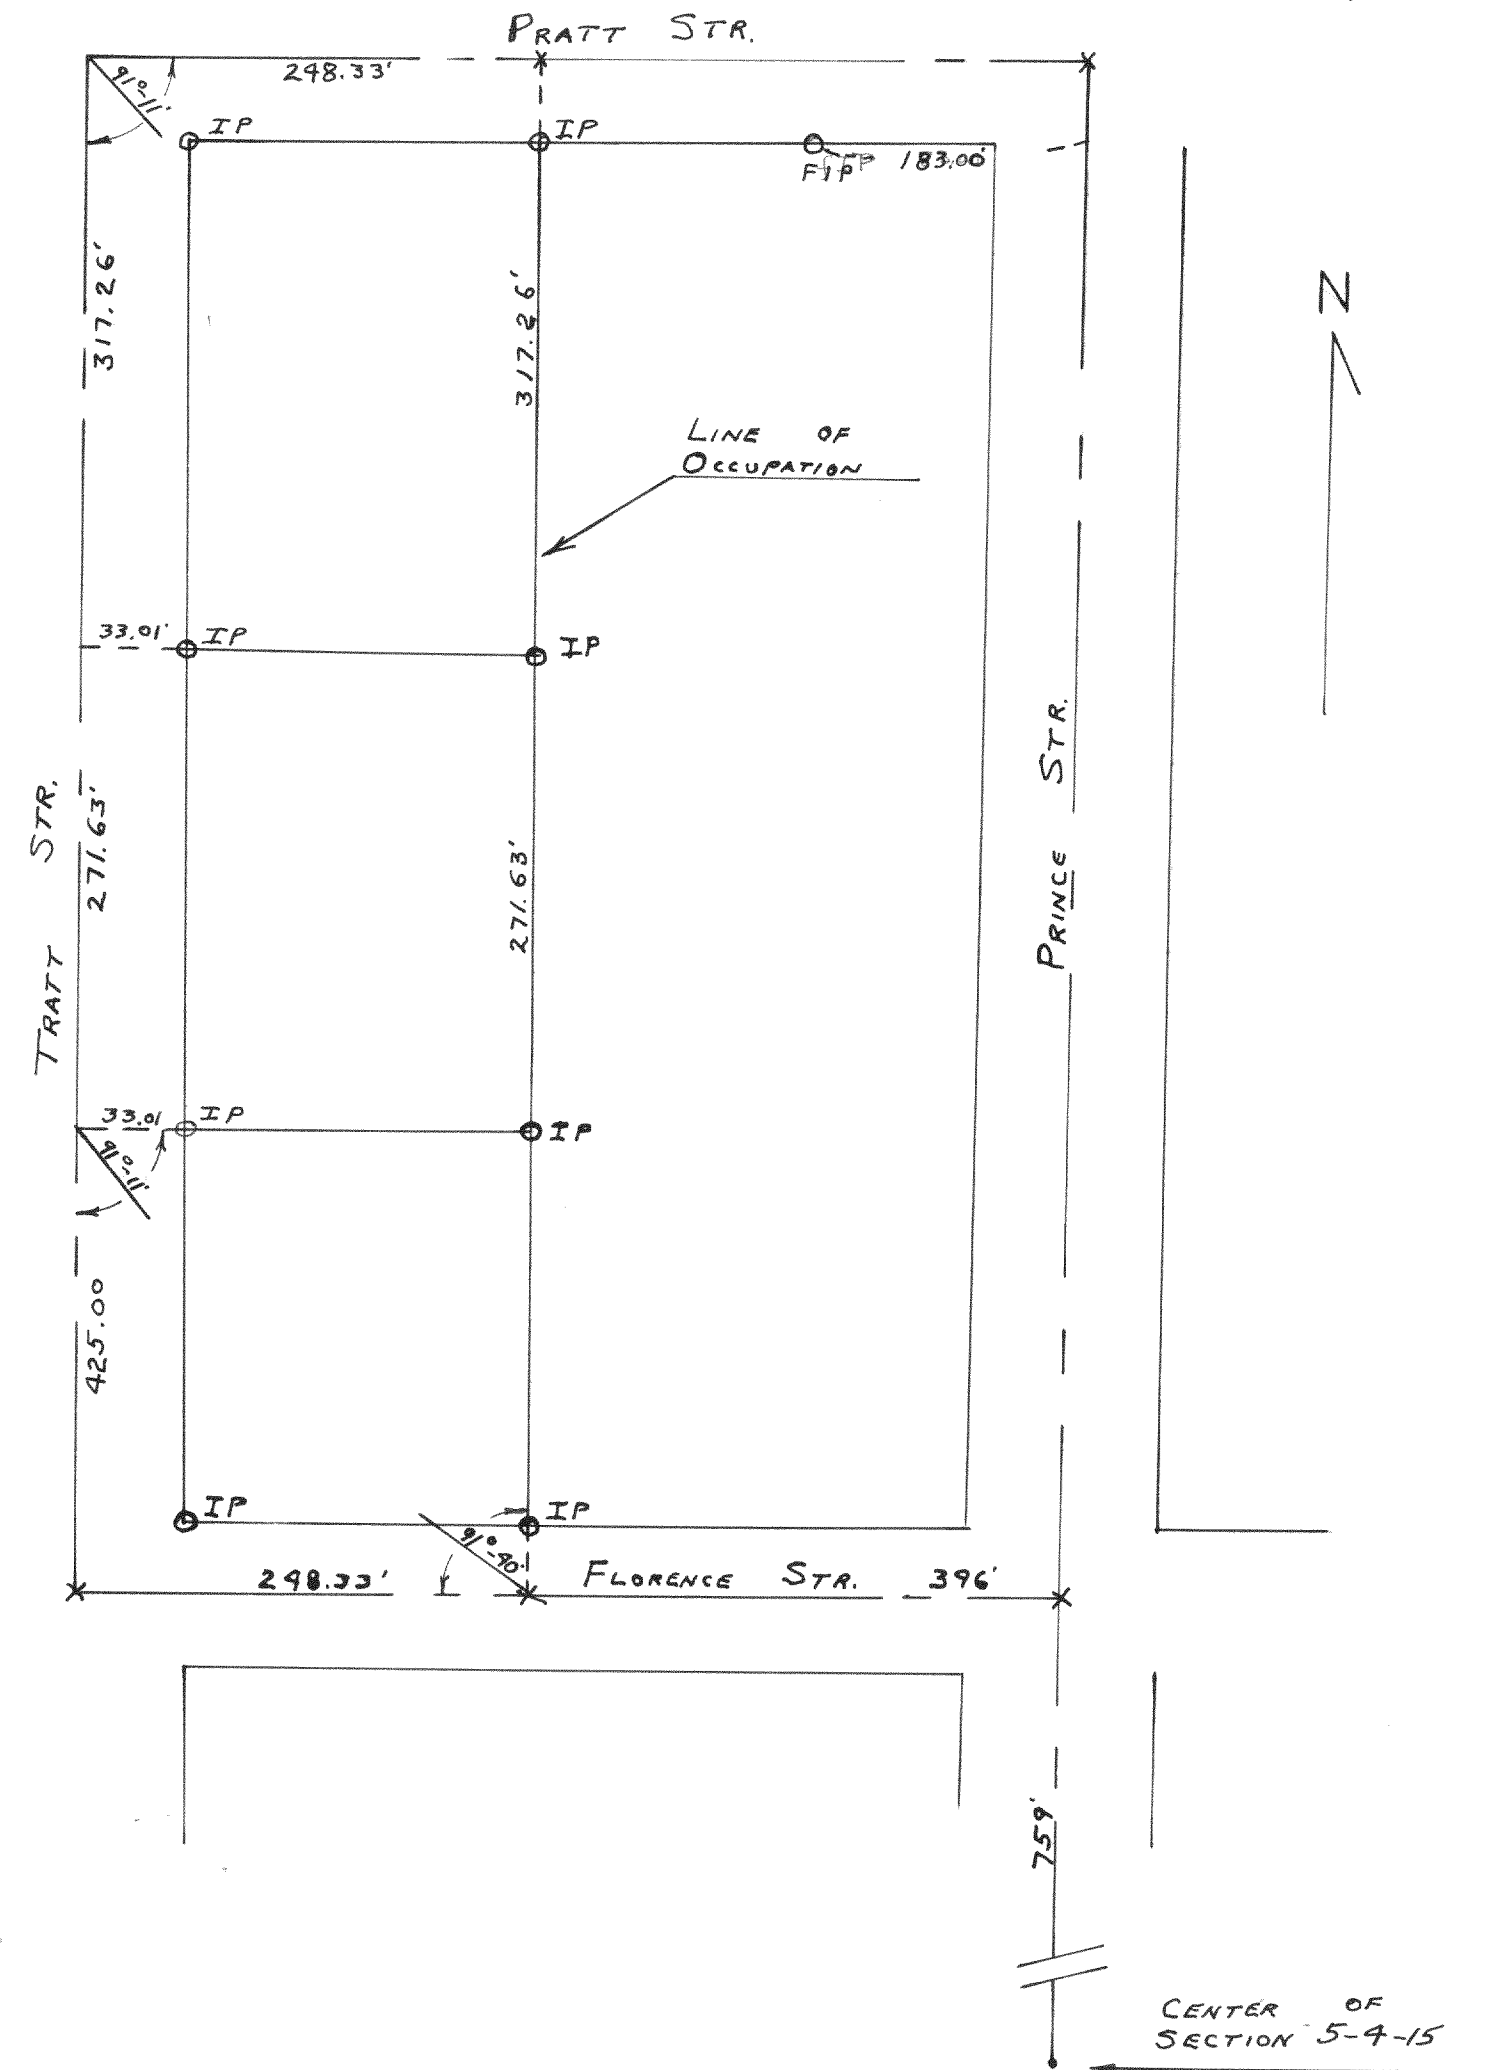

#2683

Plat of Lake Tombeau Woods
Subdivision, Located in Section
24, T1N R18E.

Recorded in Vol 12 on Page 484 & 49
of Plats for Walworth County.

Sept. 12, 1951

Lloyd L. Jensen
County Surveyor

PLAT OF SURVEY OF LAND LOCATED IN THE CITY
OF WHITEWATER.
AUGUST 28, 1952

Lloyd L. Jensen SA
COUNTY SURVEYOR