


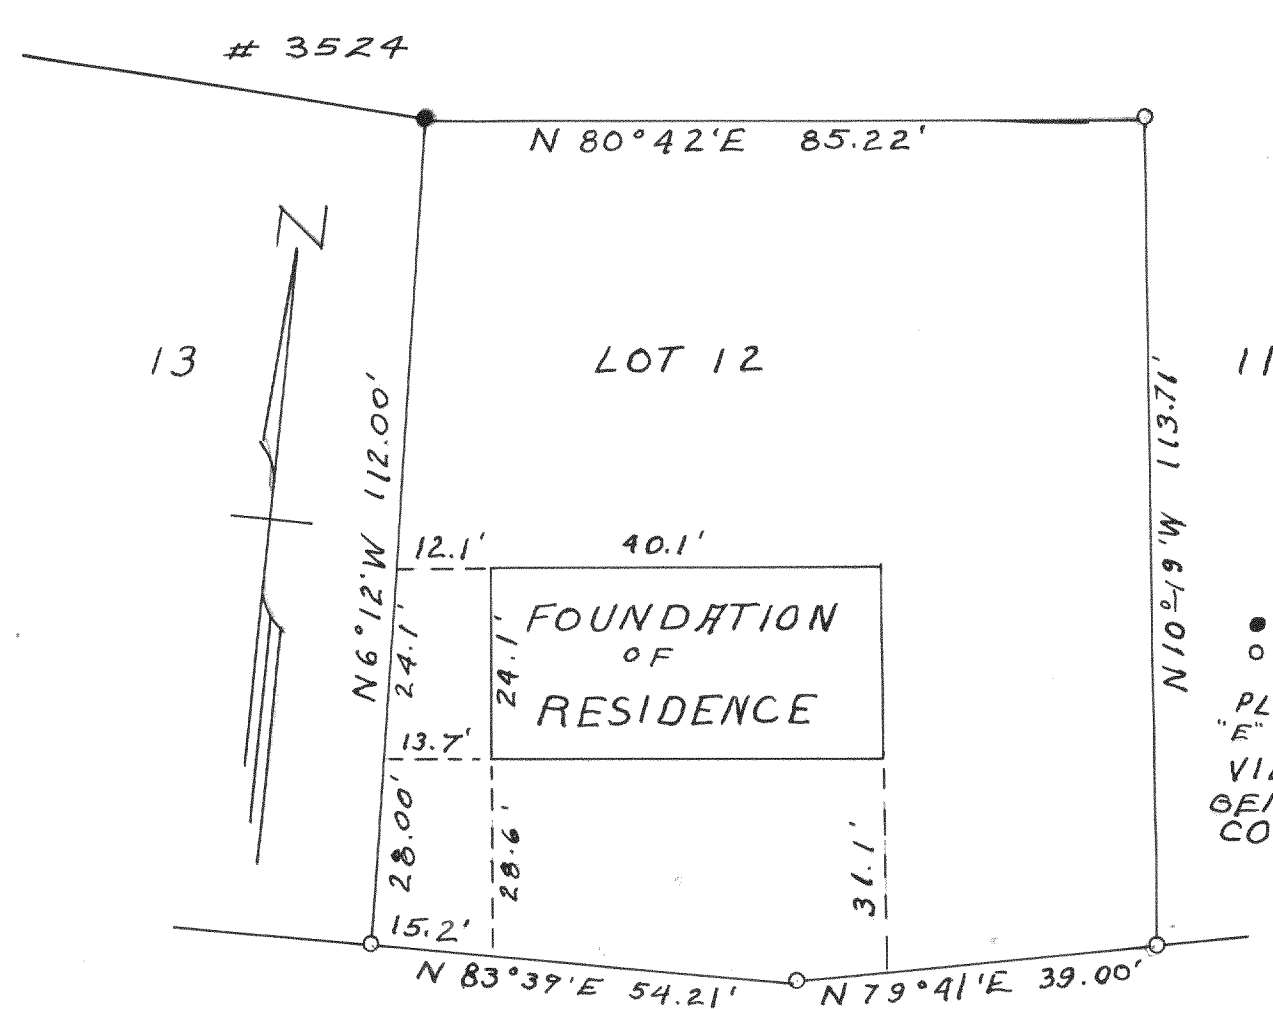


● Concrete monument TROY
○ Iron pipe

PLAT OF SURVEY OF LOT 12 ADDA
"E" TO COUNTRY CLUB ESTATES,
VILLAGE OF FONTANA-ON-
GENEVA LAKE WAUWATOSH
COUNTY, WISCONSIN


LLOYD L. JENSEN
COUNTY SURVEYOR

PLAT OF SURVEY OF A PARCEL OF LAND
LOCATED IN THE SW 1/4 OF SECTION
20, T4N, R18E, VILLAGE OF EAST
TROY, WALWORTH COUNTY, WISCONSIN

LLOYD L. JENSEN
COUNTY SURVEYOR

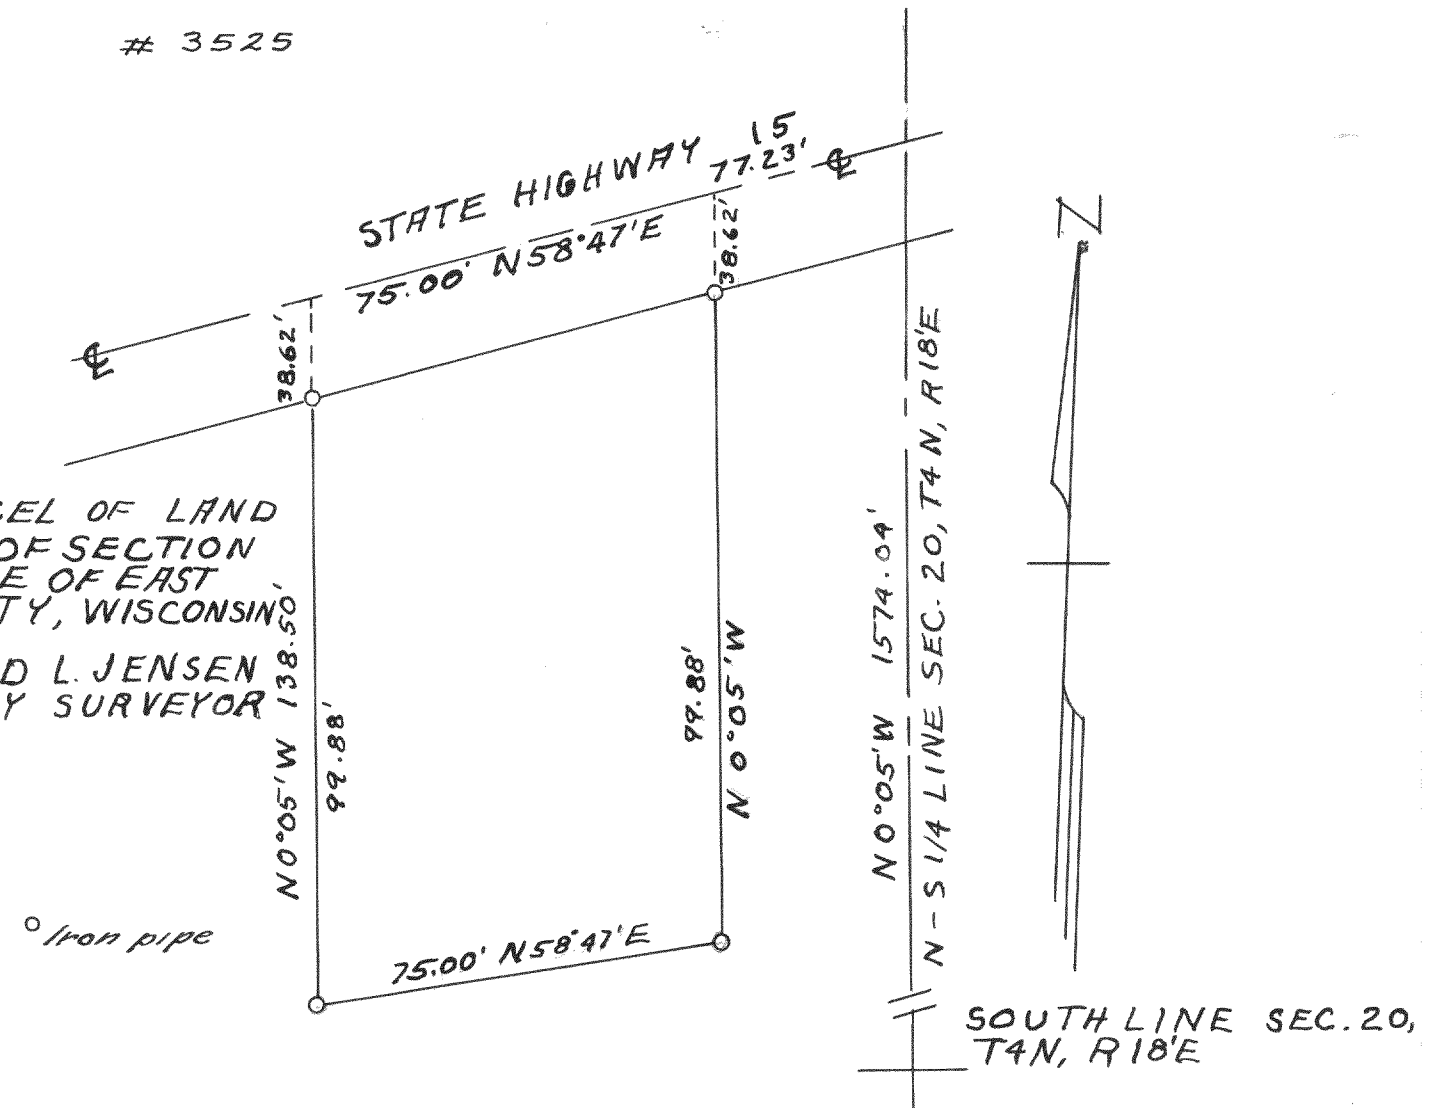


WOODLAND DRIVE

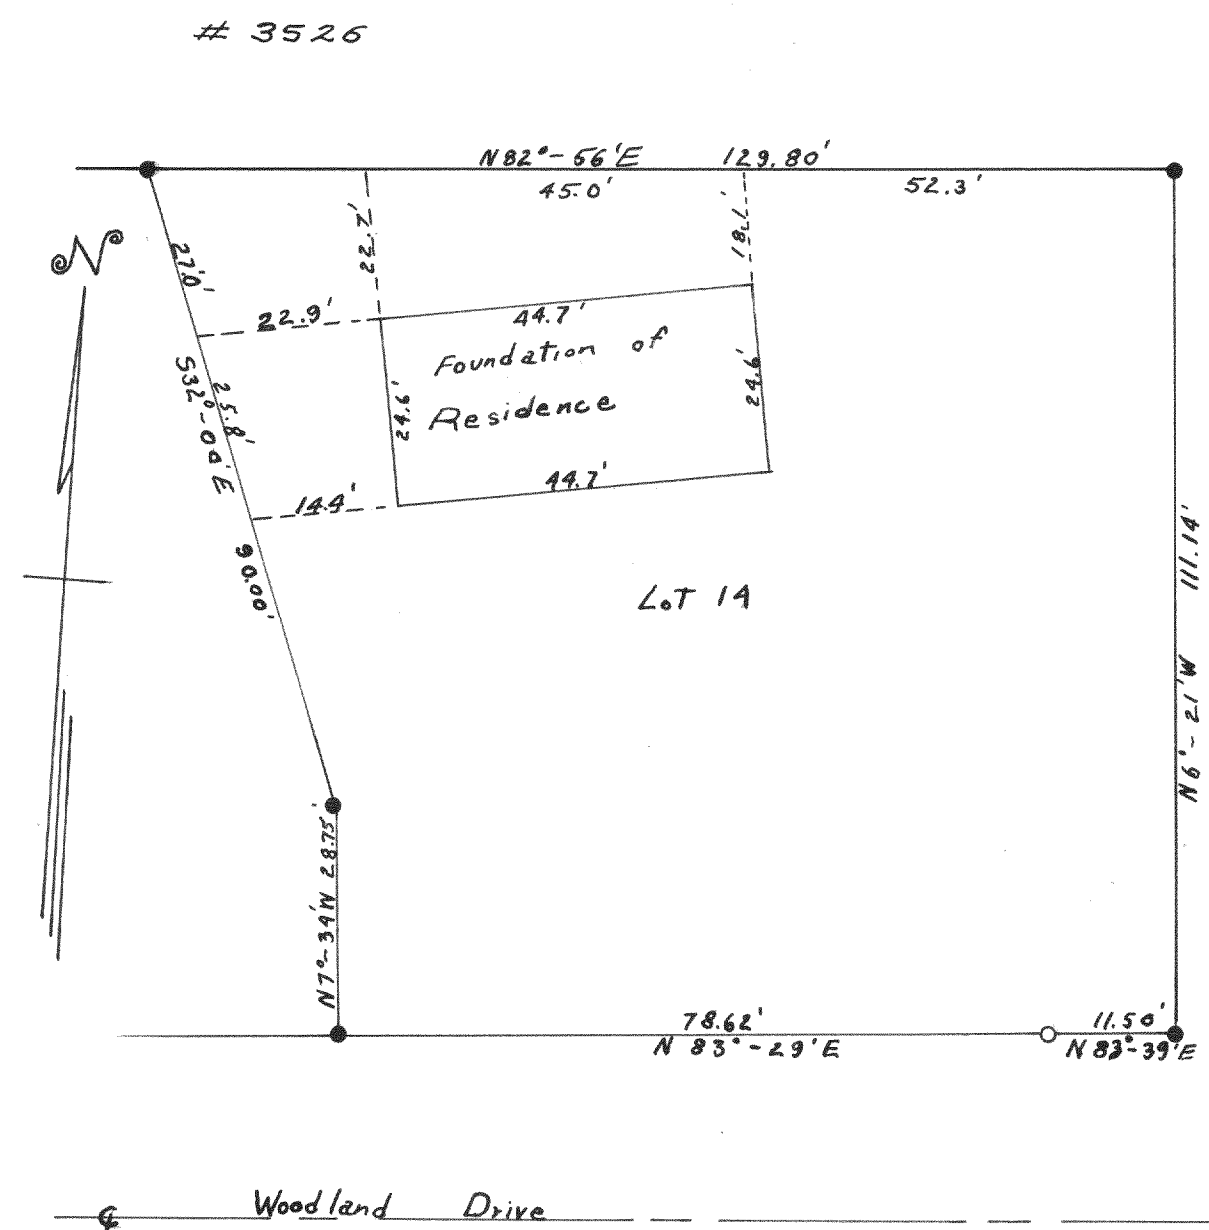

PLAT OF SURVEY OF LOT 14,
ADDN. "E" TO COUNTRY CLUB ESTATES,
LOCATED IN SECTION 14, SECTION
23, T1N, R16E, VILLAGE OF FONTANA-ON-
GENEVA LAKE, WALWORTH COUNTY,
WISCONSIN

LLOYD L. JENSEN
COUNTY SURVEYOR

- Concrete monument
- Iron pipe

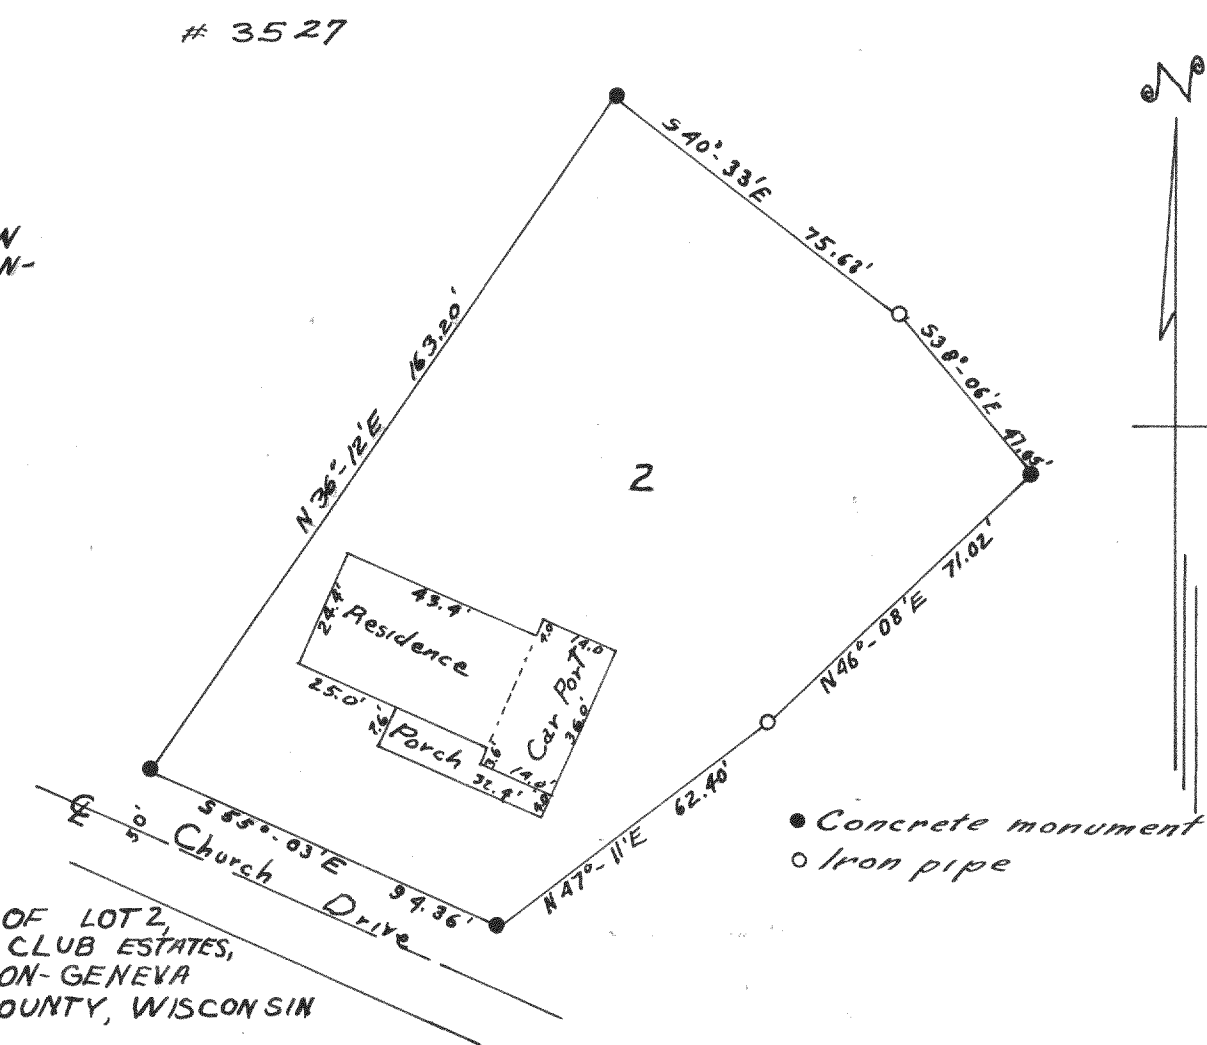

PLAT OF SURVEY OF LOT 2,
ADD'N 'C', COUNTRY CLUB ESTATES,
VILLAGE OF FONTANA-ON-GENEVA
LAKE, WALWORTH COUNTY, WISCONSIN

LLOYD L. JENSEN
COUNTY SURVEYOR