




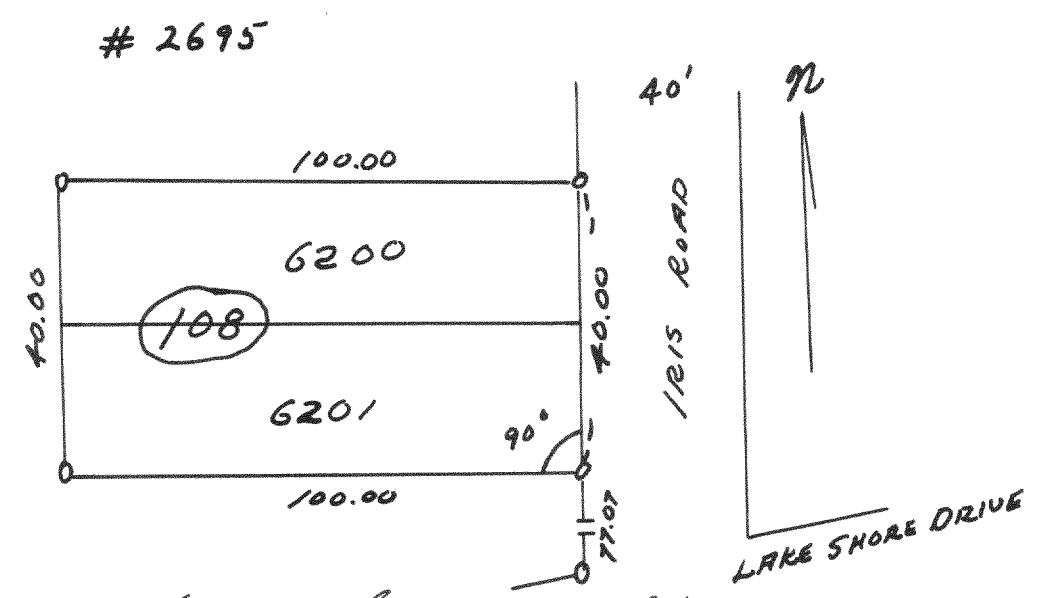


Plat of Survey of Lots 6200 & 6201
Block 108 Lake Como Beach Subdivision
F2NR17E LLJ
CS
Aug. 1953

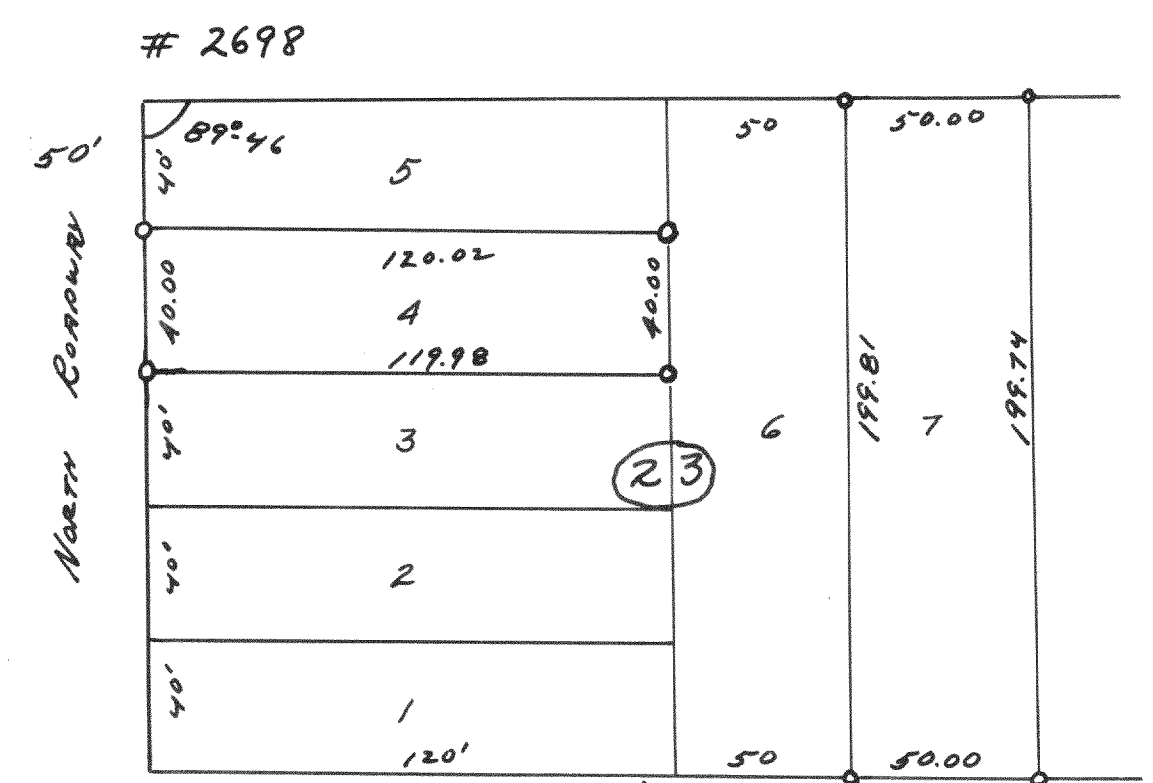


Plat of Survey of Lots 4 & 7
Block 23 Summit Hills Subdivision
F2NR17E LLJ
CS
July 1953

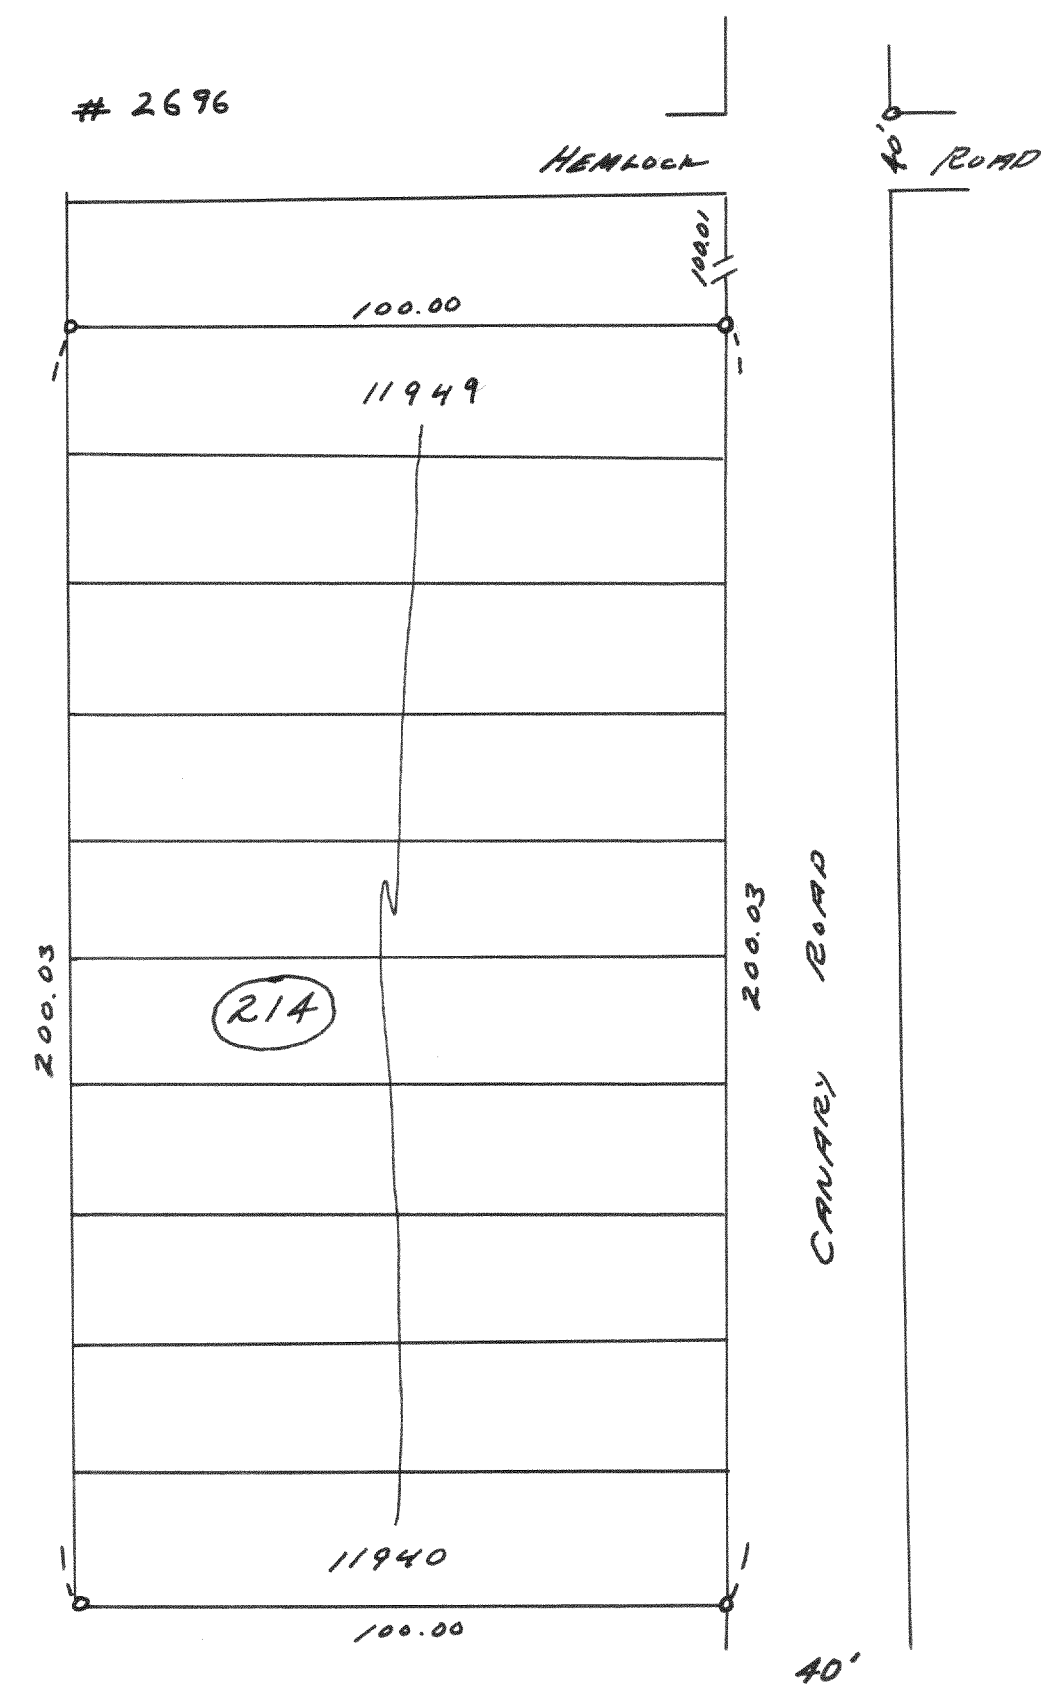

Plat of Survey of Lots
11940 - 11949 (INCL) Block 214
Lake Como Beach Subdivision F2NR17E
April 1953 LLJ
CS

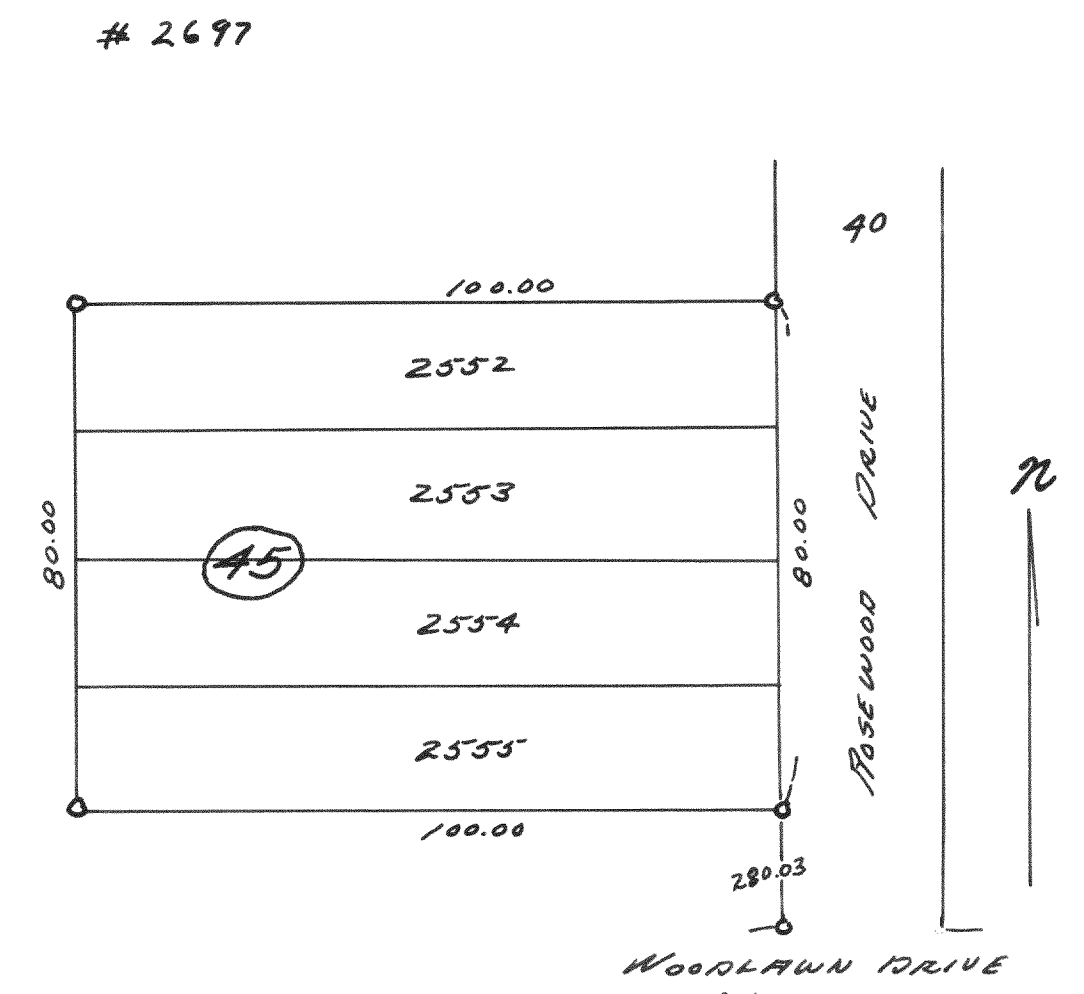

Plat of Survey of Lots 2552 - 2555 (INCL)
Block 15 Lake Como Beach Sub. F2NR17E
May, 1953 LLJ
CS

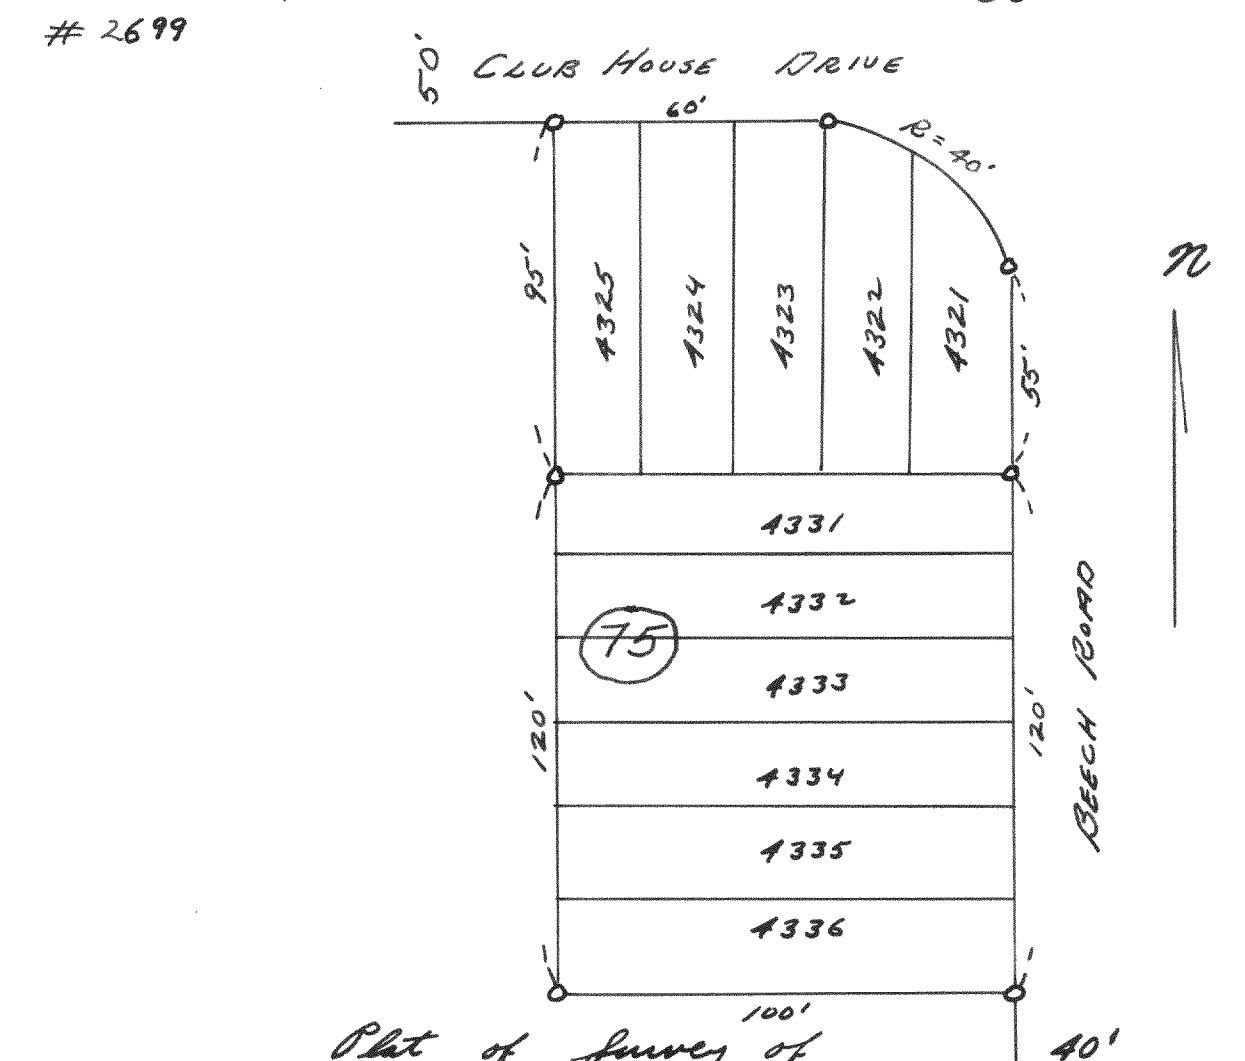

Plat of Survey of
Lots 4331 - 4336 (INCL) &
Lots 4321 - 4325 (INCL) Block 75
Lake Como Beach Subdivision F2NR17E
April, 1953 LLJ
CS