



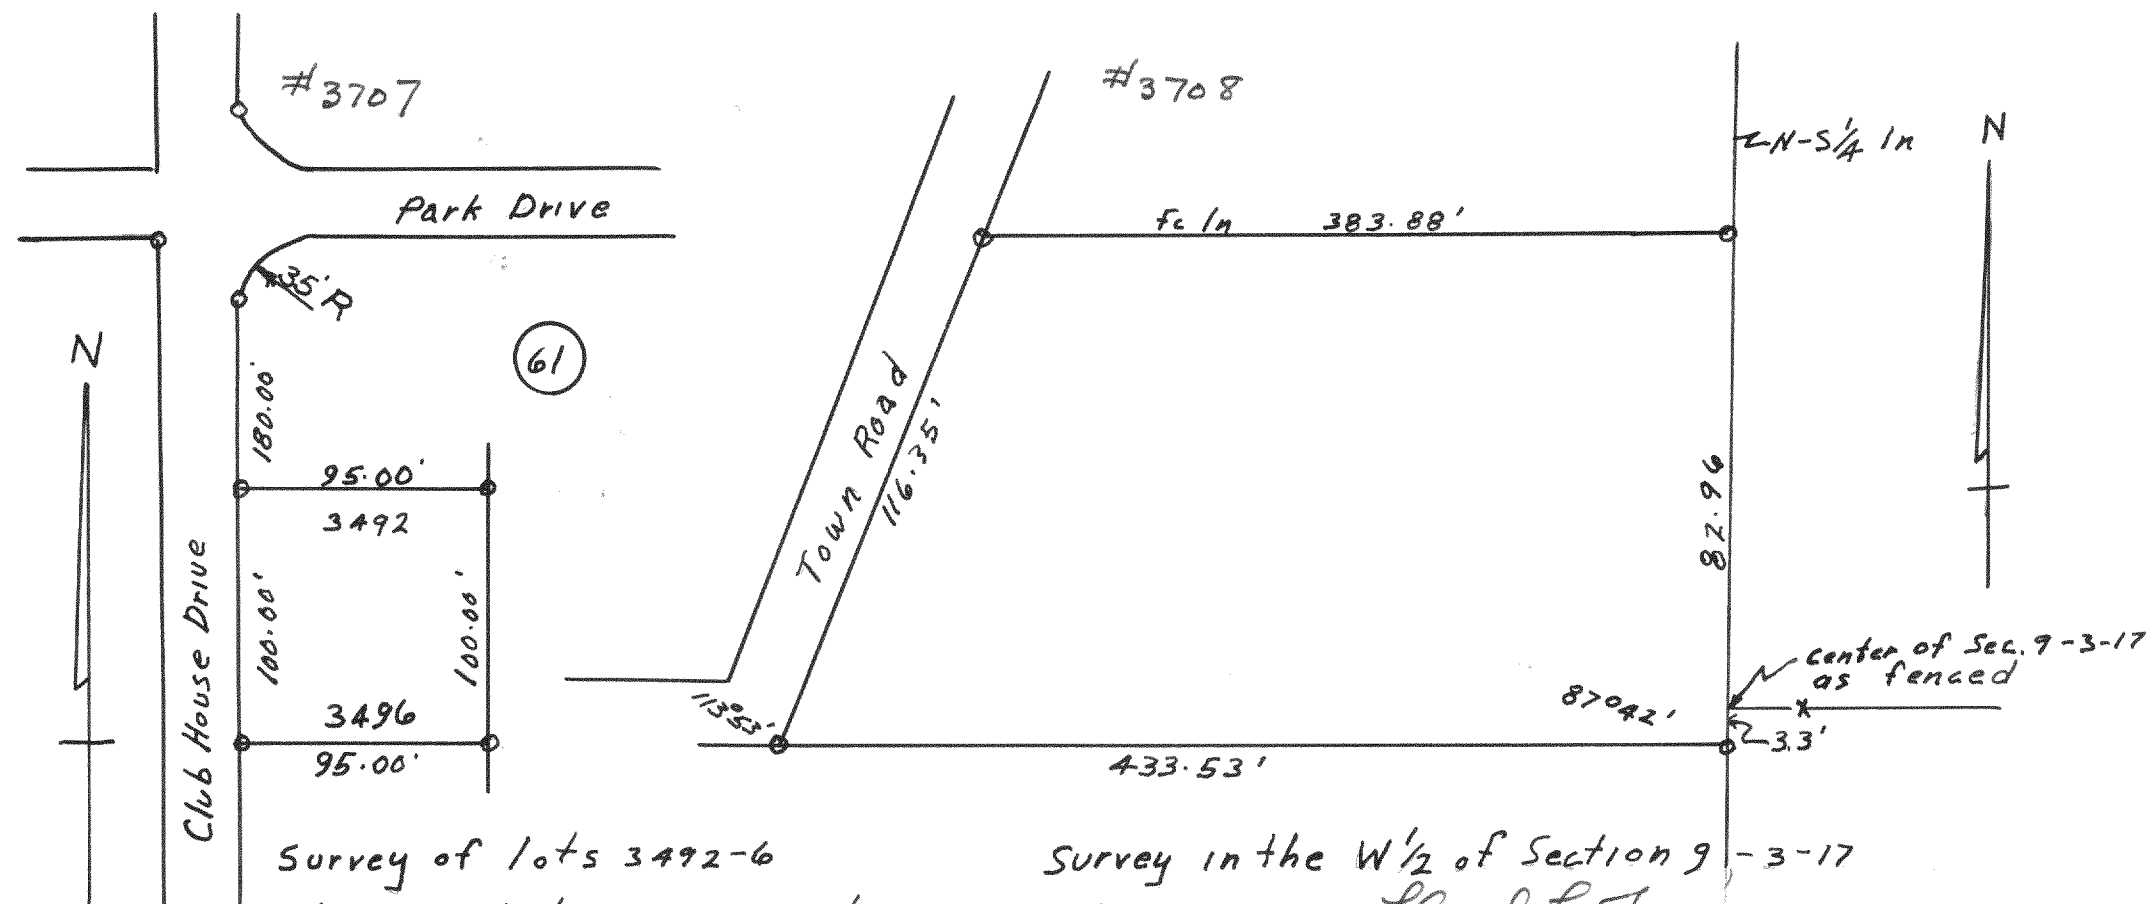

Survey of lots 3492-6
Block 61, Lake Como Beach
Aug 25, 1961 Lloyd S. Jensen
County Surveyor

Survey in the W 1/2 of Section 9-3-17
Oct. 7, 1960 Lloyd S. Jensen
County Surveyor

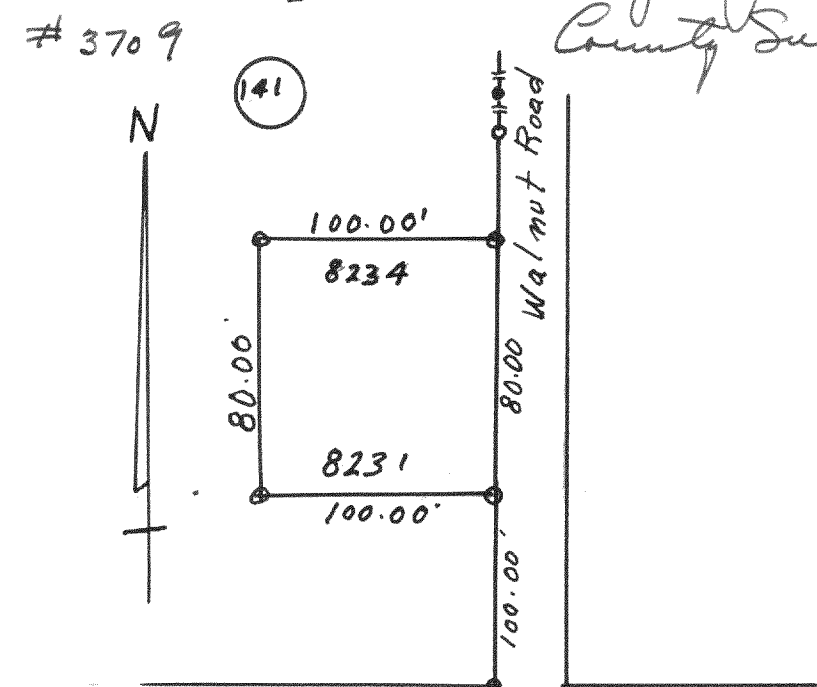

Survey of lots 8231-4
Block 141, Lake Como
Aug 29, 1961 Lloyd S. Jensen
County Surveyor

Survey in the E 1/2 NE 1/4 Sec 34-3-17
Nov. 19, 1960 Lloyd S. Jensen
County Surveyor

