



#3739

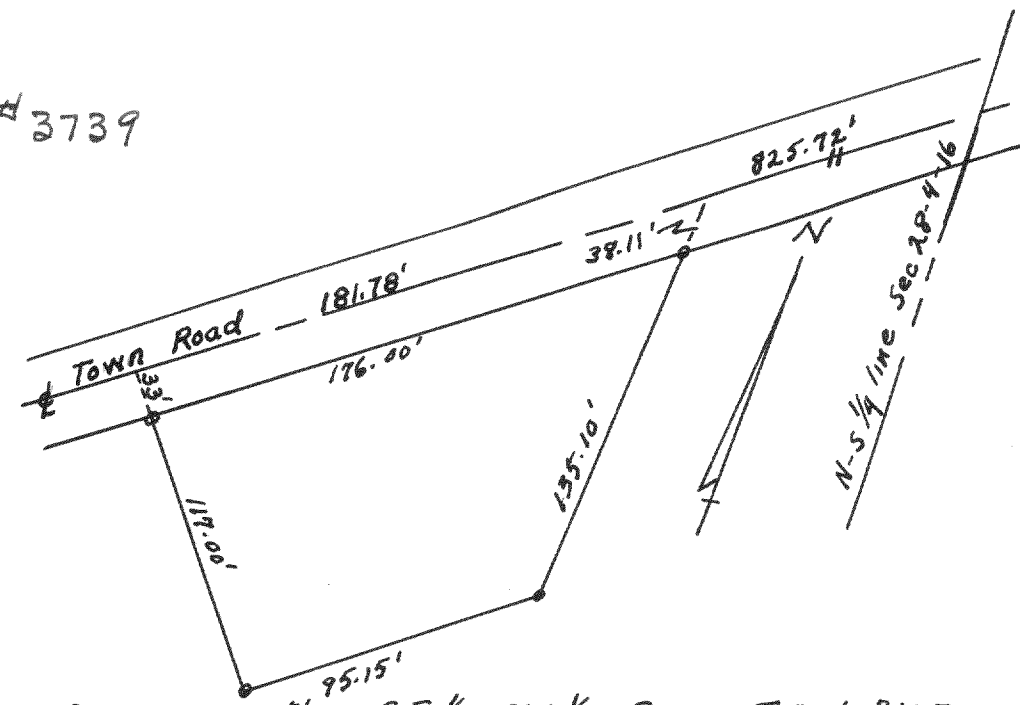

Survey in the SE 1/4 SW 1/4 Sec 28, T4N, R16E,
Wal. Co. Wisc.

Lloyd L. Jensen
County Surveyor


#3740

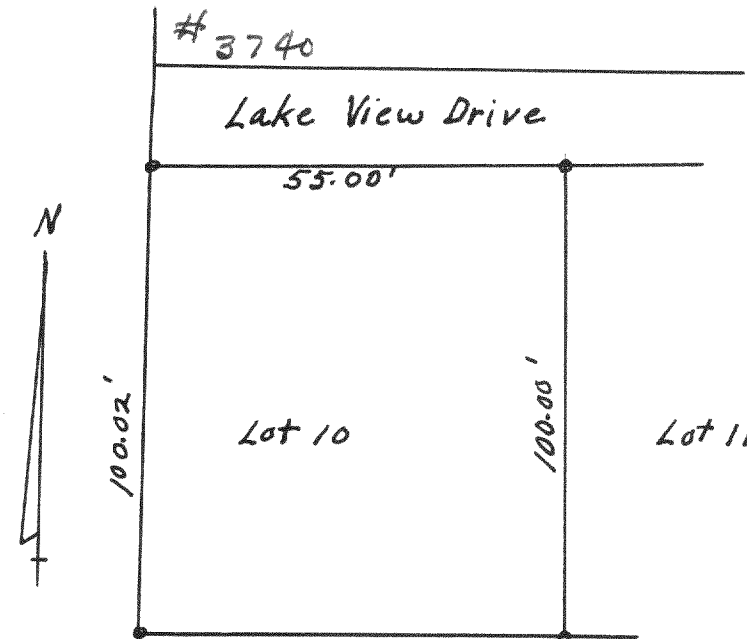

Survey of Lot 10, Edgewater
Terrace, T1N, R17E, Wal. Co. Wisc.

Lloyd L. Jensen
County Surveyor


#3741

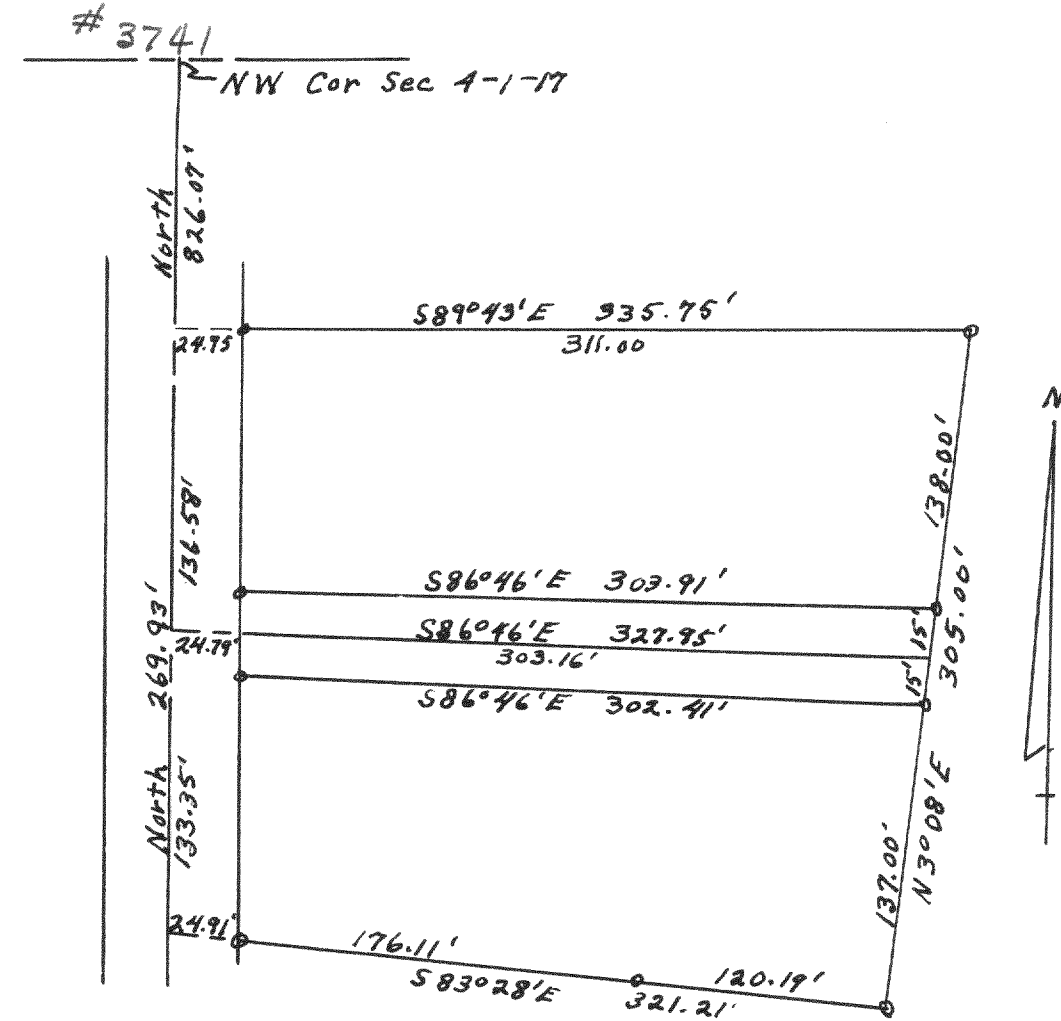

Survey in NW 1/4 NW 1/4 Fractional Sec 4, T1N, R17E
Wal. Co. Wisc.

Lloyd L. Jensen
County Surveyor


#3742

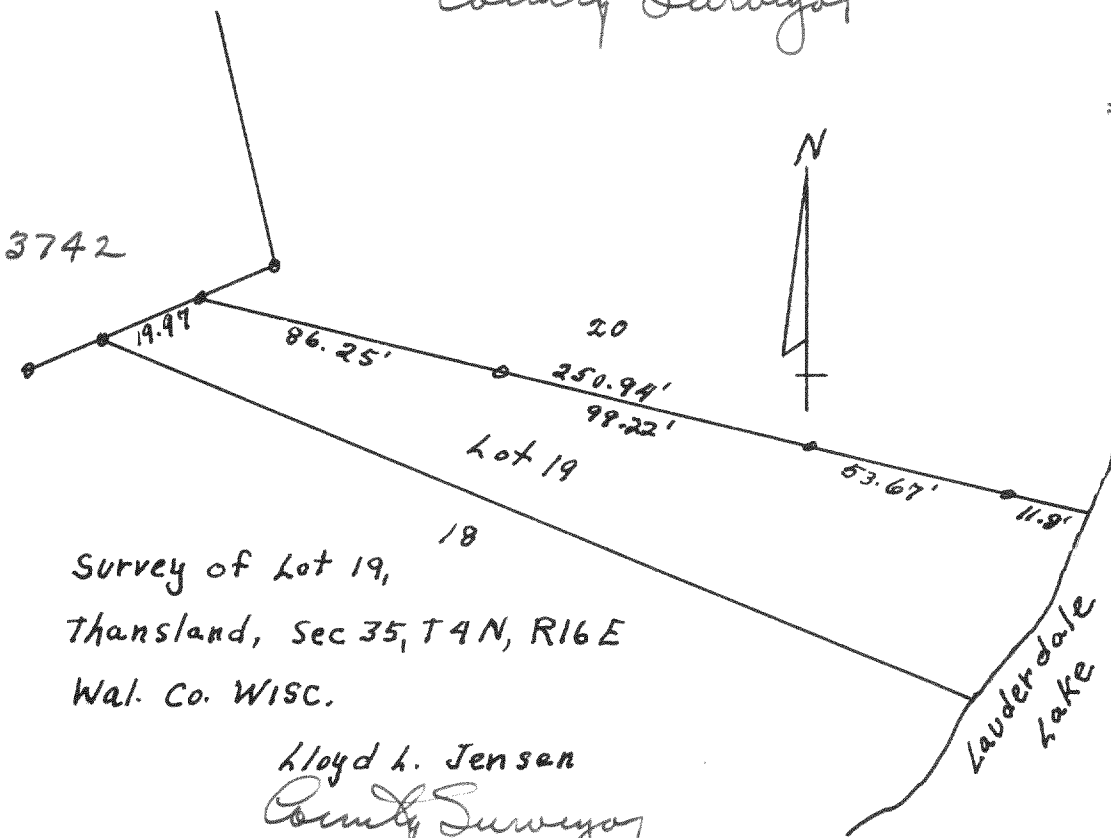

Survey of Lot 19,
Thansland, Sec 35, T4N, R16E
Wal. Co. Wisc.

Lloyd L. Jensen
County Surveyor


#3744

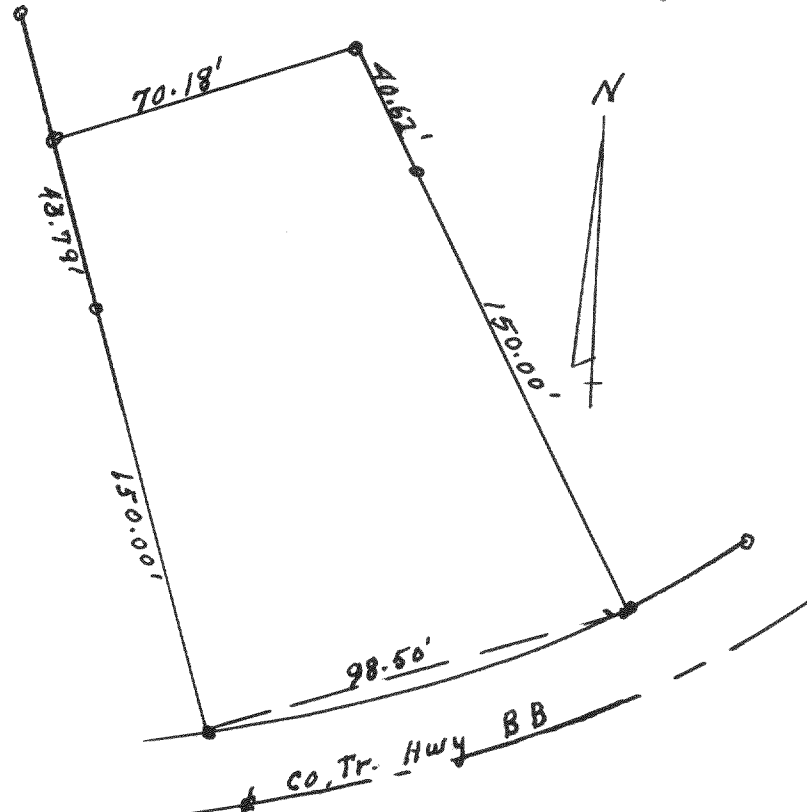

Survey in SE 1/4 Sec 11, T1N, R17E,
Wal. Co. Wisc.

Lloyd L. Jensen
County Surveyor


#3745

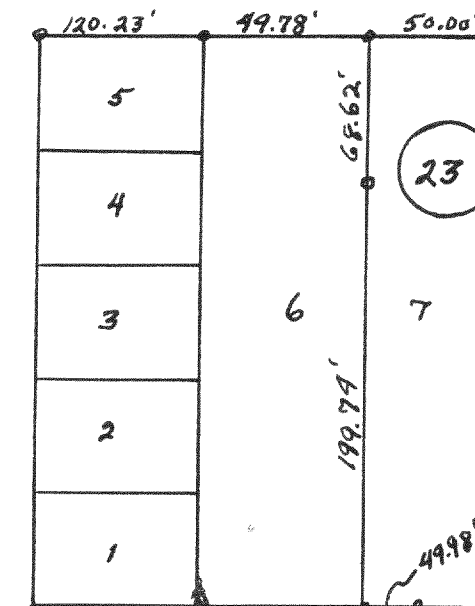

Survey of Lot 6, Bk 23
Sunset Hills Subd, T1N,
R17E, Wal. Co. Wisc.

Lloyd L. Jensen
County Surveyor


#3746

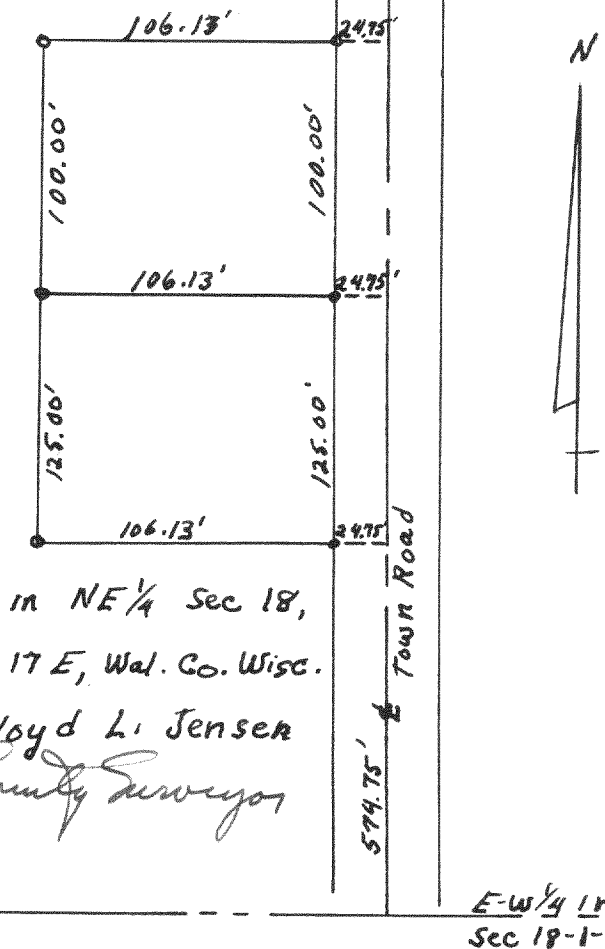

Survey in NE 1/4 Sec 18,
T1N, R17E, Wal. Co. Wisc.

Lloyd L. Jensen
County Surveyor

#3743

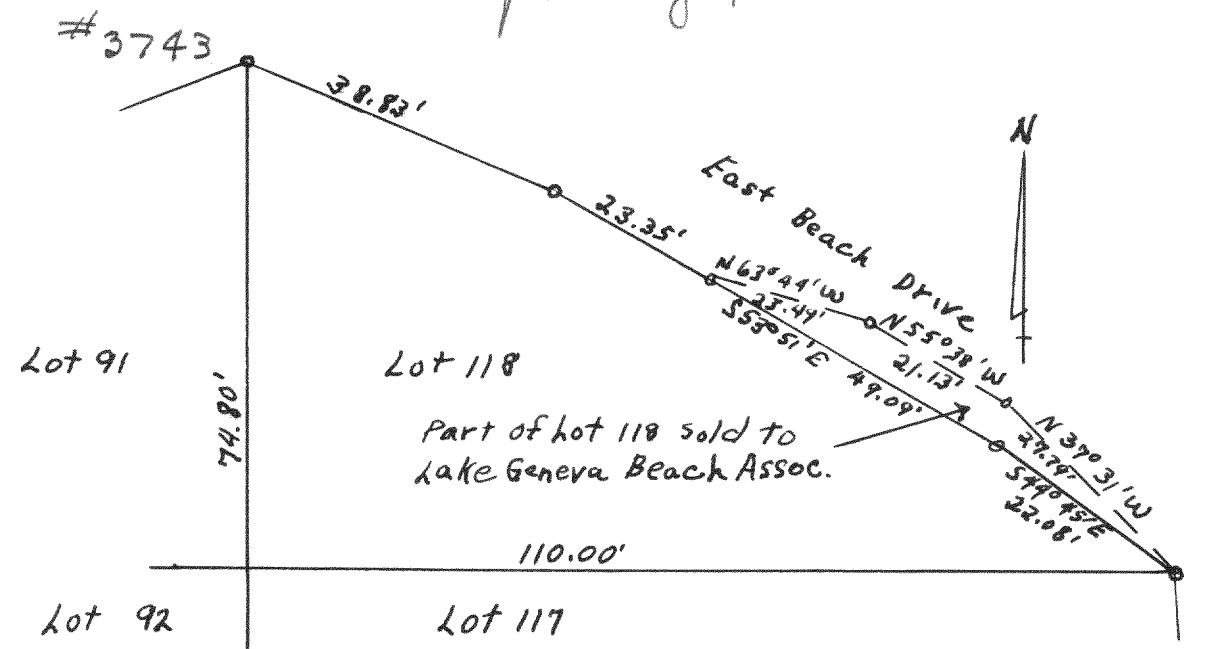

Survey of Lot 118, Lake Geneva Beach Subd, SW 1/4
Sec, 11, T1N, R17E Wal. Co. Wisc.

Lloyd L. Jensen
County Surveyor