


#3815

PLAT OF SURVEY OF

A PARCEL OF LAND BEING PART OF OUT LOT 2
LOCATED IN THE NE $\frac{1}{4}$ OF SECTION 1, T1N, R1E,
IN THE VILLAGE OF WILLIAMS BAY, WALWORTH
COUNTY, WISCONSIN.

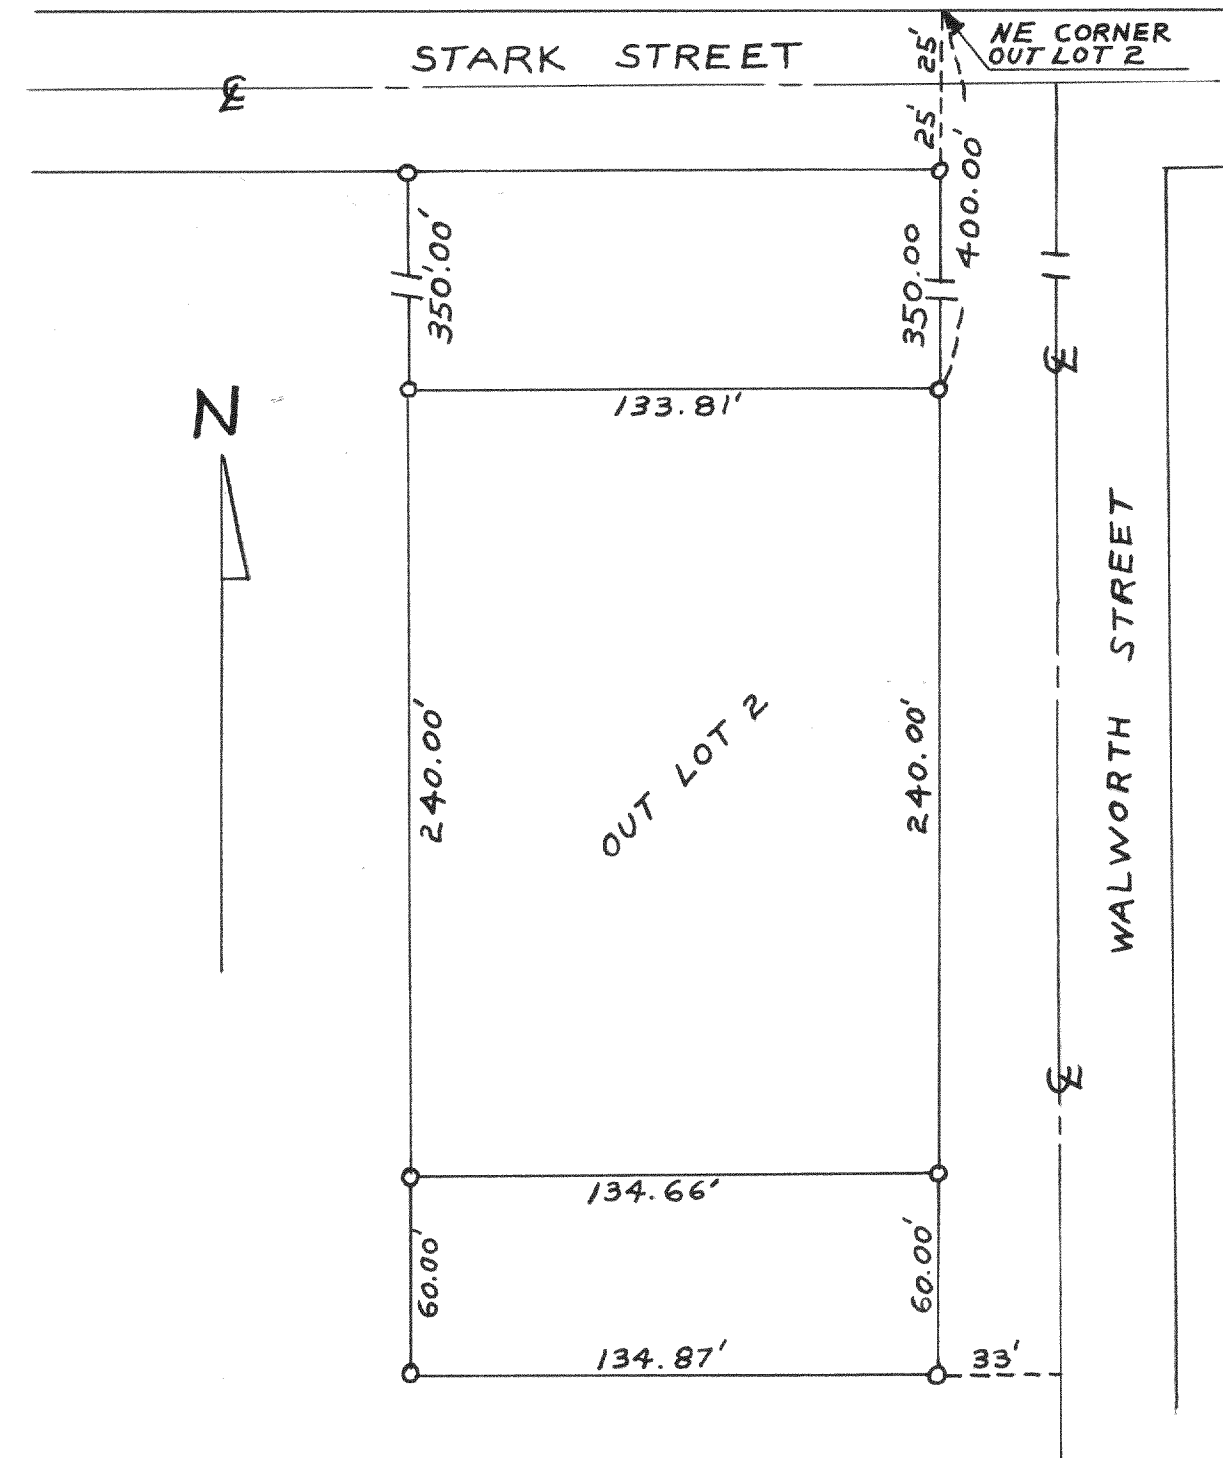


OCTOBER, 1960

Lloyd L. Jensen
COUNTY SURVEYOR

#3816

PLAT OF SURVEY OF

LOT 228, 3RD ADDITION, CEDAR POINT PARK AND LOT 59 $\frac{1}{2}$
OF THE ORIGINAL PLAT OF CEDAR POINT PARK, VILLAGE
OF WILLIAMS BAY, WALWORTH COUNTY, WISCONSIN.

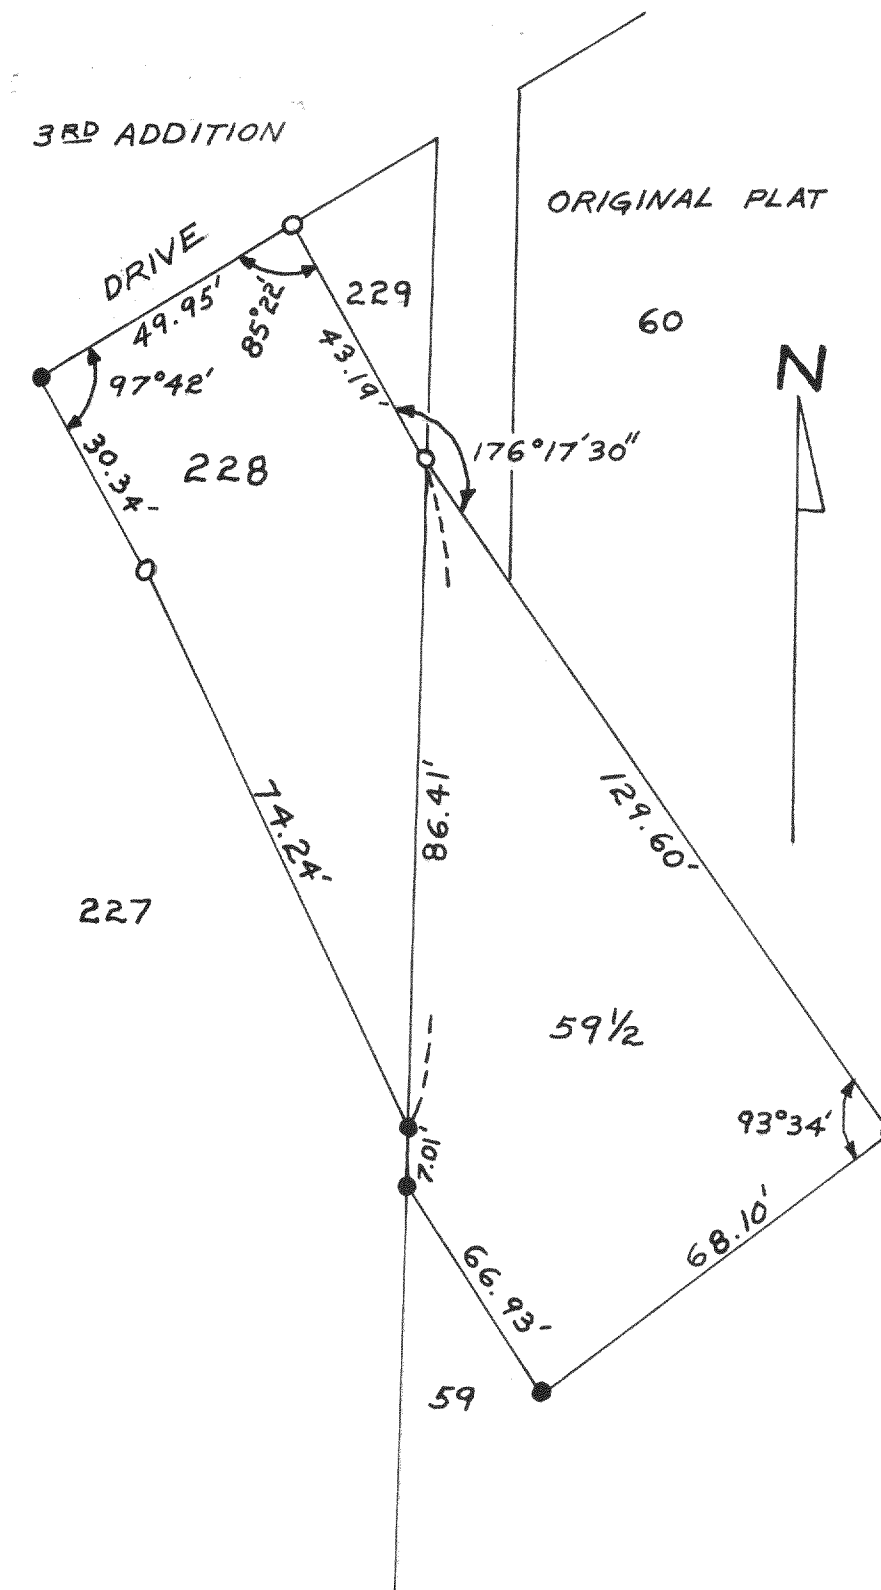


NOVEMBER, 1960

Lloyd S. Jensen
COUNTY SURVEYOR

#3817

PLAT OF SURVEY OF

LOT 67 OF WESTPARK SECOND ADDITION
LOCATED IN THE SW $\frac{1}{4}$ OF SECTION 5,
T4N R15E, CITY OF WHITEWATER,
WALWORTH COUNTY, WISCONSIN.

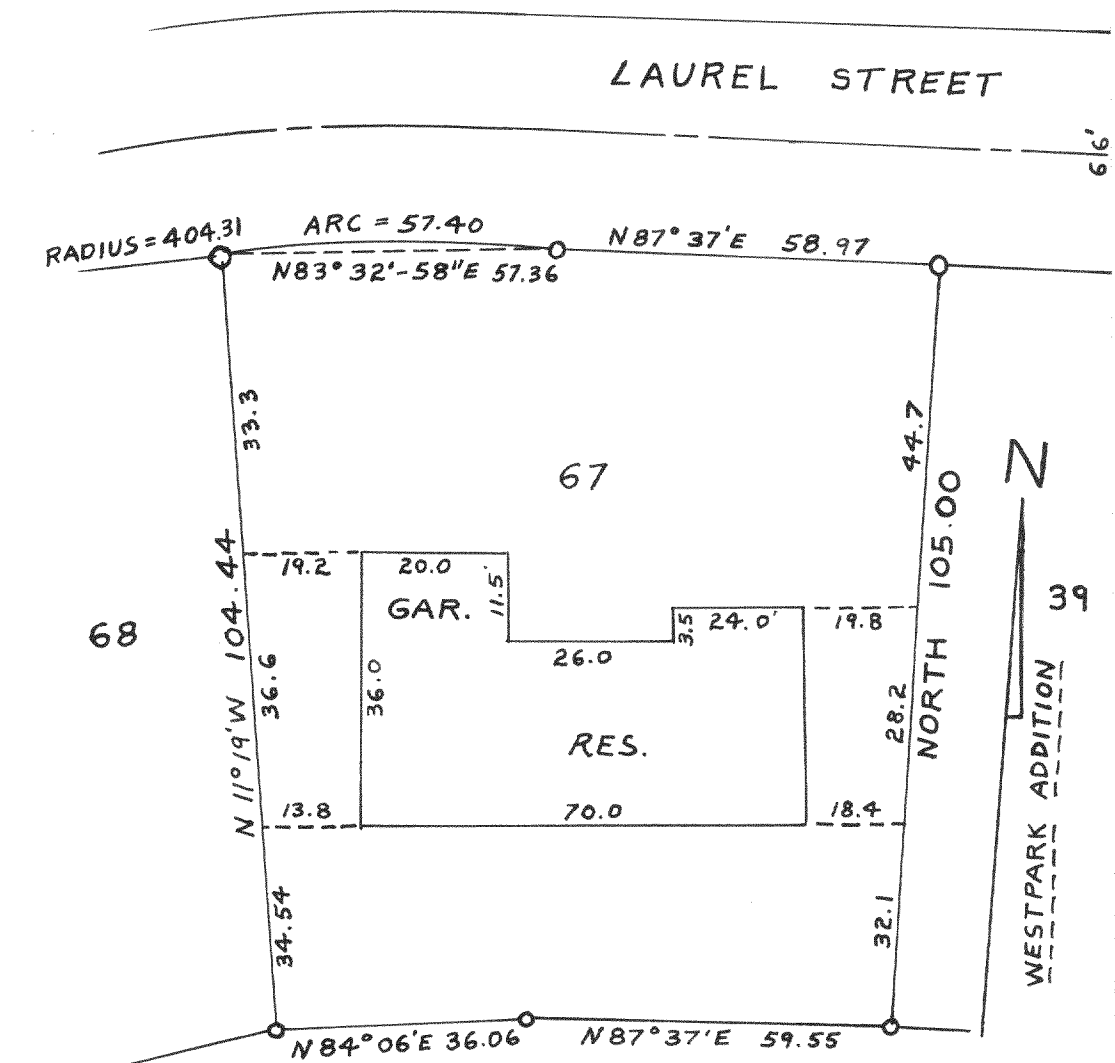

AUGUST, 1960

Lloyd L Jensen
COUNTY SURVEYOR