




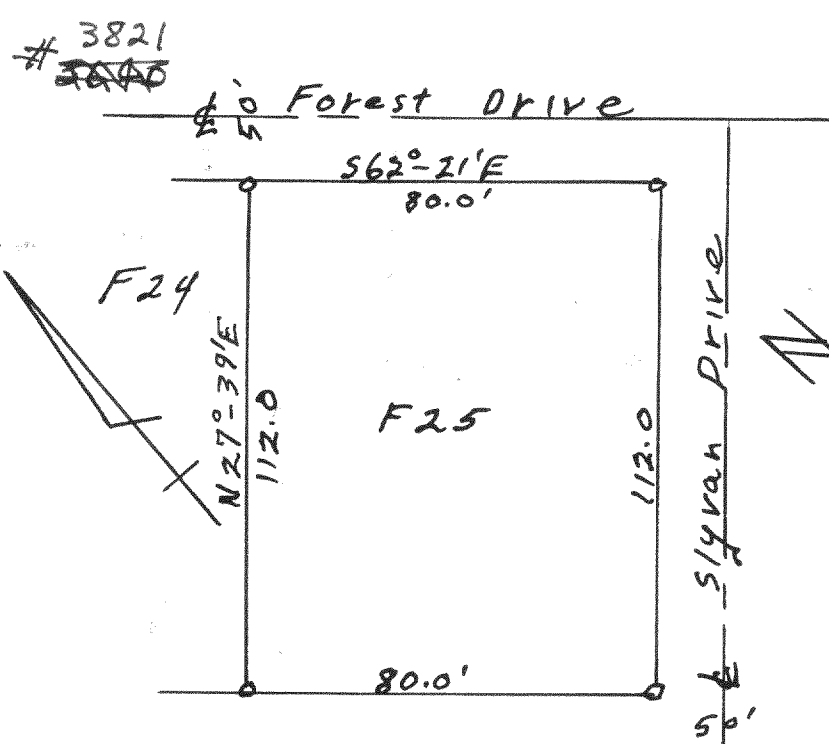


Plat of survey of F25 add
F to Country Club Estates, Village
of Fontana, Walworth County
Wisconsin Lloyd L. Jensen
July 1959 County Surveyor

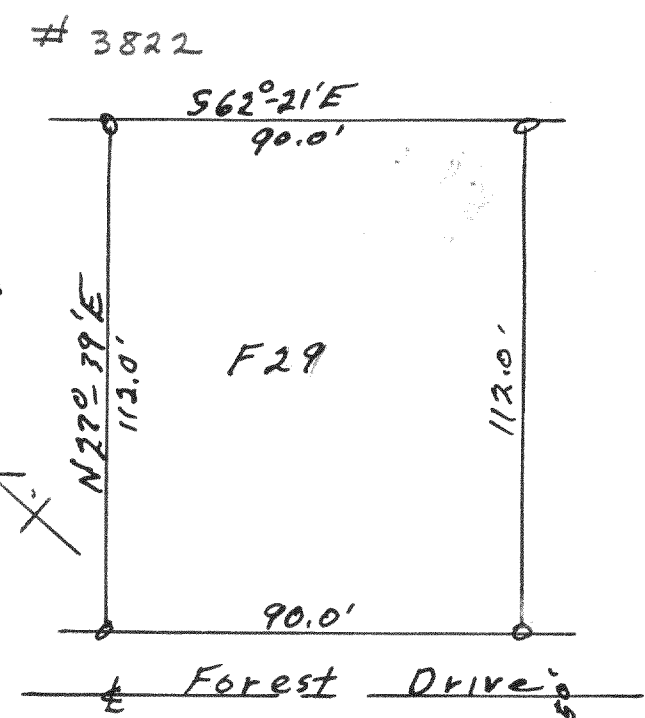


Plat of survey of Lot 29 add
F to Country Club Estates, Village
of Fontana, Walworth County Wisconsin
July 1959 Lloyd L. Jensen
County Surveyor

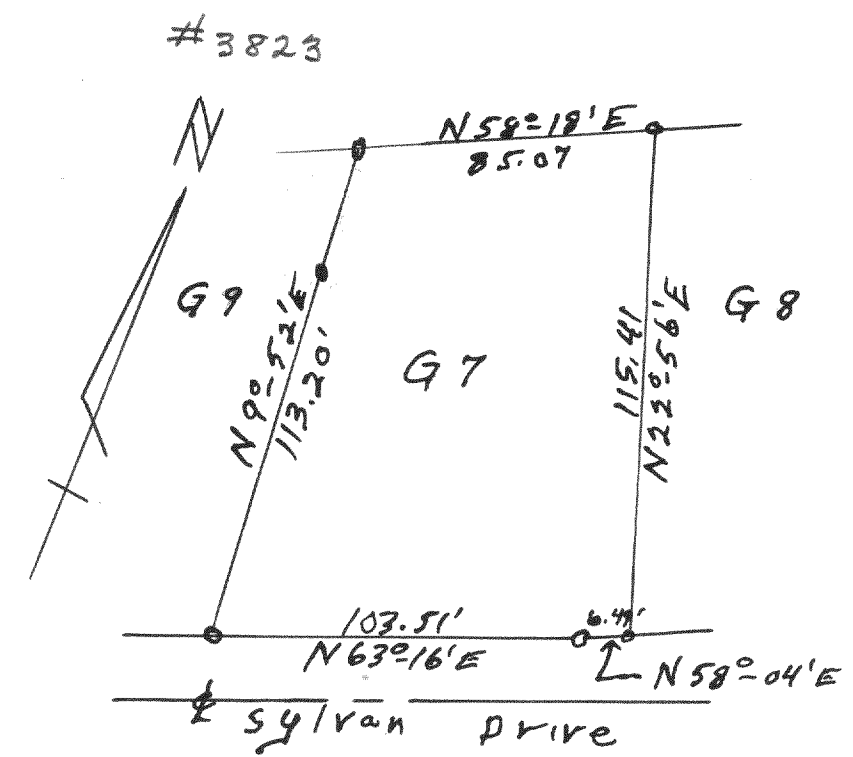


Plat of survey of
Lot G-7 Add. G to Country
Club Estates, Village
of Fontana, Walworth
County Wisconsin.
Sept. Lloyd L. Jensen
1959 County Surveyor

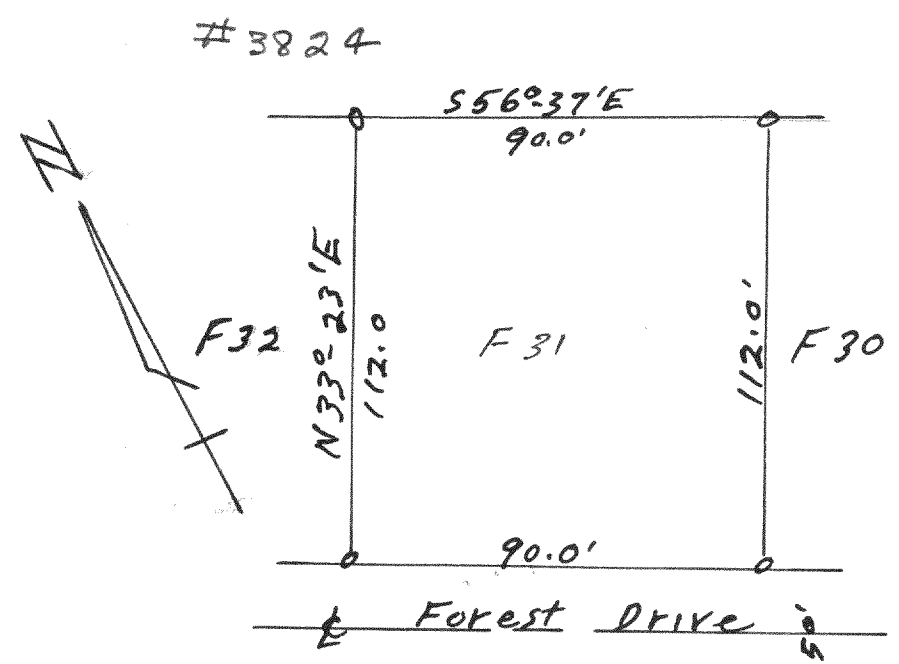


Plat of survey of Lot F31
add. F to Country Club Estates
Village of Fontana, Walworth
County Wisconsin Lloyd L. Jensen
July 1959 County Surveyor

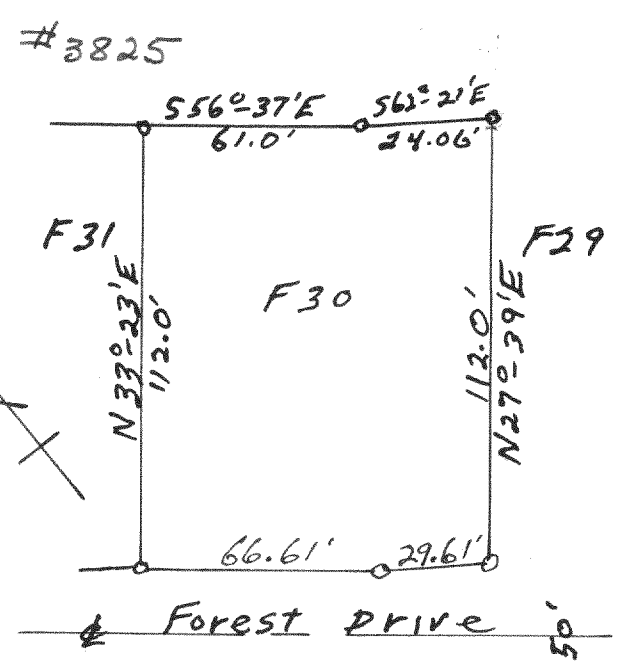

Plat of survey of Lot
F-30 Add. F to Country
Club Estates, Village
of Fontana, Walworth
County, Wisconsin
Sept. Lloyd L. Jensen
1959 County Surveyor

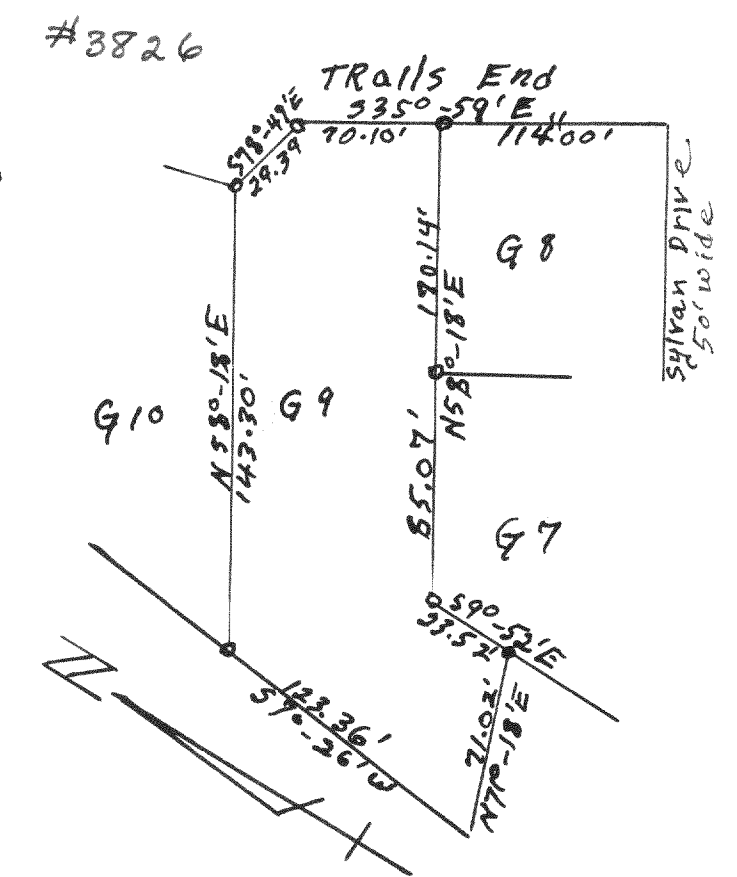

Plat of survey of
Lot G-9 Add. G to Country
Club Estates, Village of
Fontana, Walworth County
Wisconsin. Oct. 1959
Lloyd L. Jensen
County Surveyor

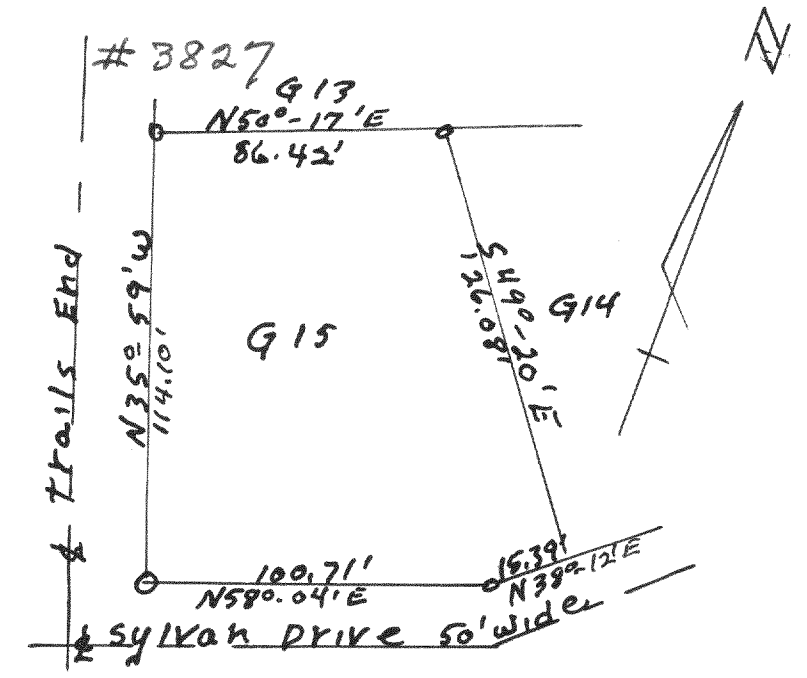

Plat of survey of
Lot G15 Add. G to Country
Club Estates, Village of
Fontana, Walworth County
Wisconsin. Oct 1959
Lloyd L. Jensen
County Surveyor