



#3863

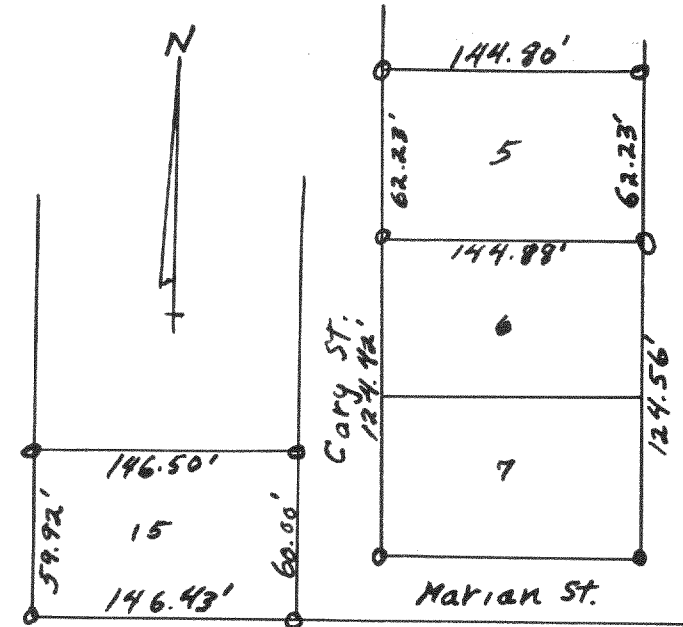


Survey of Lots 5 + 15, Tony + Julia
Peters Subd, City of Lake Geneva,
Wal. Co. Wisconsin

#3864

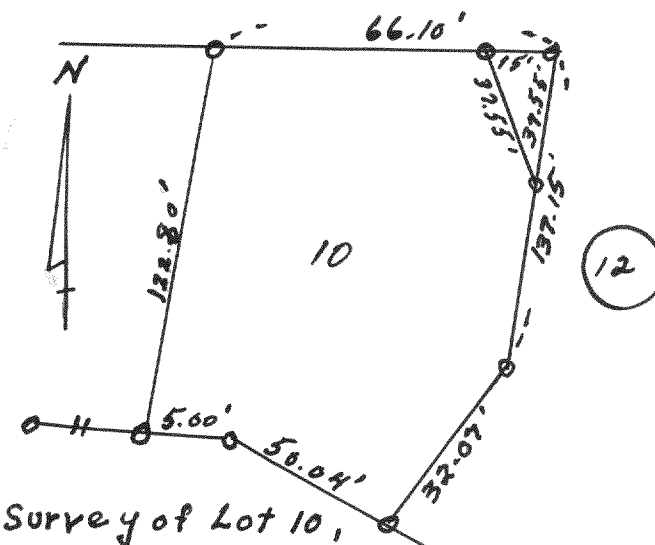

Survey of Lot 10,
Block 12, Lake Geneva
Manor, City of Lake Geneva,
Wal. Co. Wisconsin


#3865

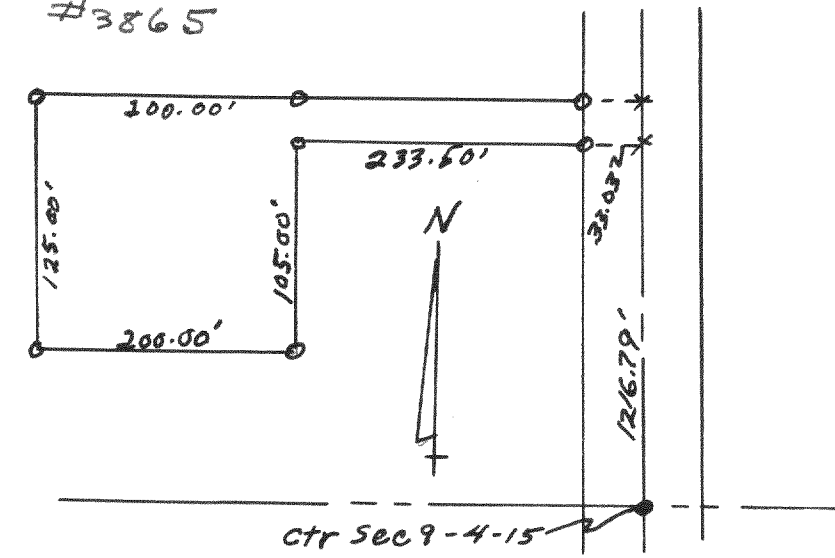

Survey in NW 1/4 Sec 9, T4N, R15E, City
of Whitewater, Wal. Co. Wisconsin

Lloyd L. Jensen
County Surveyor


#3866

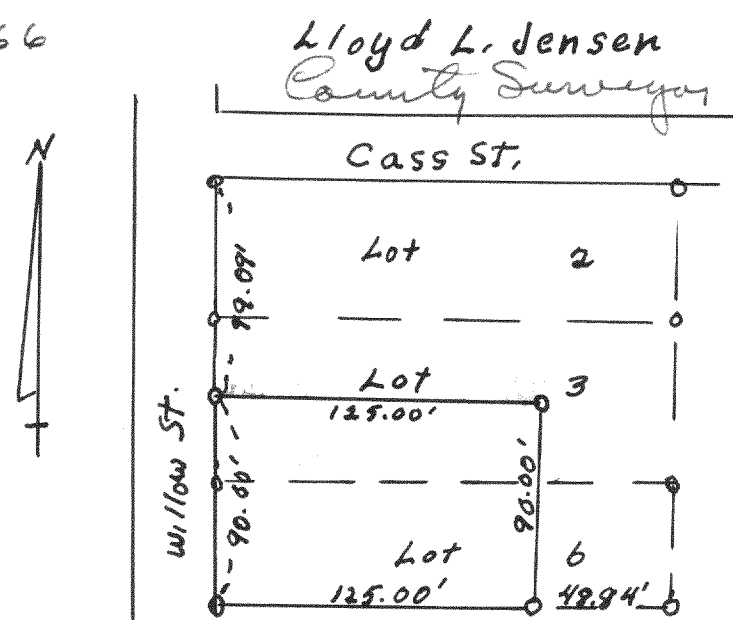

Survey of part of Lot 3 + 6, BIK 35,
orig. plat of City of Lake Geneva
Wal. Co. Wisconsin

Lloyd L. Jensen
County Surveyor


#3867

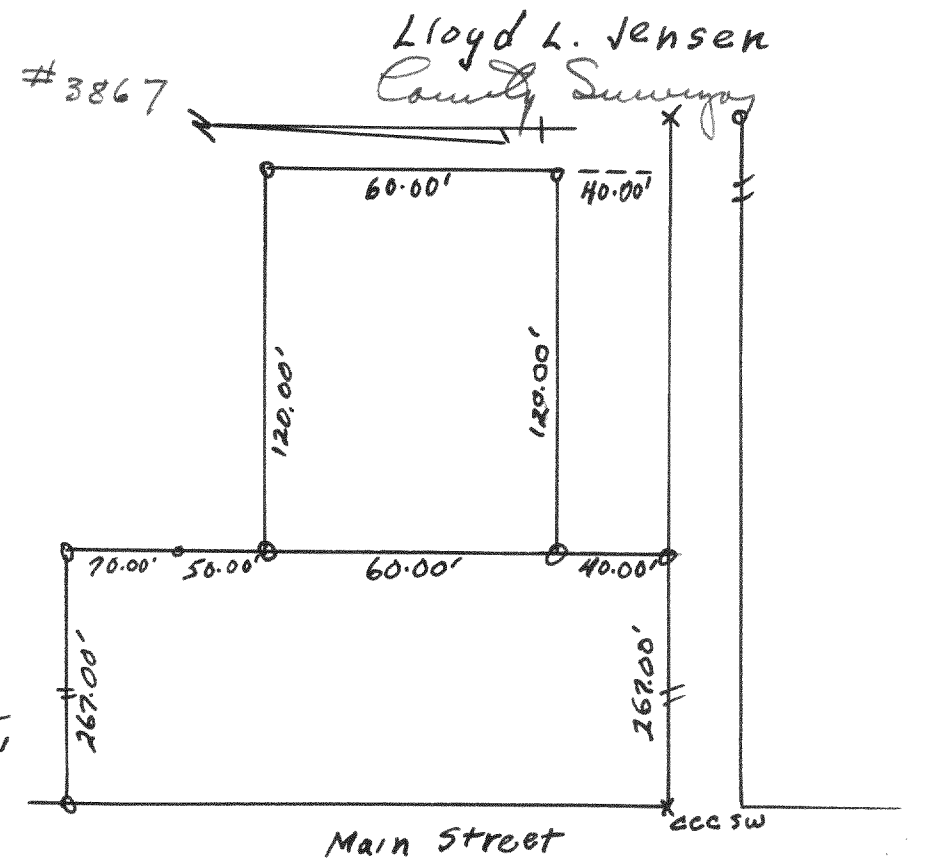

Survey of O.L. 110 + 111 V.I. of Walworth
Wal. Co. Wisconsin

Lloyd L. Jensen
County Surveyor

#3868

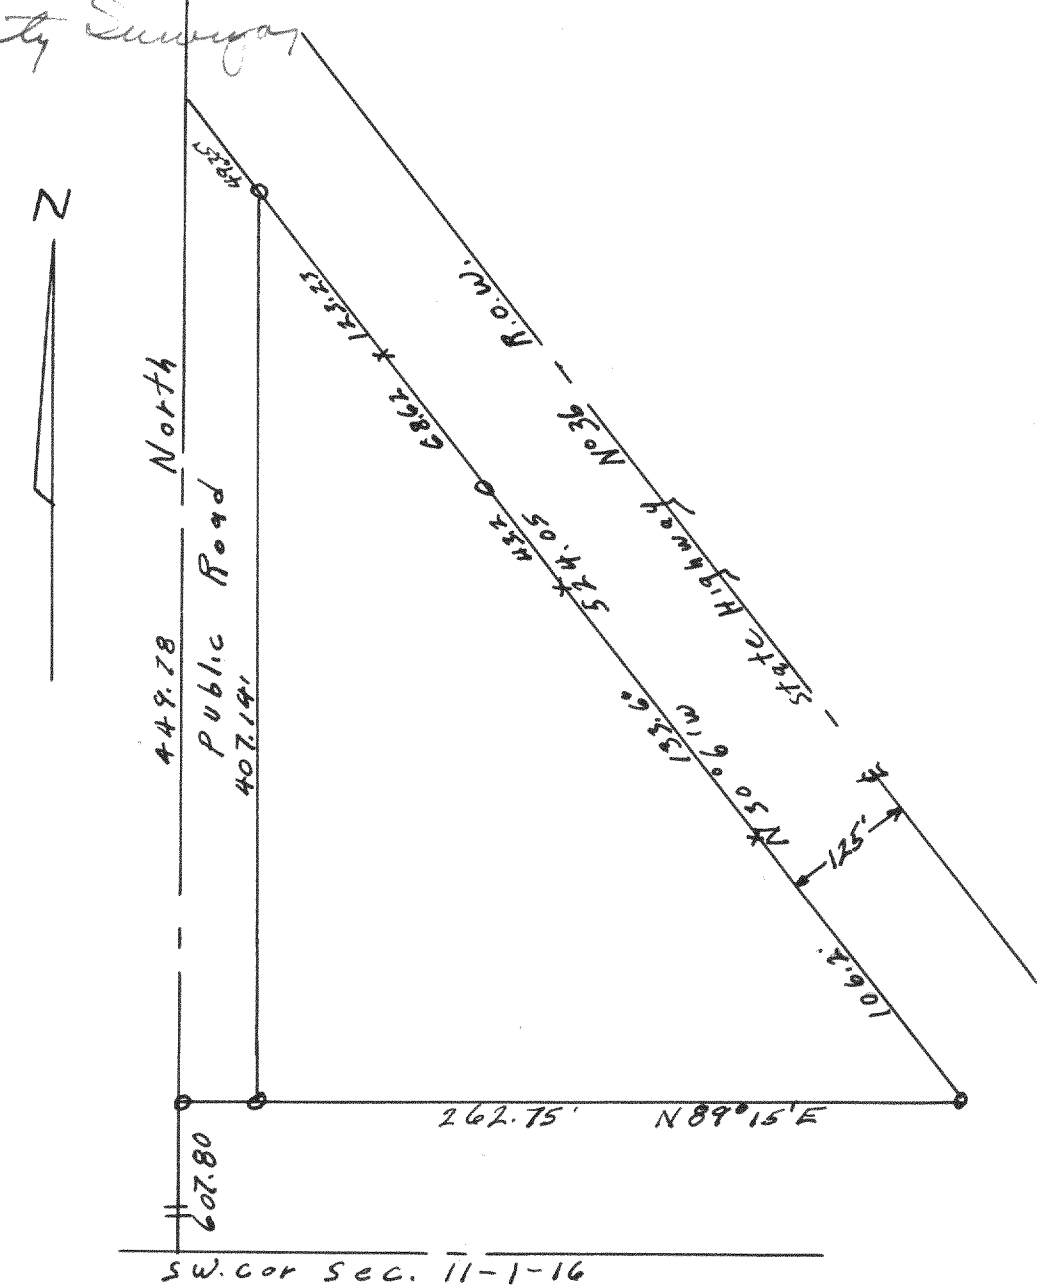

Survey in the Southwest quarter
of Section 11 T1N R16E
Walworth Co. Wisconsin

Lloyd L. Jensen
County Surveyor