


#3889

Plat of survey of a parcel
of land located in the SE 1/4
of section 22, T2N R18E town
of Delavan, Walworth County
Wisconsin Sep. 1960


Lloyd S. Jensen
County Surveyor

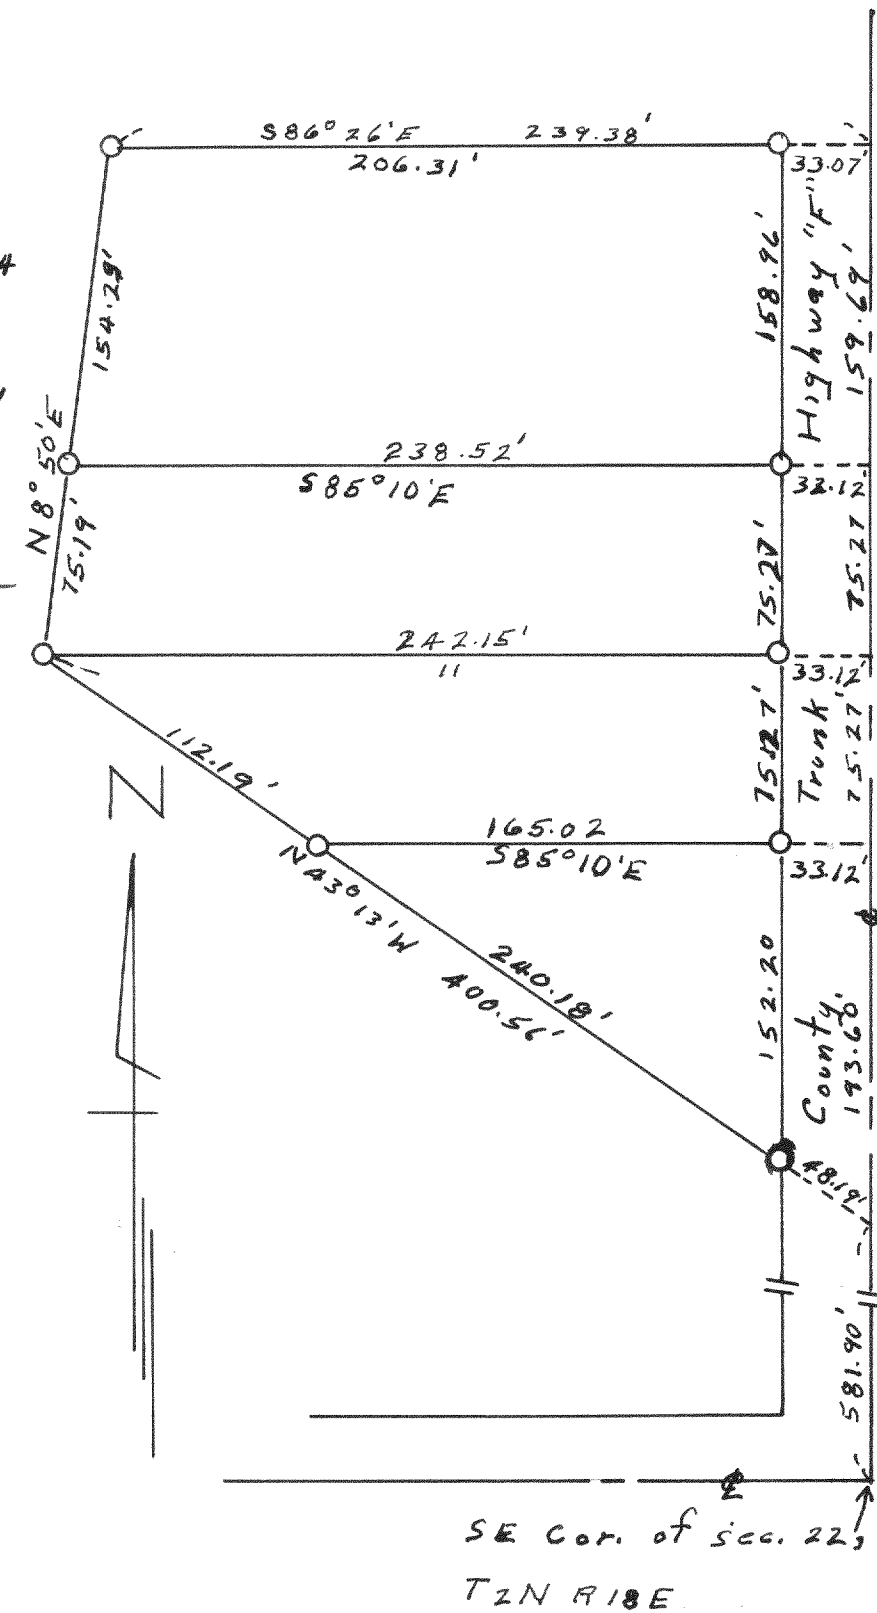

#3891

Plat of survey of a parcel
of land located in the
SE 1/4 of the SE 1/4 of
Section 33, T1N R16E
Walworth County, Wisconsin
Aug. 1960

Lloyd S. Jensen
County Surveyor

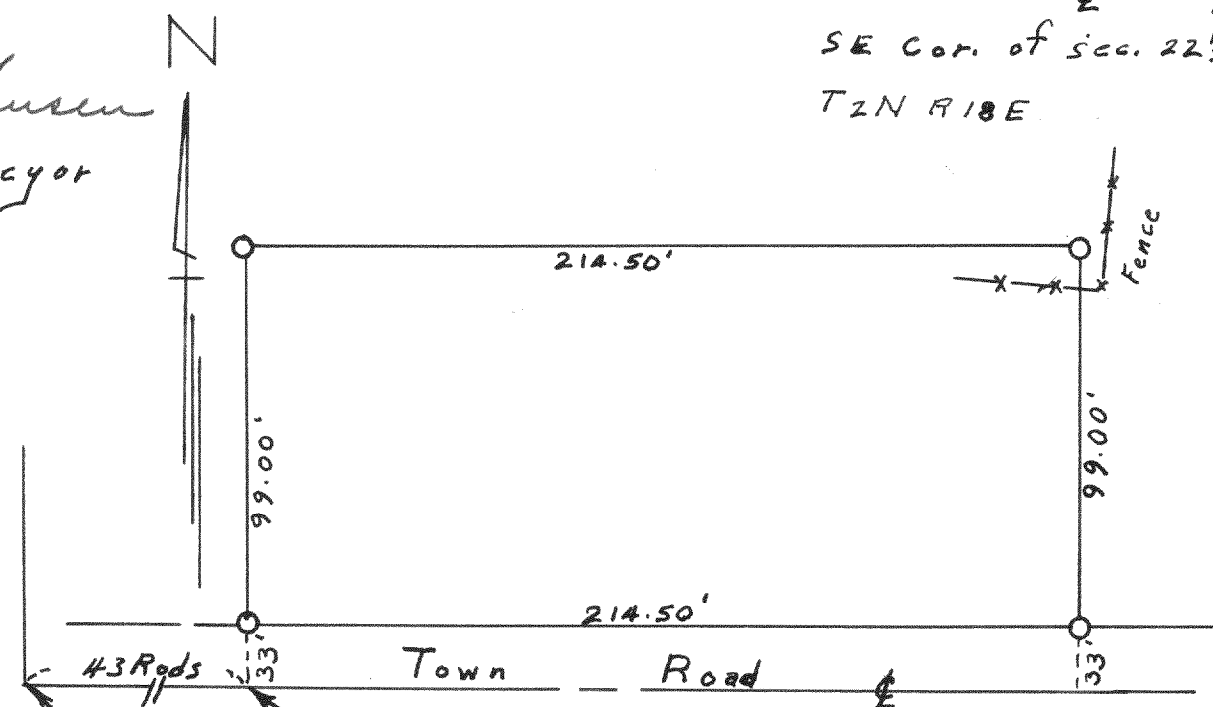


SE Cor. of the SE 1/4
of the SE 1/4 of Section
33, T1N R16E

709.5' East of South West Cor.
of the SE 1/4 of the SE 1/4 of
Section 33, T1N R16E

#3890

Plat of survey of lots
4 and 5 Ceylon Court
Estates, City of
Lake Geneva
Walworth County,
Wisconsin July 1960
Lloyd S. Jensen
County Surveyor

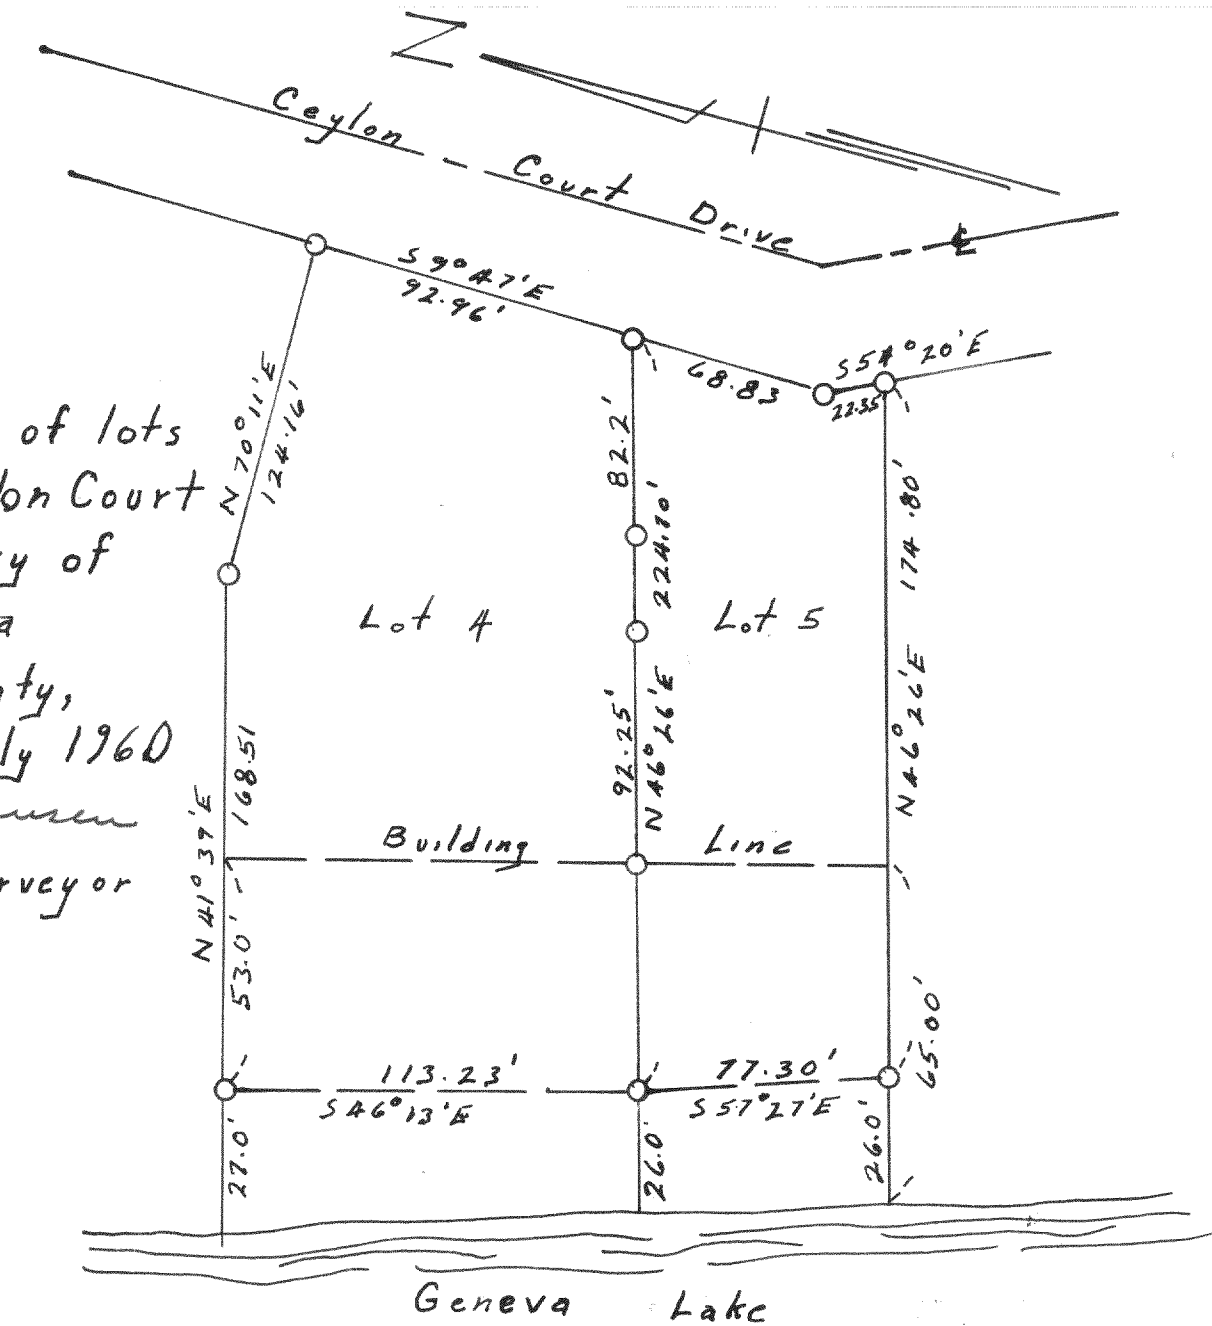

North 1/4 corner

#3892

Plat of survey of a parcel
of land located in the
NE 1/4 of the NW 1/4
and NW 1/4 NE 1/4
of Section 28 T3N R16E
Walworth County
Wisconsin Feb 1960

Lloyd S. Jensen
County Surveyor

