




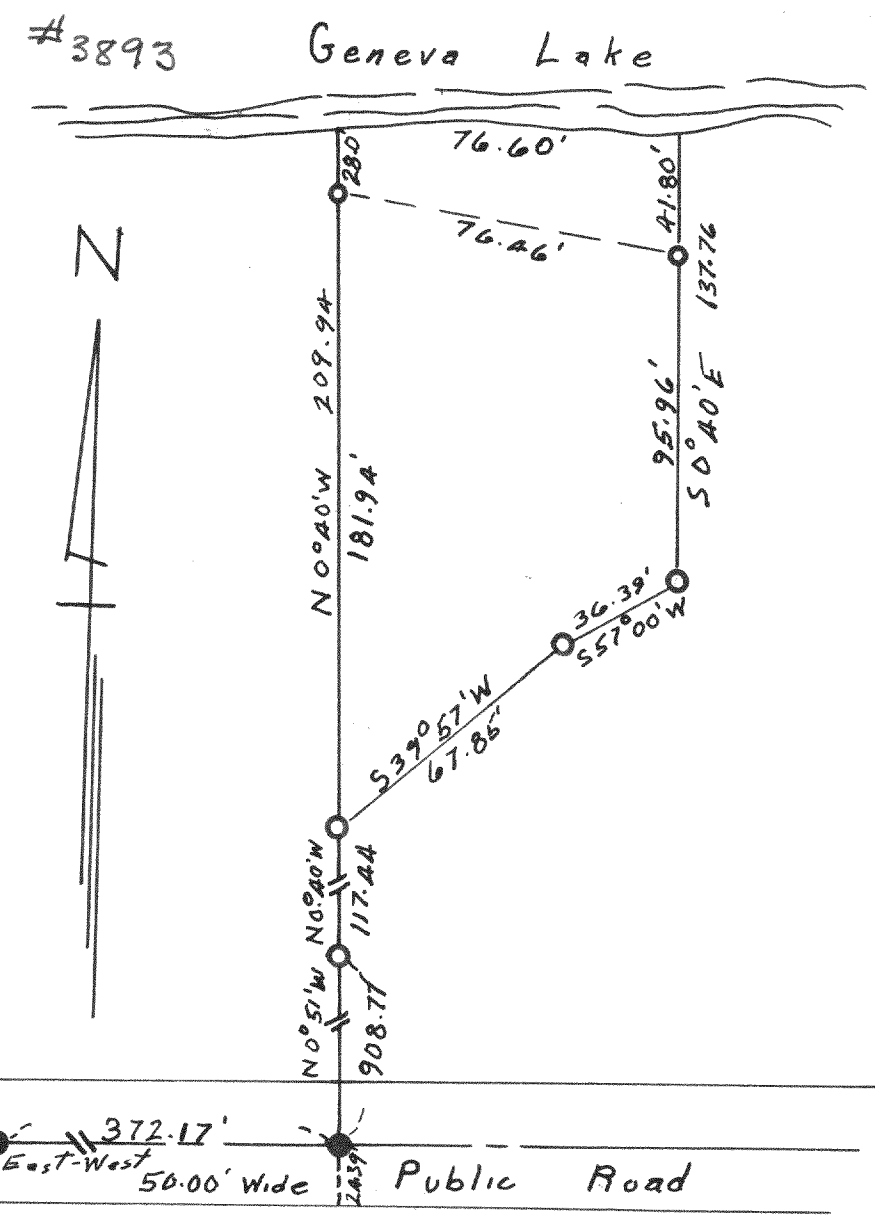


Plat of survey of A parcel of land located in the NW 1/4 of section 18, T1N R1E Walworth County Wisconsin Oct. 1960
Lloyd L Jensen
County Surveyor

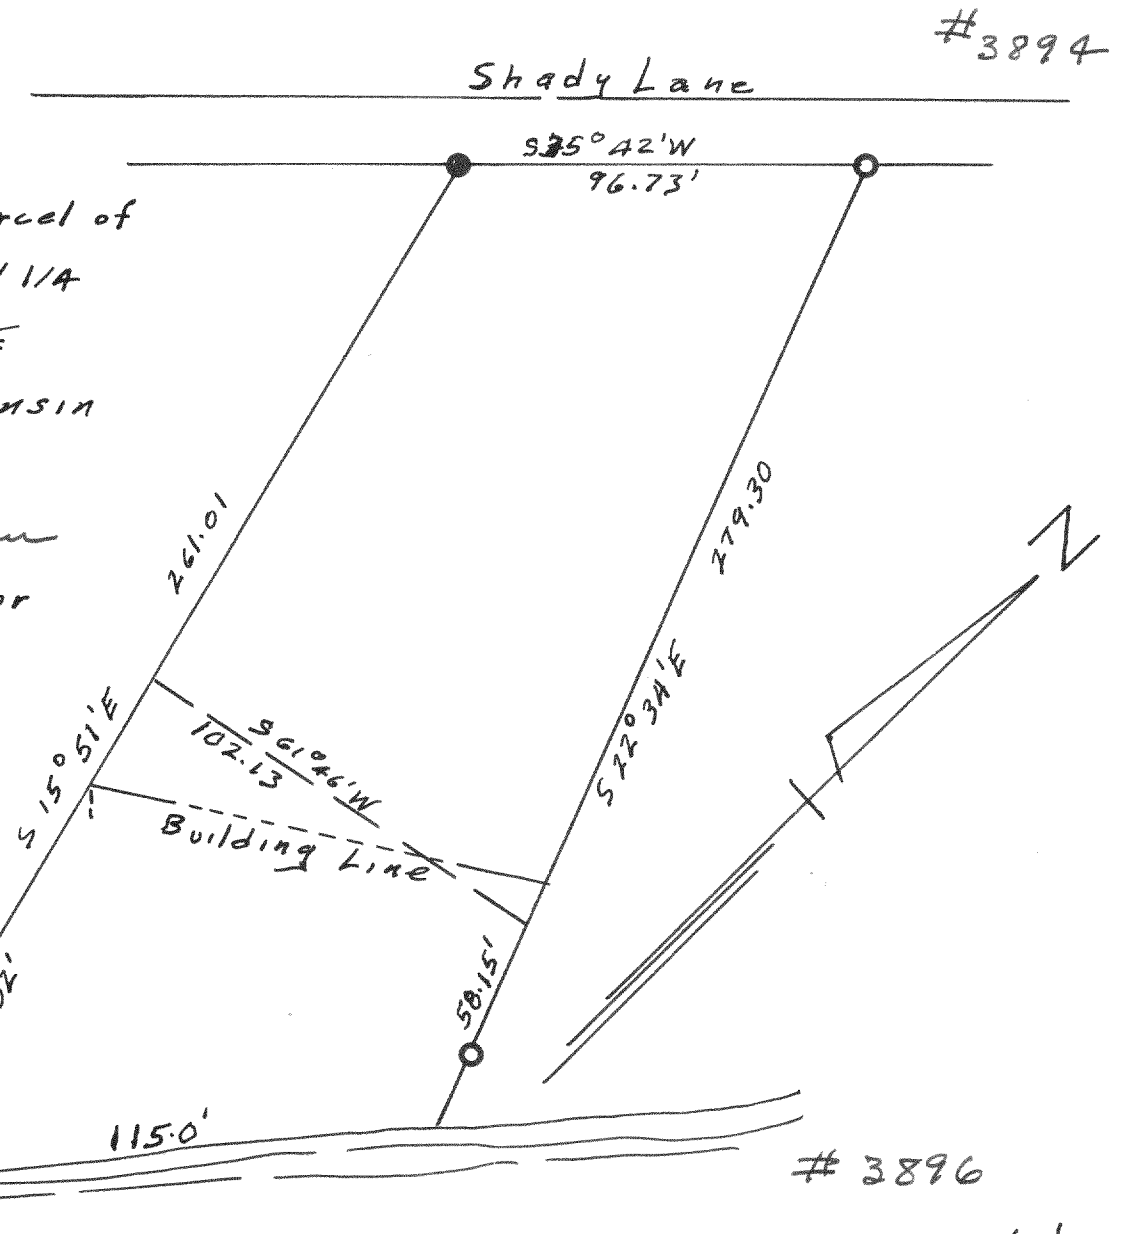

Plat of survey of Ground elevations of Lot 2, Block 1 Forest Rest Subdivision Walworth County Wisconsin OCT 1960
Lloyd L Jensen
County Surveyor

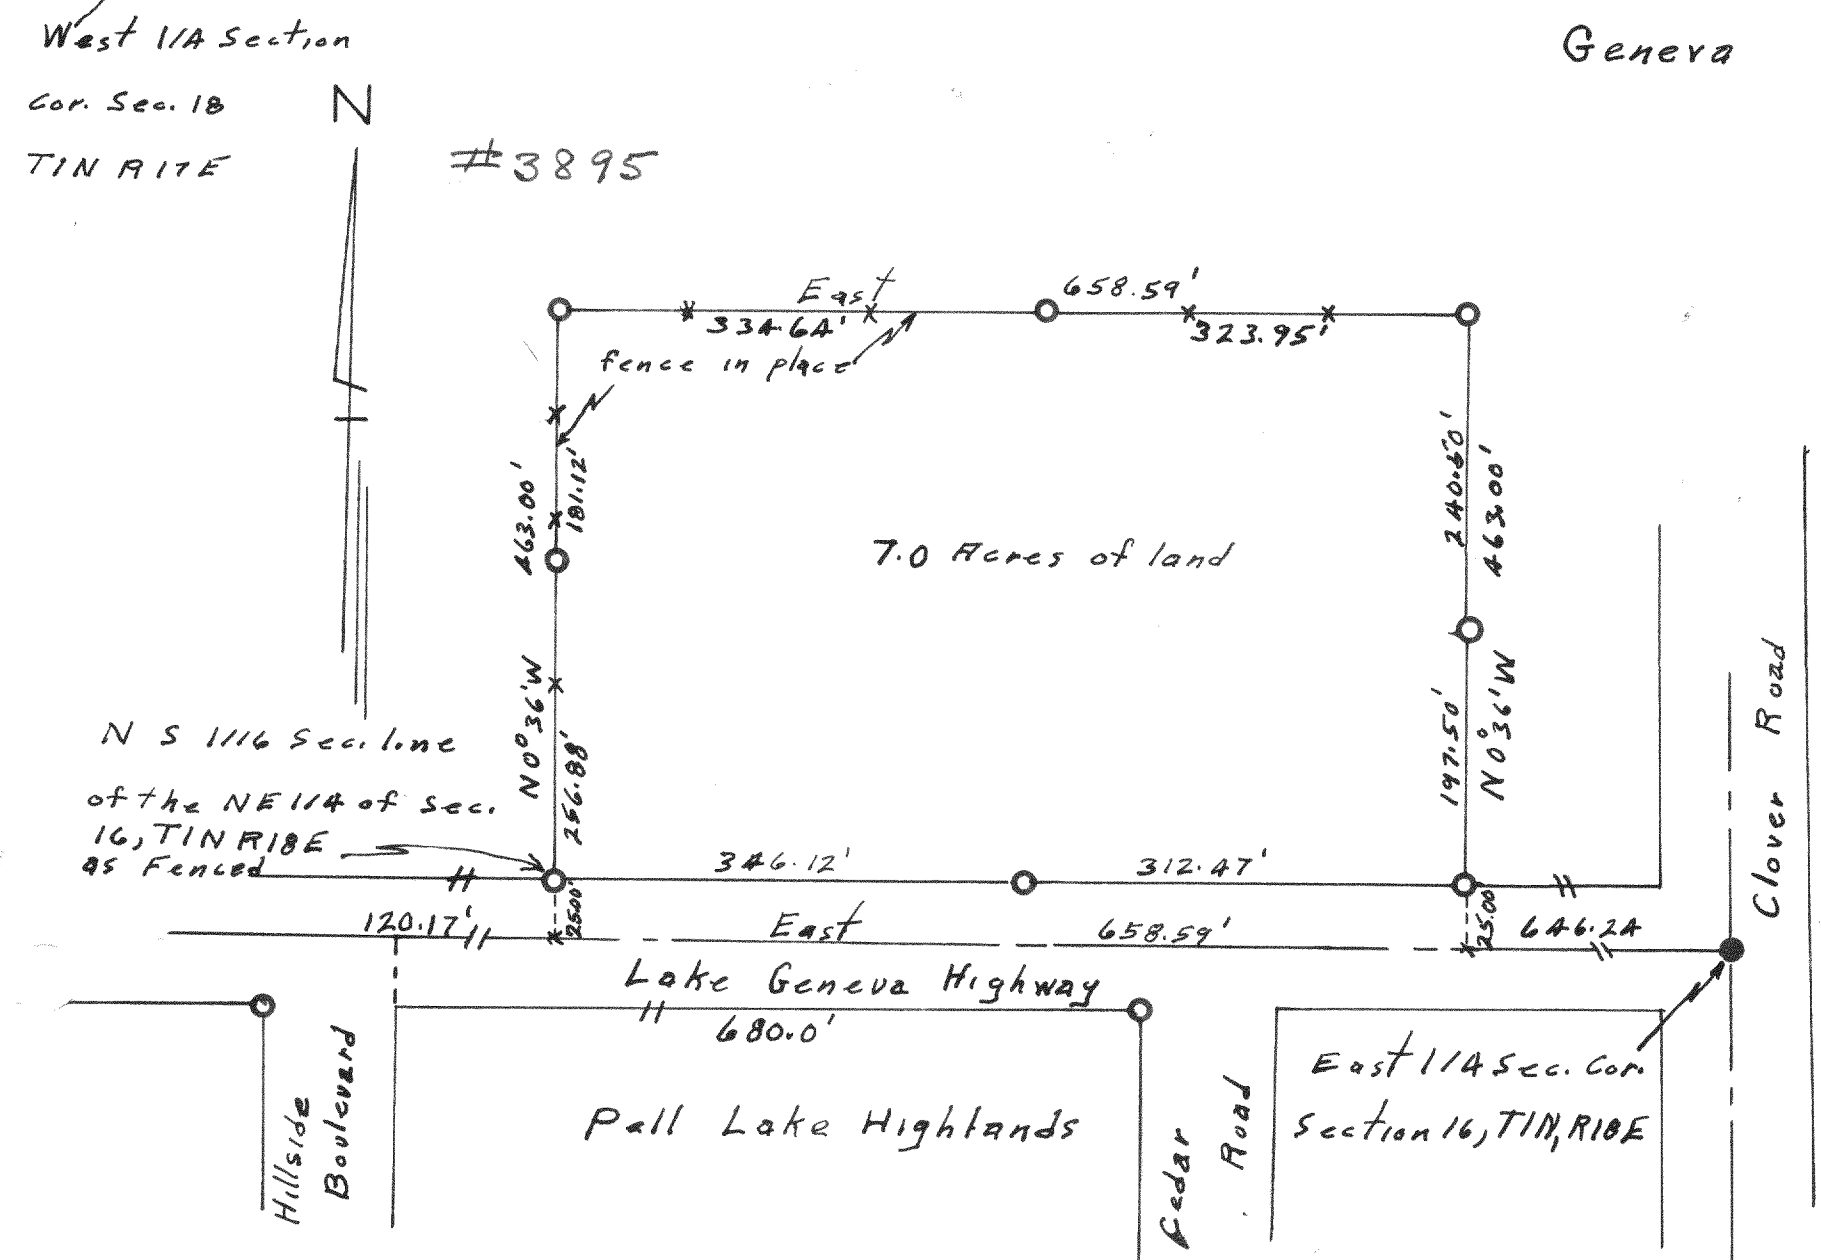

Plat of survey of A parcel of Land located in the NE 1/4 of Section 16 T1N R1E Walworth County Wisconsin Nov. 1960
Lloyd L Jensen
County Surveyor

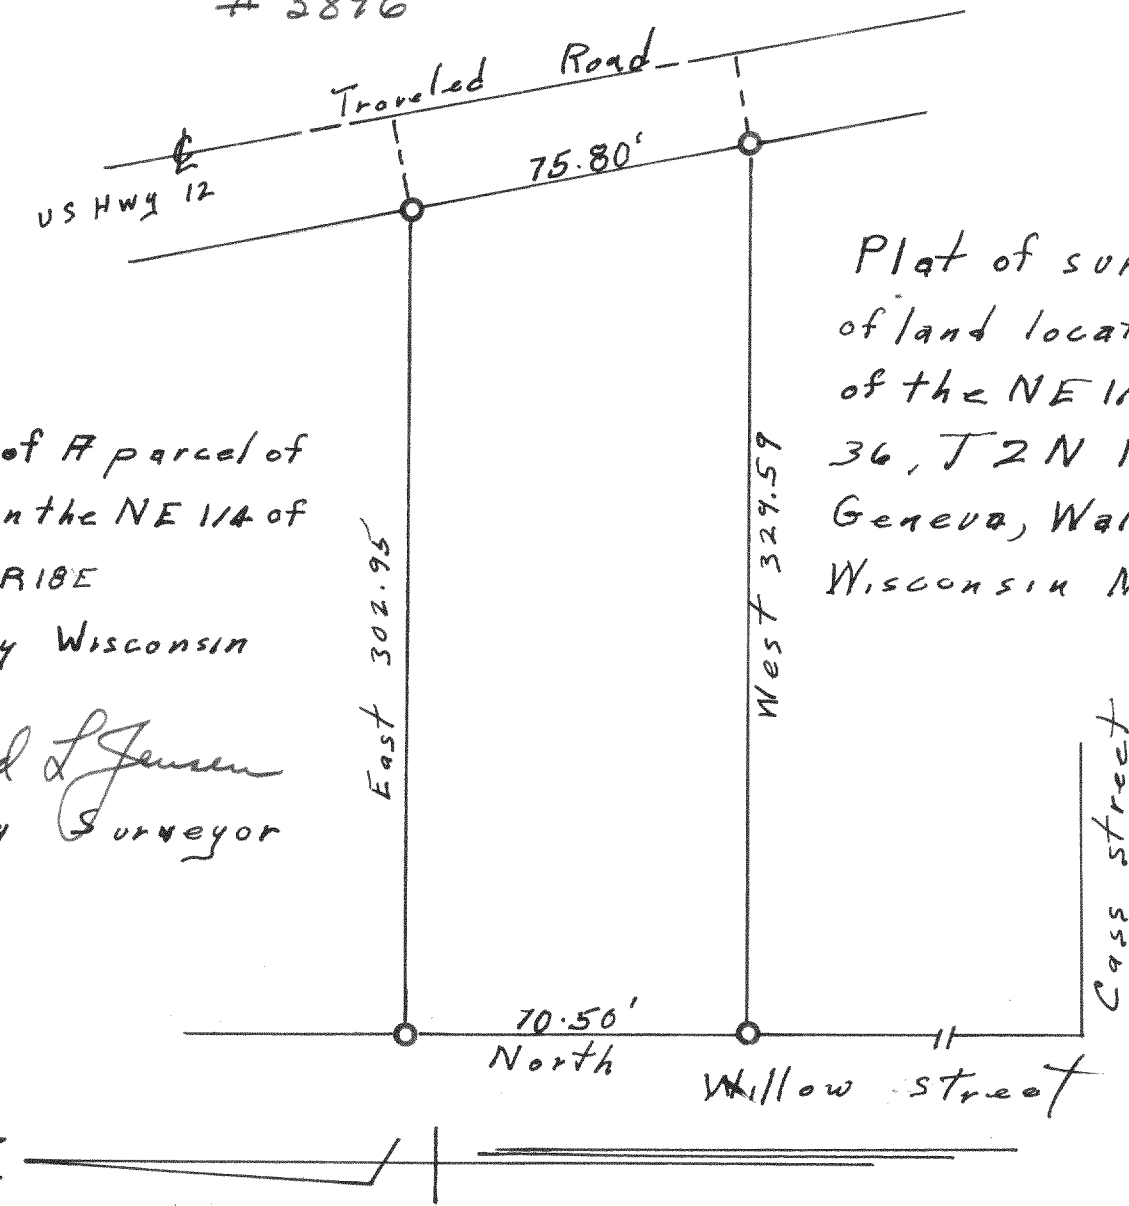

Plat of survey of A parcel of land located in the SW 1/4 of the NE 1/4 of Section 36, T2N R1E City of Lake Geneva, Walworth County Wisconsin Mar. 1960
Lloyd L Jensen
County Surveyor