


#3913

PLAT OF SURVEY OF
LOTS 2391 THRU 2395, BLOCK 56, MAP
OF SECTION 2, PELL LAKE, T1N, R1E,
WALWORTH COUNTY, WISCONSIN.

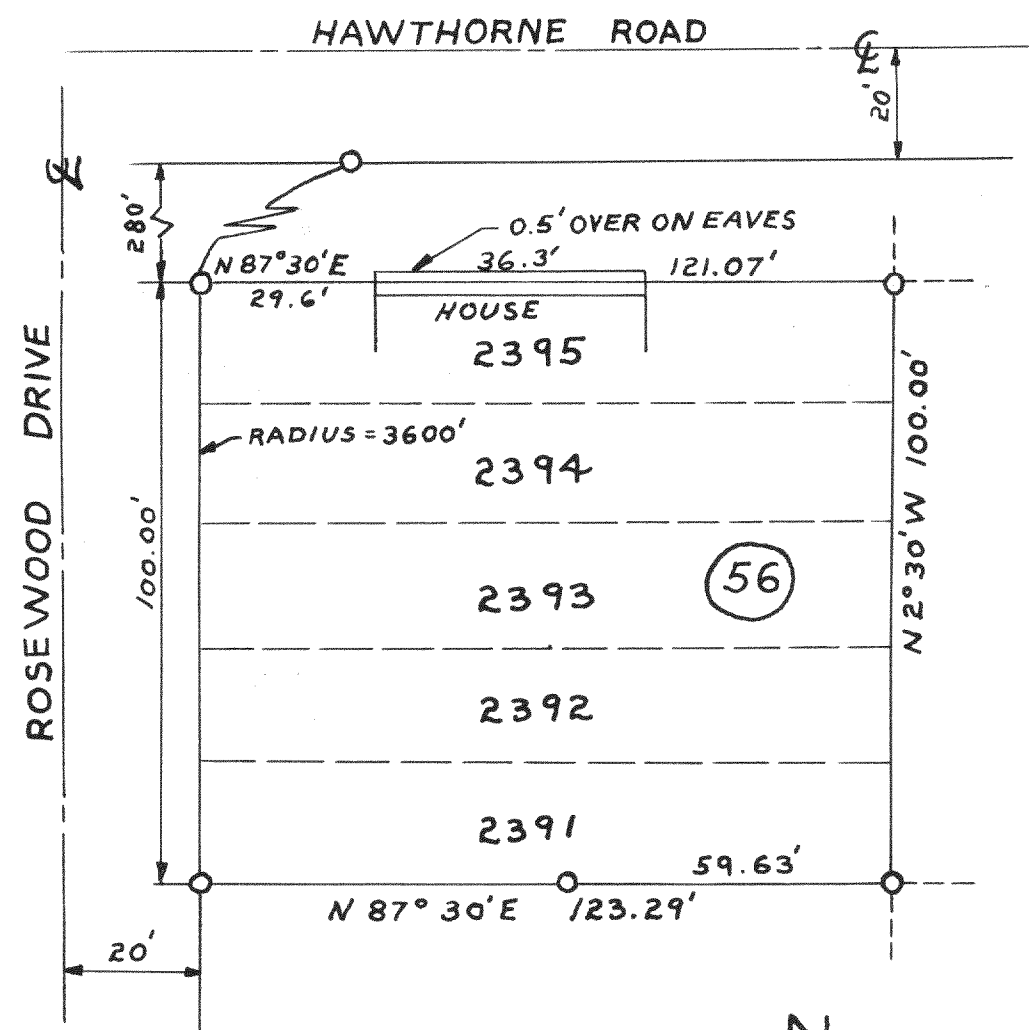


AUGUST 9, 1960

Lloyd L. Jensen
COUNTY SURVEYOR

#3914

PLAT OF SURVEY OF
LOTS 11732 TO 11736 INCLUSIVE, BLOCK 211,
LAKE COMO BEACH, LOCATED IN SECTION 29,
T2N, R1E, WALWORTH COUNTY, WISCONSIN.

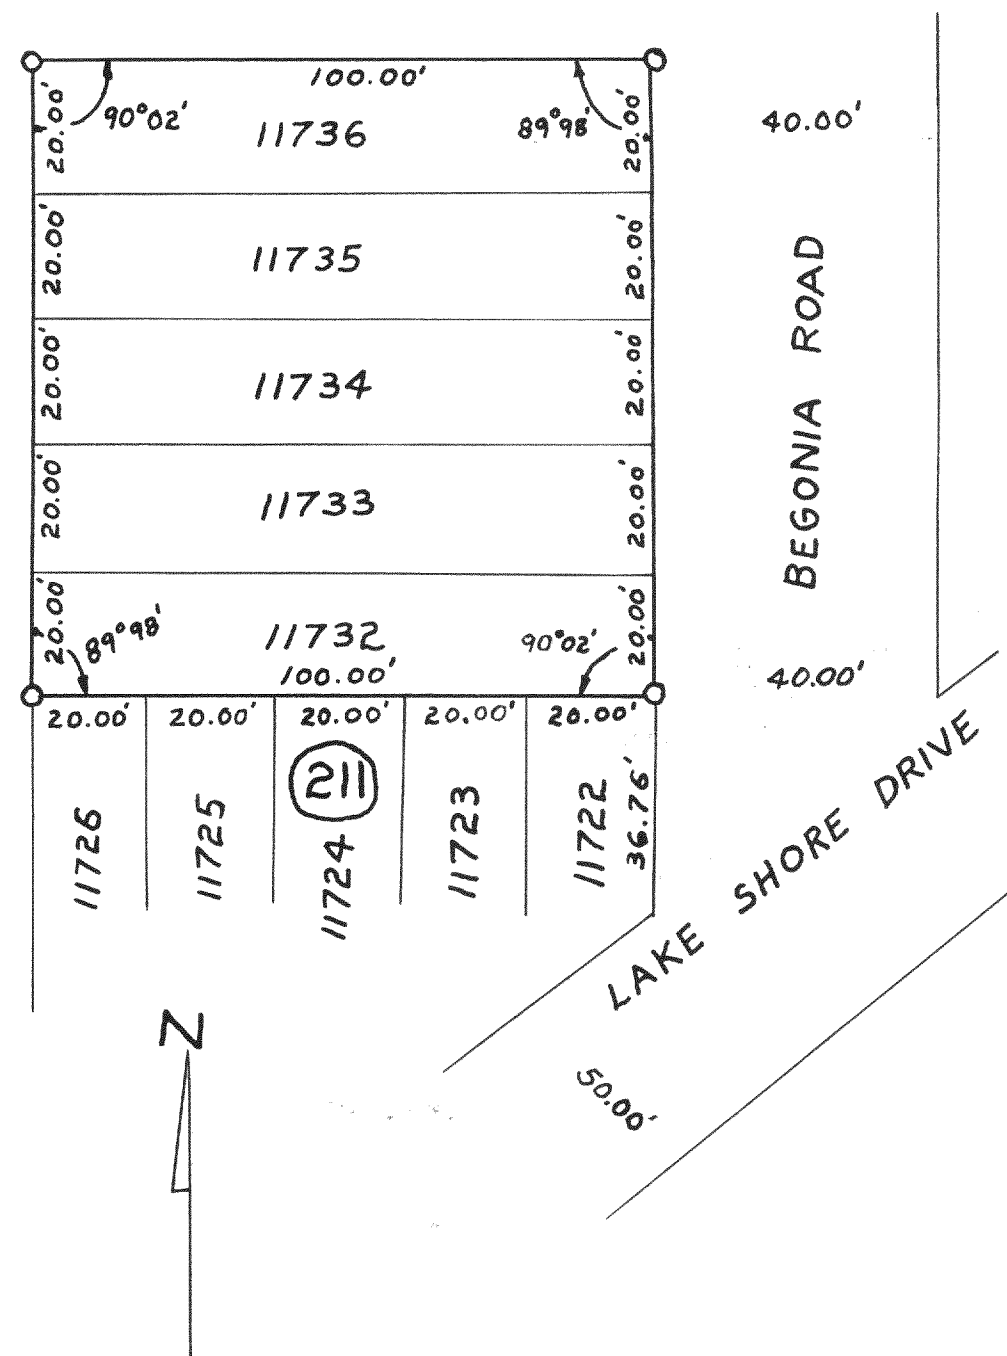


JULY 5, 1960

Lloyd L. Jensen
COUNTY SURVEYOR

#3915

PLAT OF SURVEY OF
LOTS 10378 TO 10383, AND LOT 10353 BLOCK 188,
LAKE COMO BEACH, SECTION 28, T2N, R1E,
TOWN OF GENEVA, WALWORTH COUNTY, WISCONSIN.

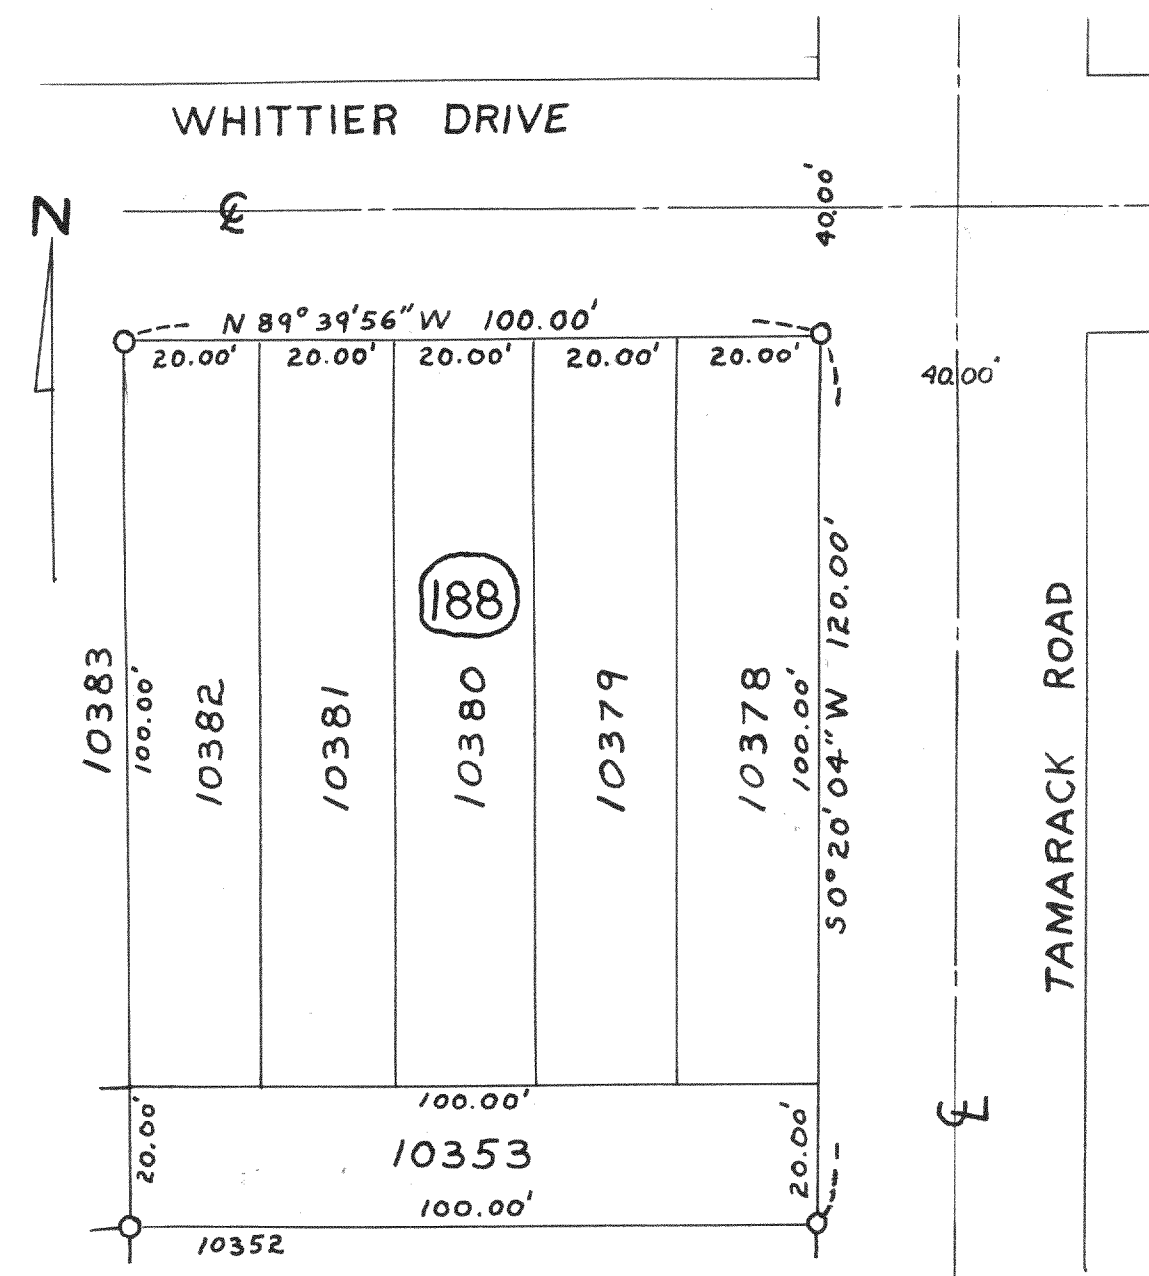

AUGUST, 1960

Lloyd L. Jensen
COUNTY SURVEYOR