


#3937

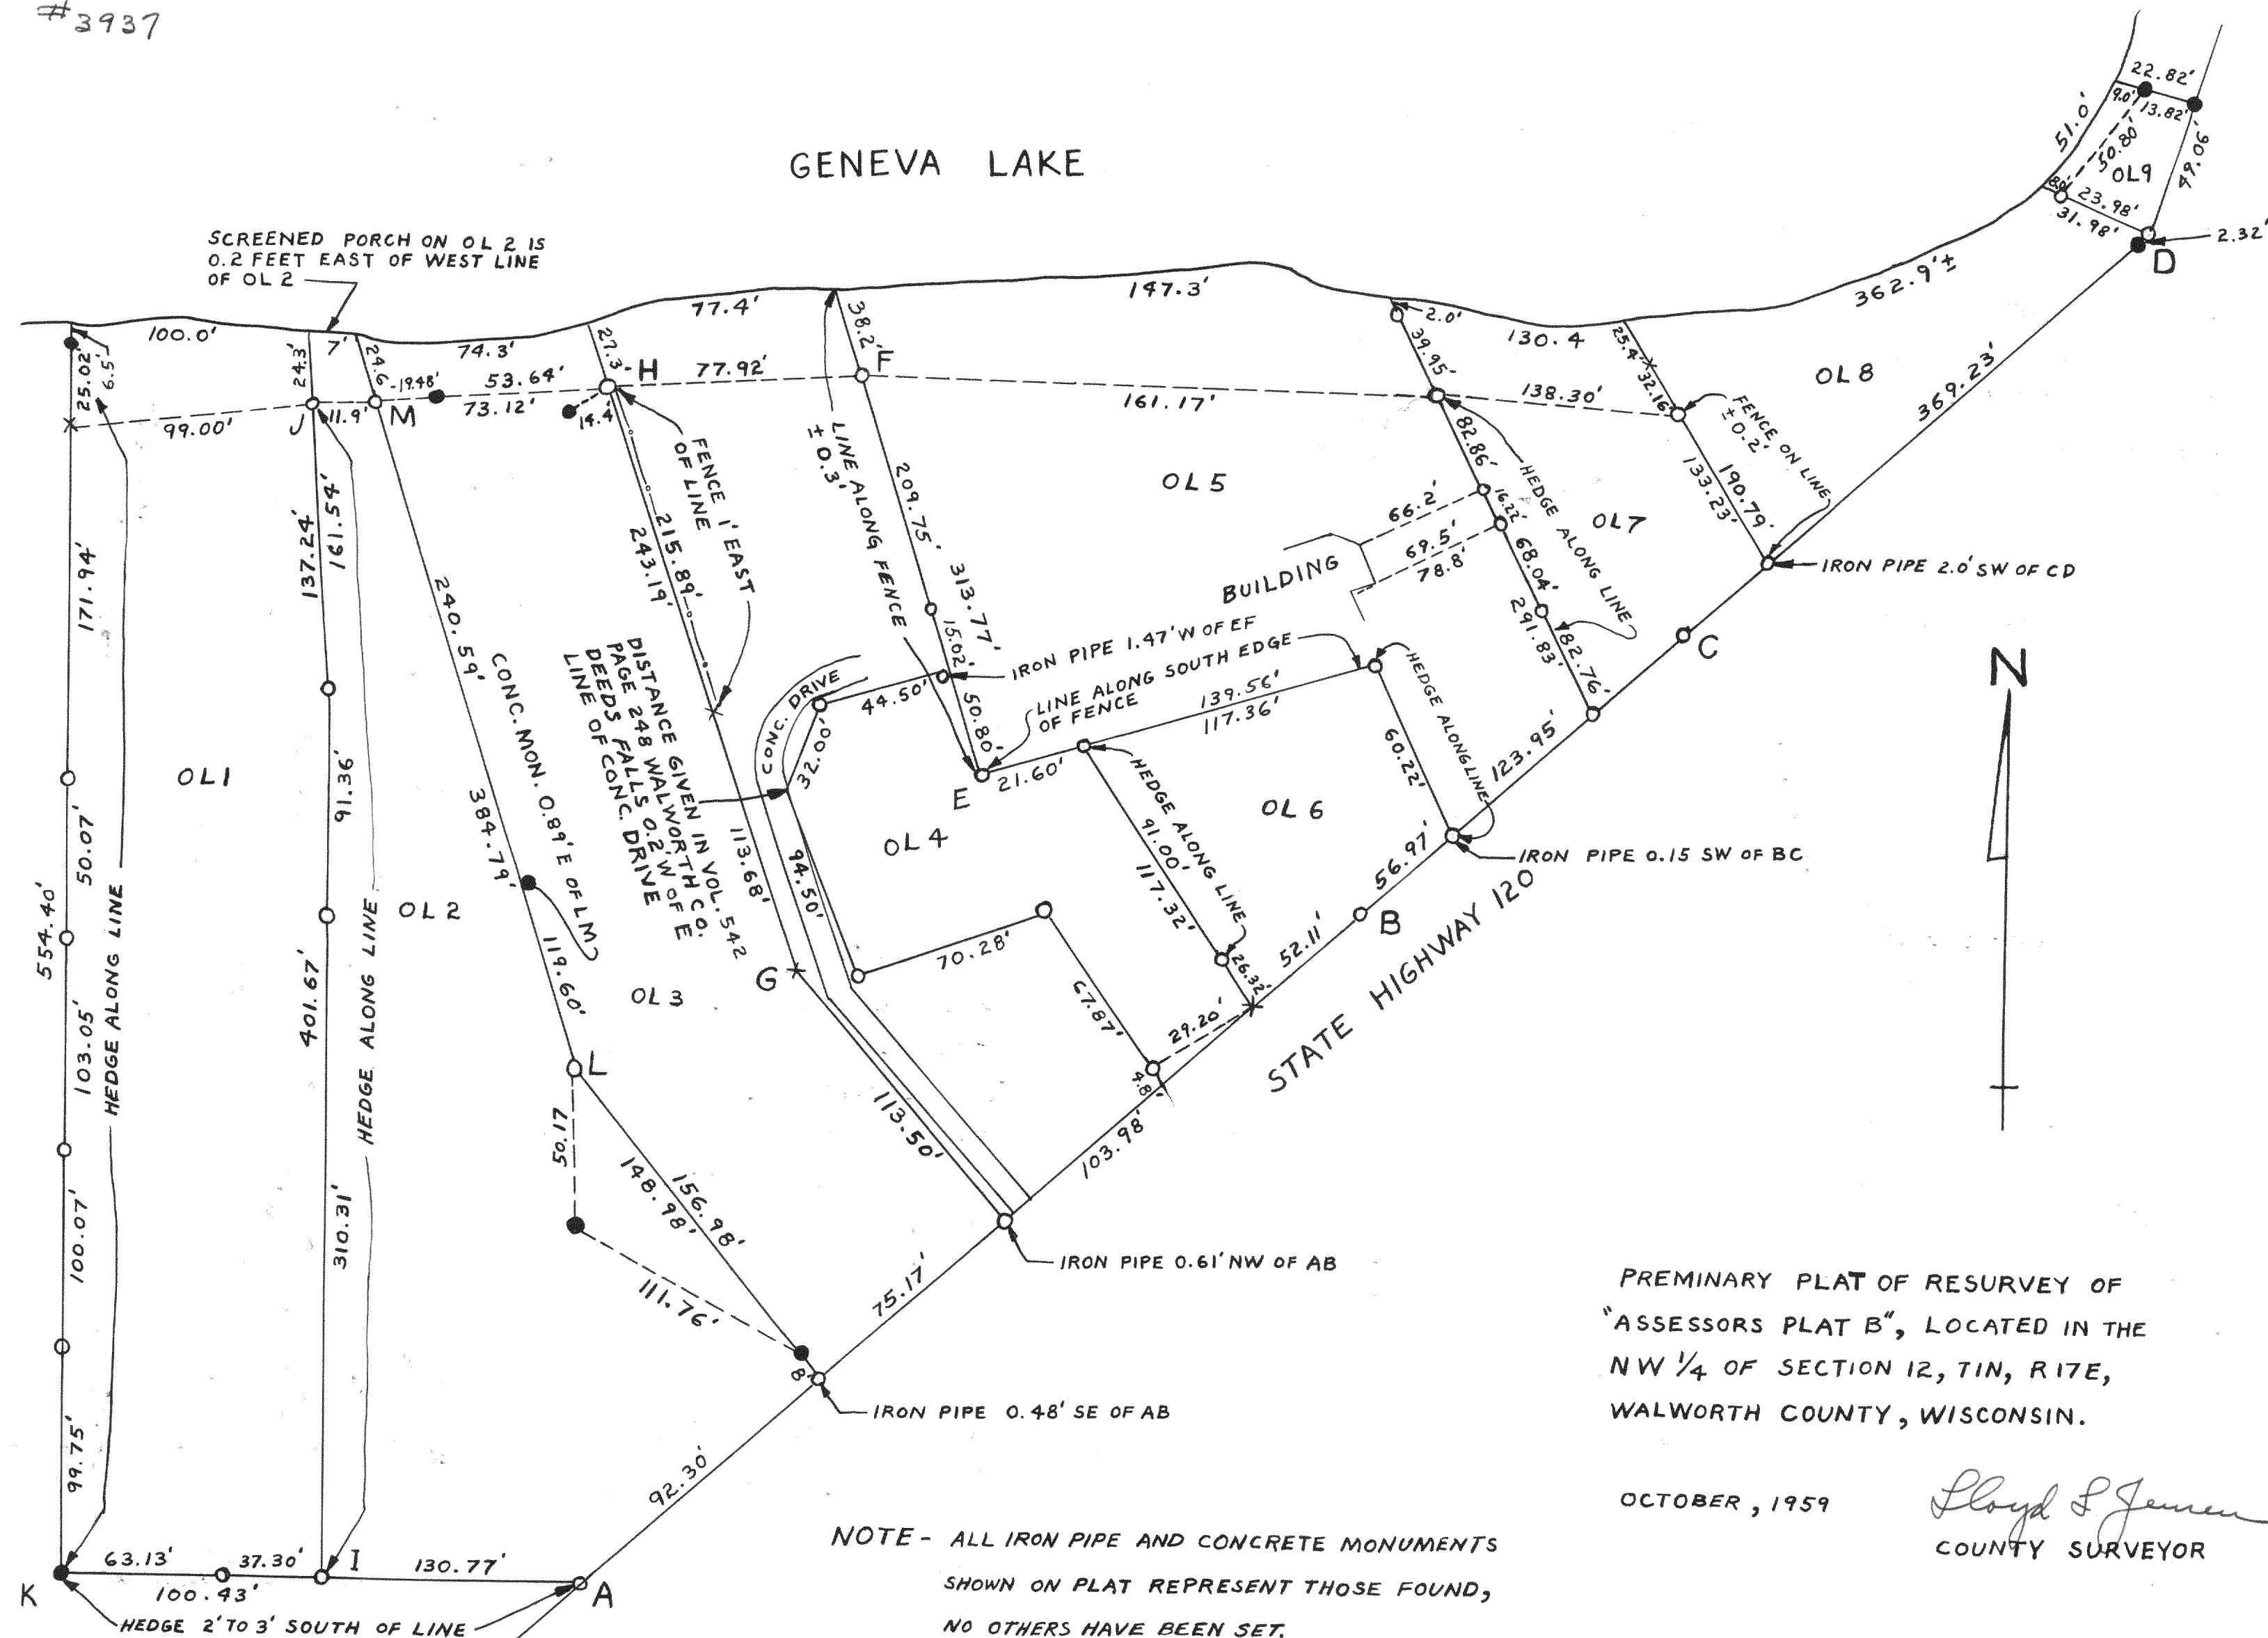

PREMINARY PLAT OF RESURVEY OF
"ASSESSORS PLAT B", LOCATED IN THE
NW 1/4 OF SECTION 12, T1N, R17E,
WALWORTH COUNTY, WISCONSIN.

OCTOBER, 1959

Lloyd S. Jensen
COUNTY SURVEYOR