




#3988

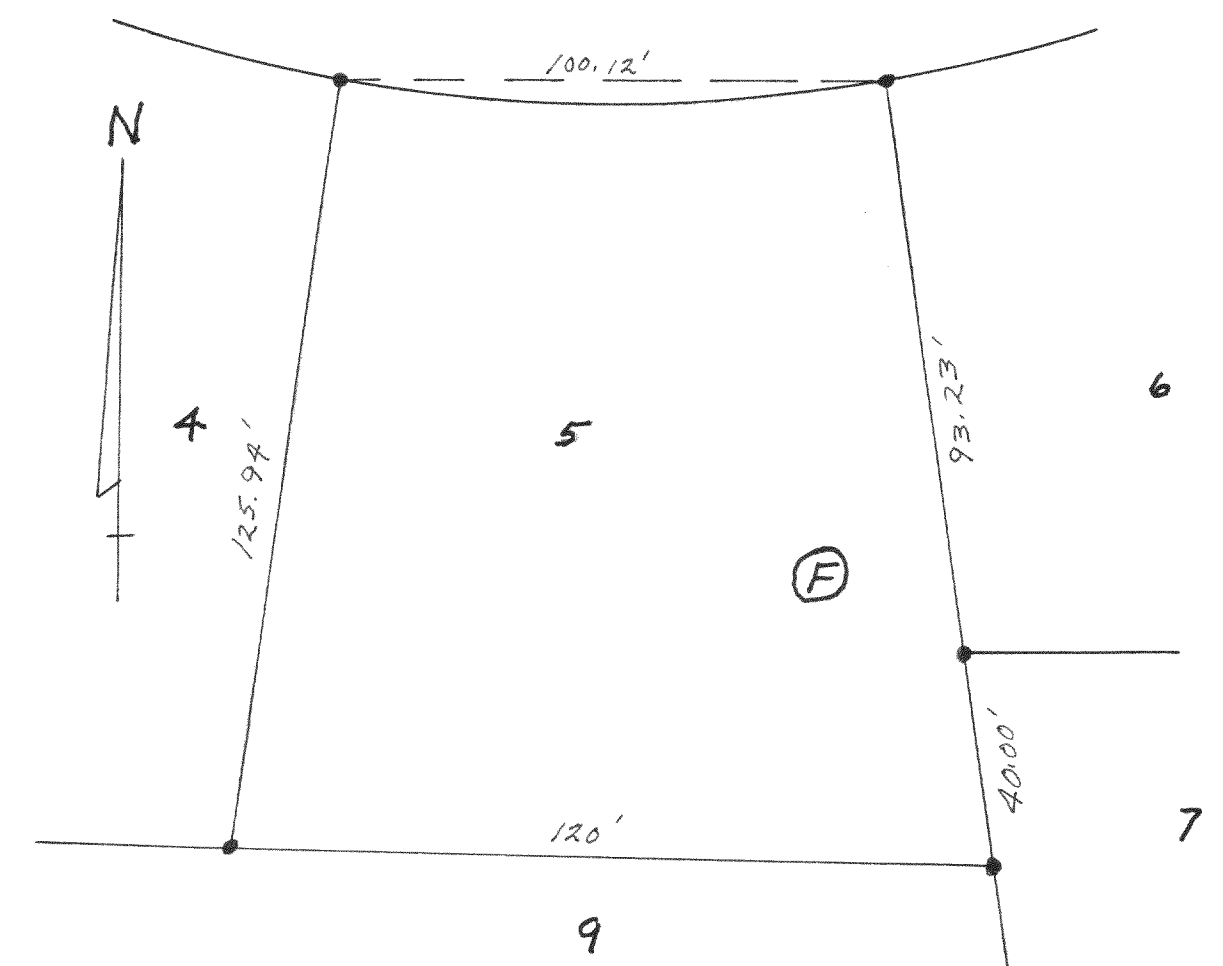

#3989

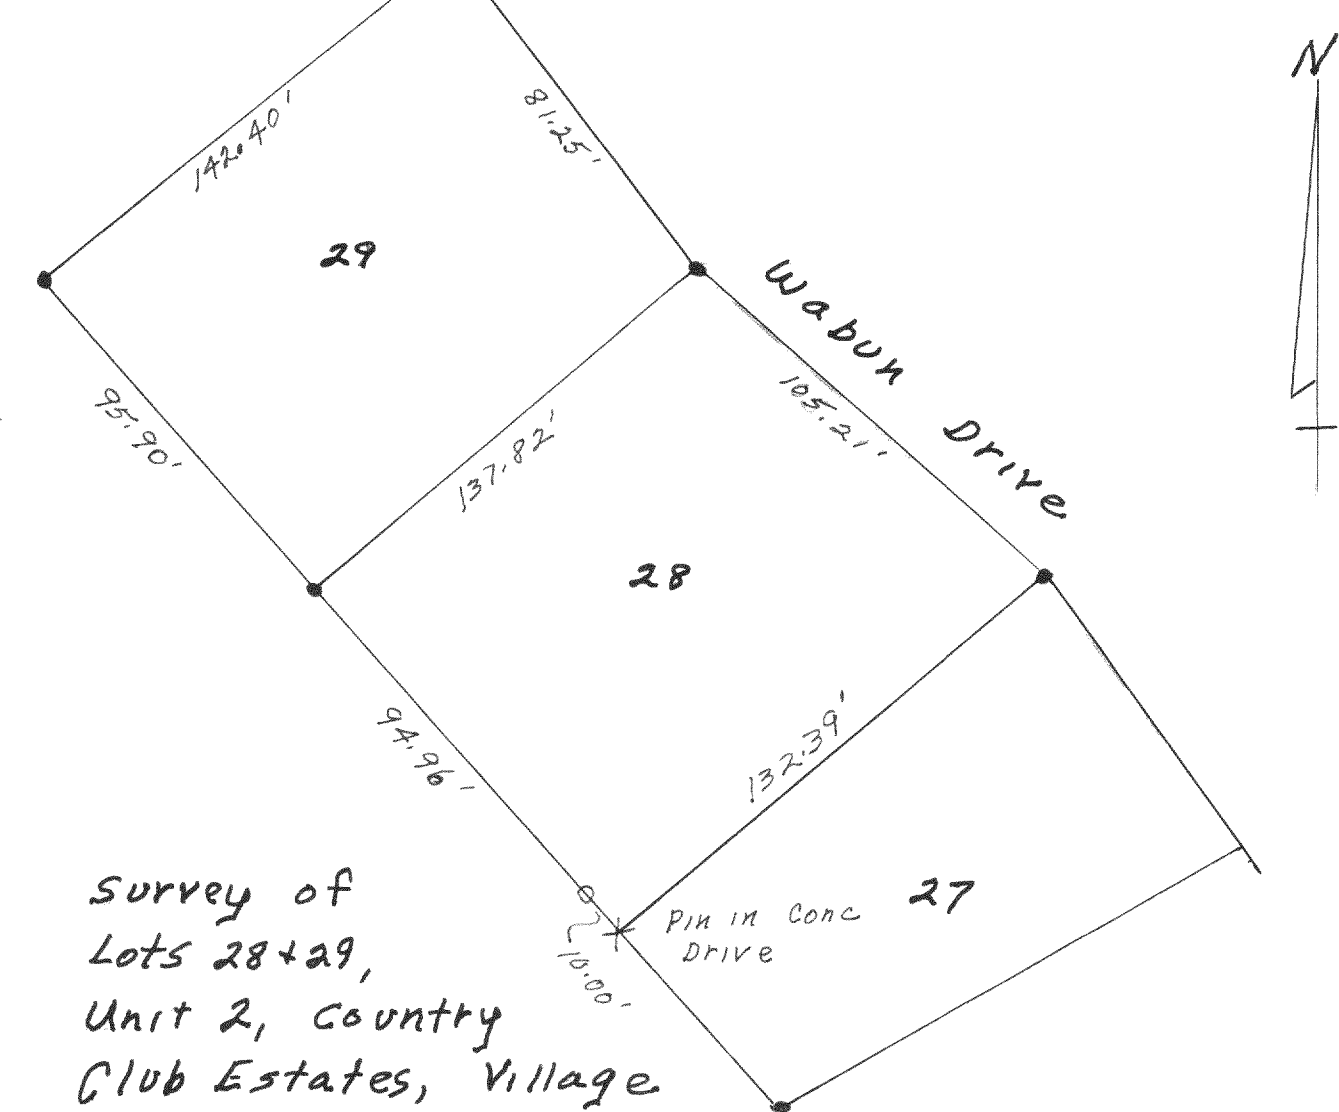

#3990

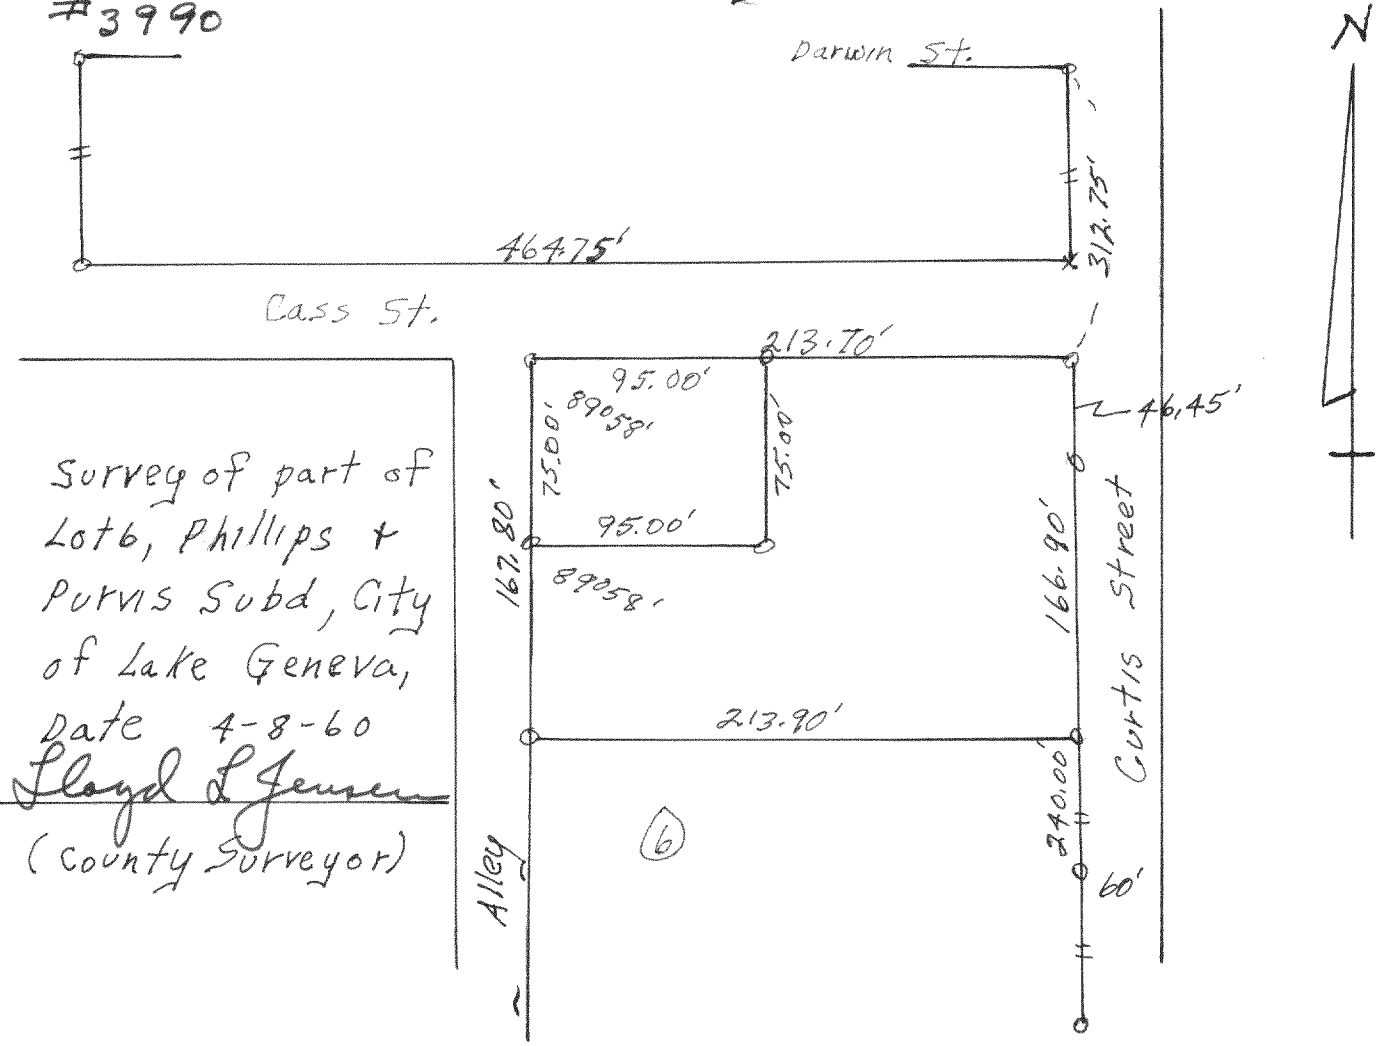

#3991

