


4055

PLAT OF SURVEY OF
LOT NUMBERED FOUR (4) OF INDIAN ECHO ESTATES,
A PROPOSED SUBDIVISION LOCATED IN THE NORTH
WEST 1/4 OF THE NORTHEAST 1/4 OF SECTION 34, T2N,
R 17 E, WALWORTH COUNTY, WISCONSIN.

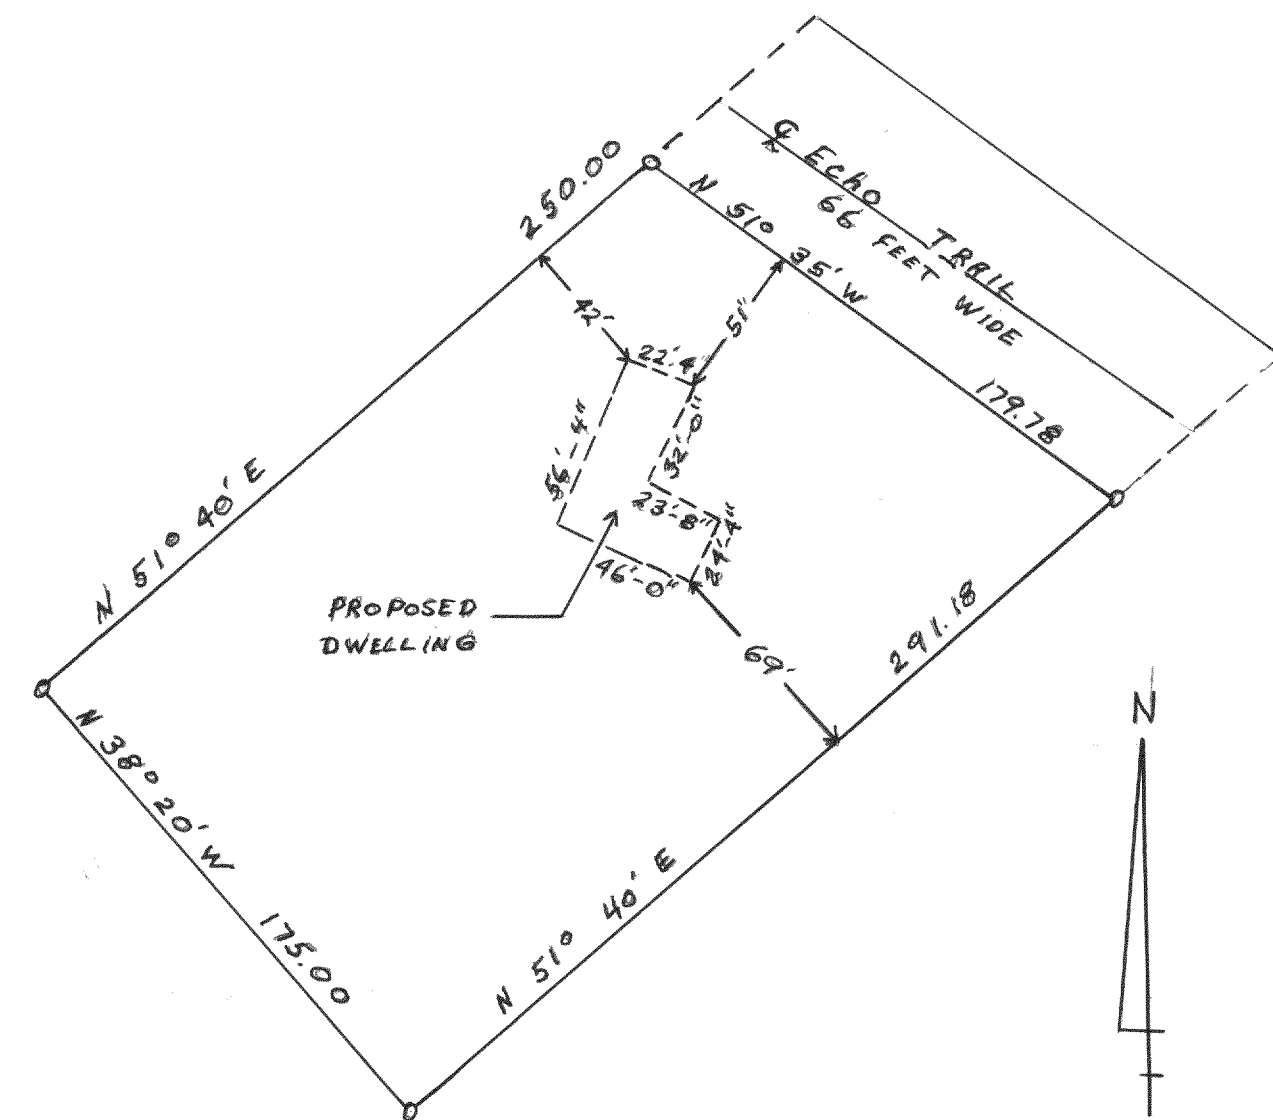


APR 1963

Lloyd L Jensen
WAL. CO. SURVEYOR

4056

PLAT OF SURVEY OF
LOT 11 - BLOCK 2
UNIVERSITY HEIGHTS
VILLAGE OF WILLIAMS BAY
WALWORTH COUNTY, WISCONSIN

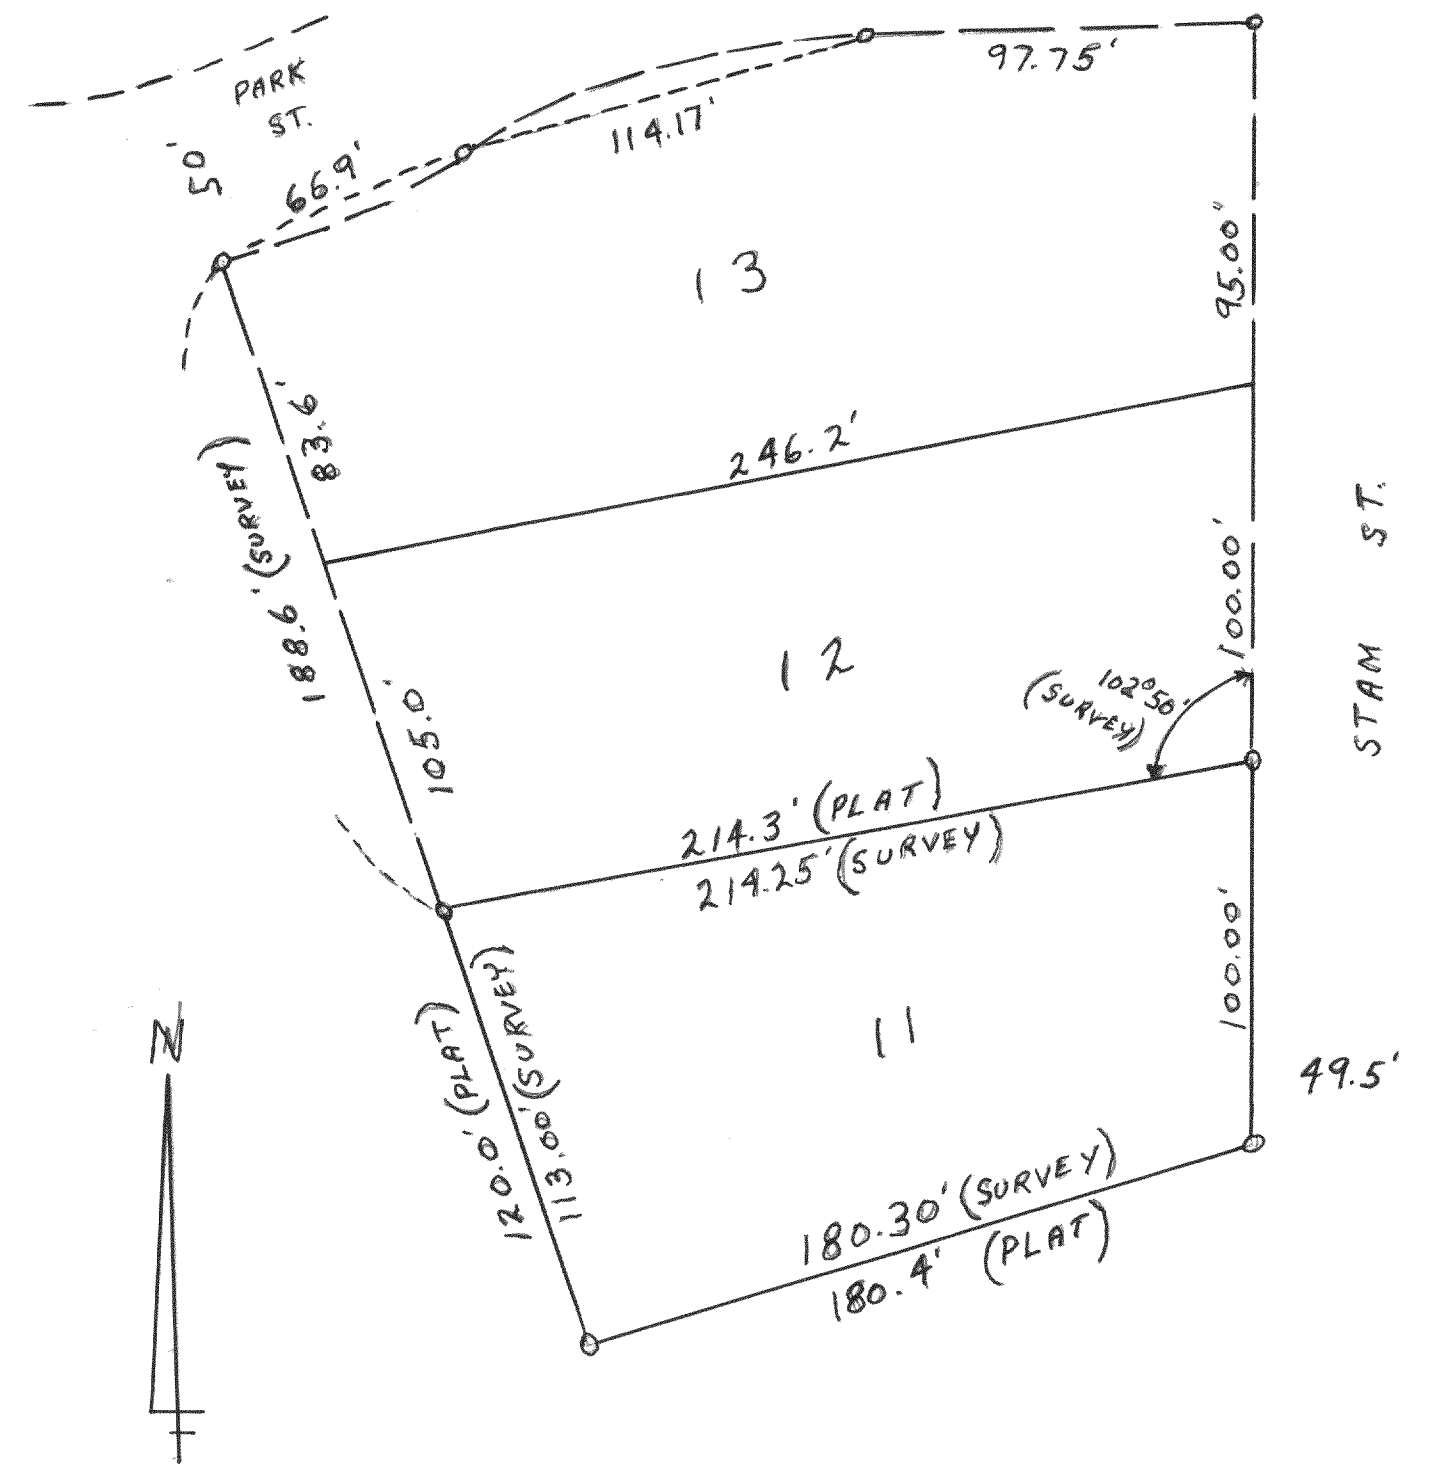

FEB. 1963

Lloyd L Jensen
WAL. CO. SURVEYOR