



4057
 PLAT OF SURVEY OF
 Lot 9
 Lynndale Subdivision SE 1/4
 NW 1/4 & SW 1/4 NW 1/4 Sect 20, T4N
 R18E VILLAGE OF EAST TROY
 WALWORTH COUNTY, WISCONSIN

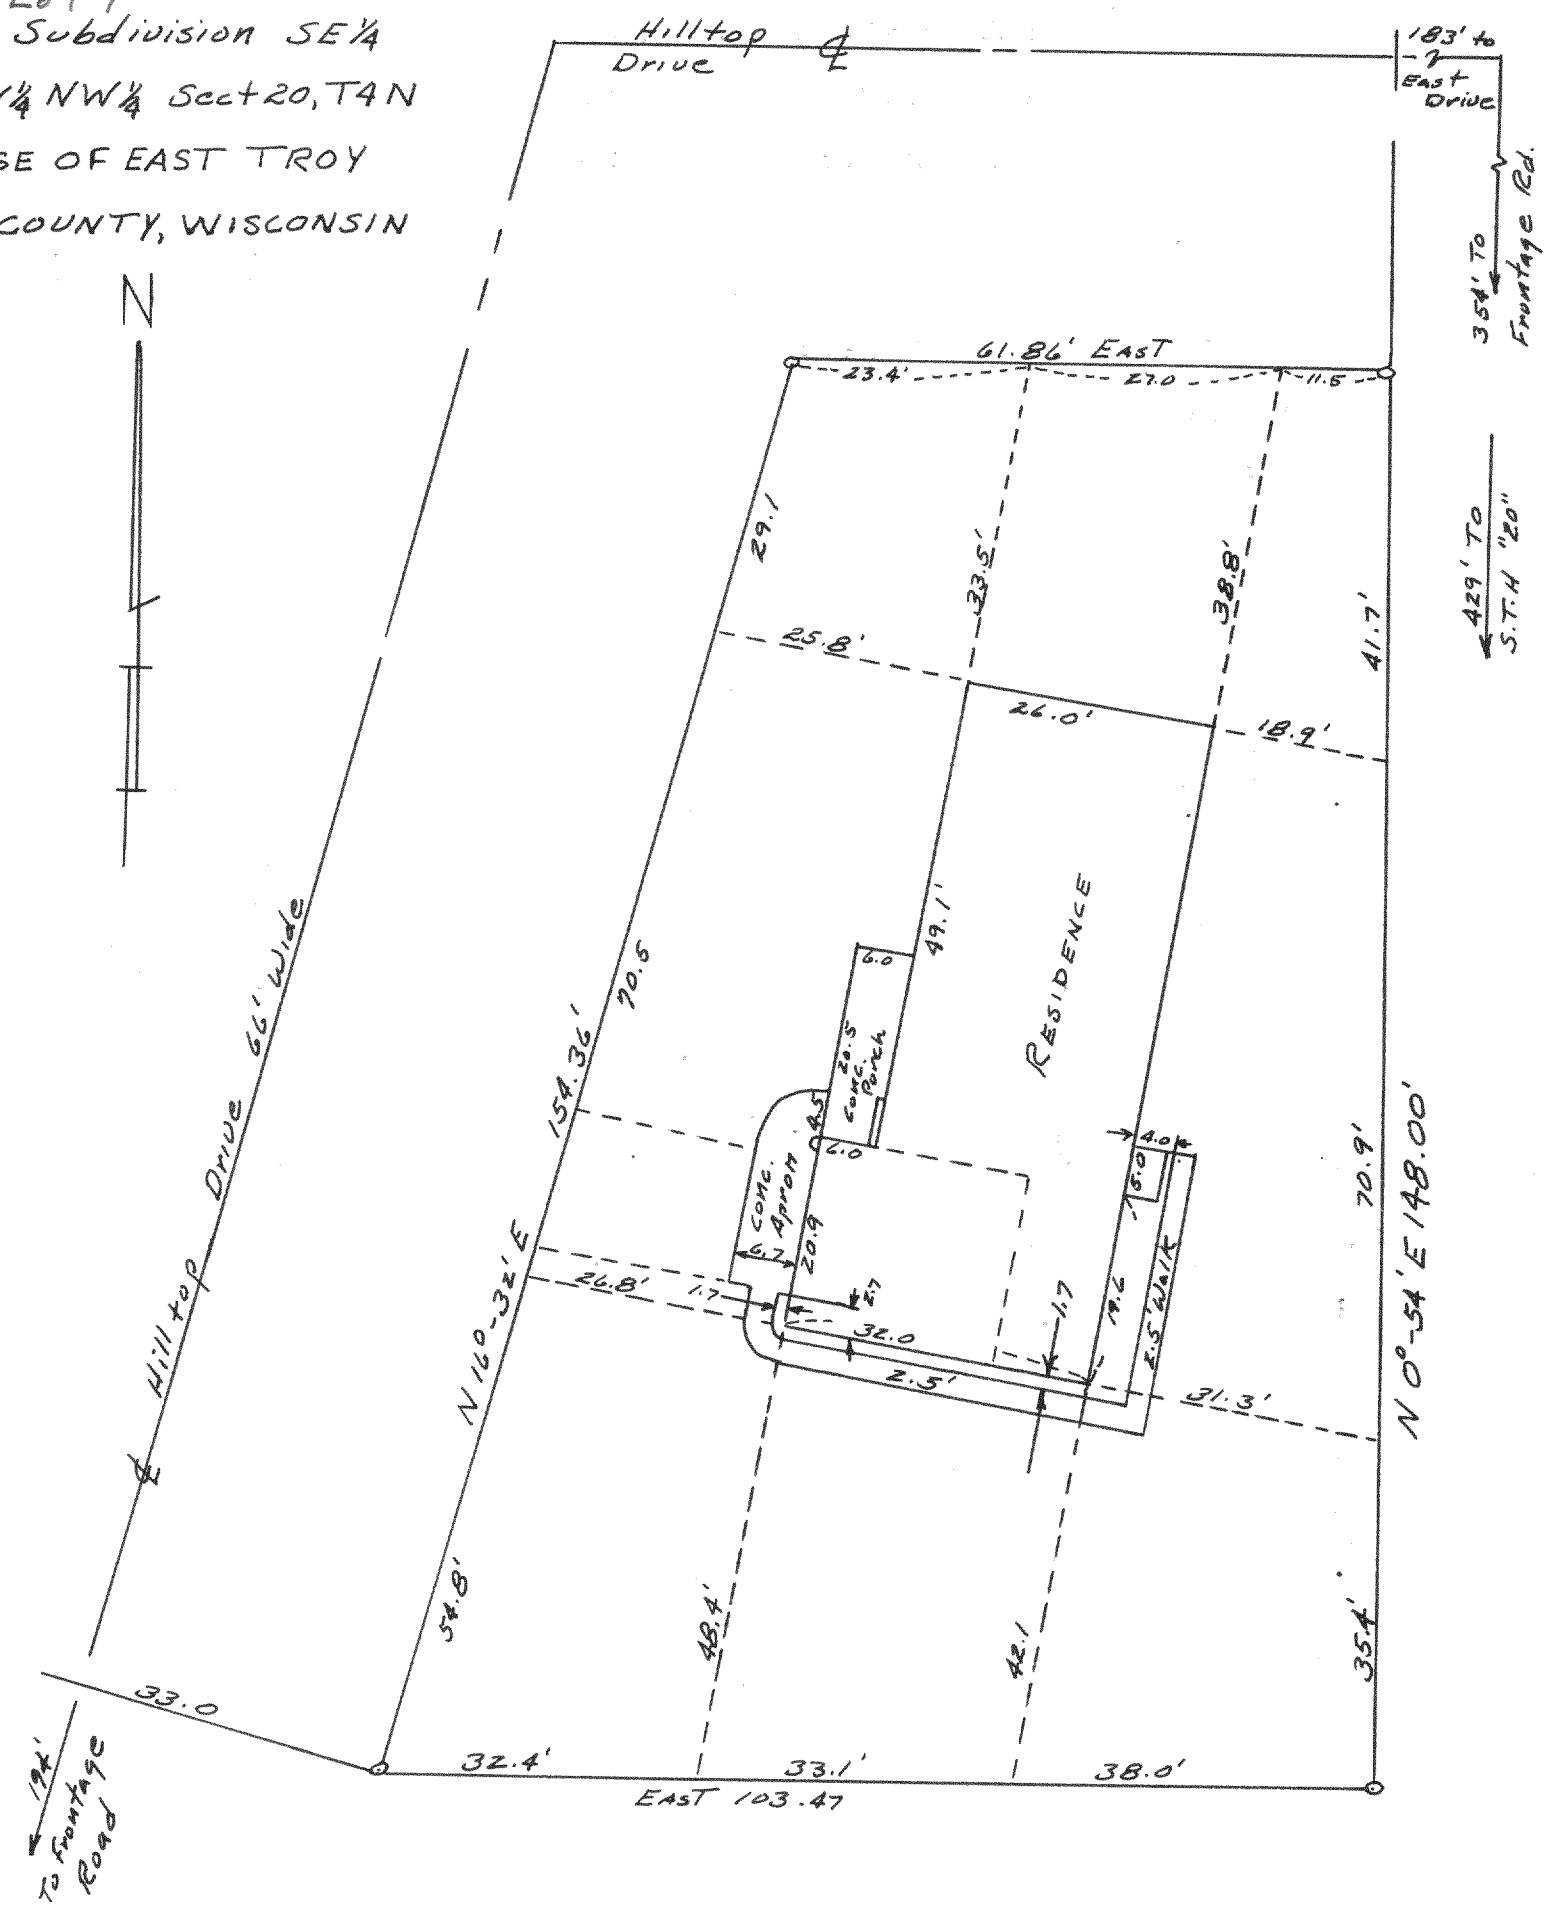

September 26, 1962

Lloyd L Jensen
 County Surveyor

4058
 PLATE OF SURVEY OF
 Lands located in the SW 1/4 of Section 5,
 T4N-R15E Walworth County, Wisconsin

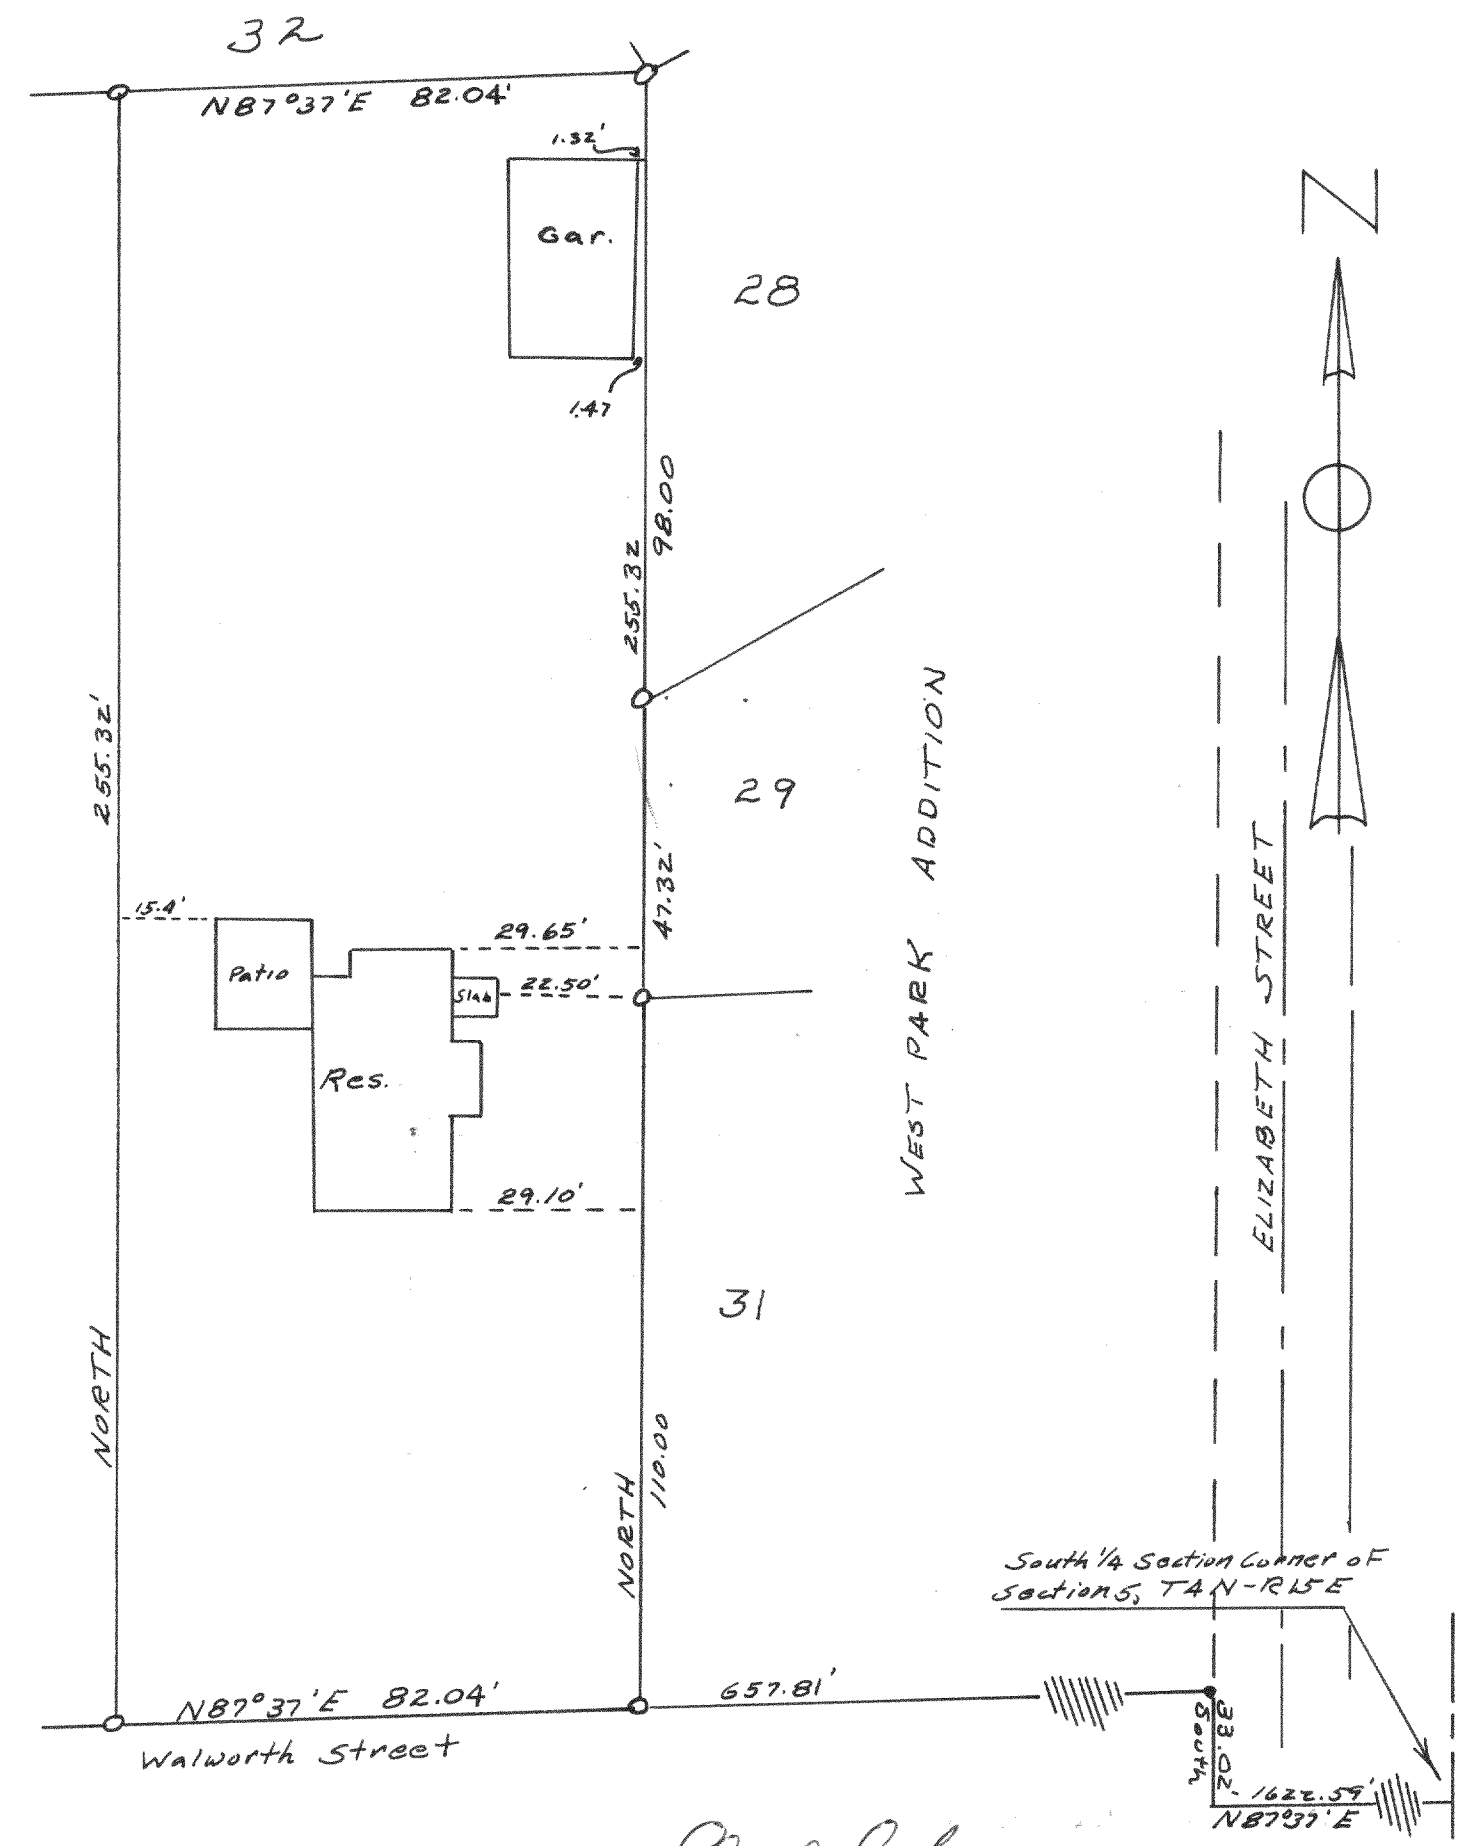

August 1962

Lloyd L Jensen
 County Surveyor