


4059

PLAT OF SURVEY OF

ALL THAT PART OF THE SE 1/4 OF SECTION 19
AND THE NE 1/4 OF SECTION 30, T 4 N, R 18 E, WALWORTH
COUNTY, WISCONSIN BOUNDED AND DESCRIBED AS FOLLOWS, TO-WIT:

COMMENCING AT THE INTERSECTION OF THE NORTH LINE OF MAIN
STREET AND THE EAST LINE OF BEULAH AVENUE IN THE VILLAGE
OF EAST TROY, THENCE N 00° 45' W IN THE EAST LINE OF SAID
BEULAH AVENUE 133.60 FEET; THENCE N 89° 45' E 74.25 FEET; THENCE
S 00° 47' E 121.84 FEET; THENCE S 81° 00' W ALONG THE NORTH LINE
OF MAIN STREET 75.18 FEET TO THE POINT OF BEGINNING

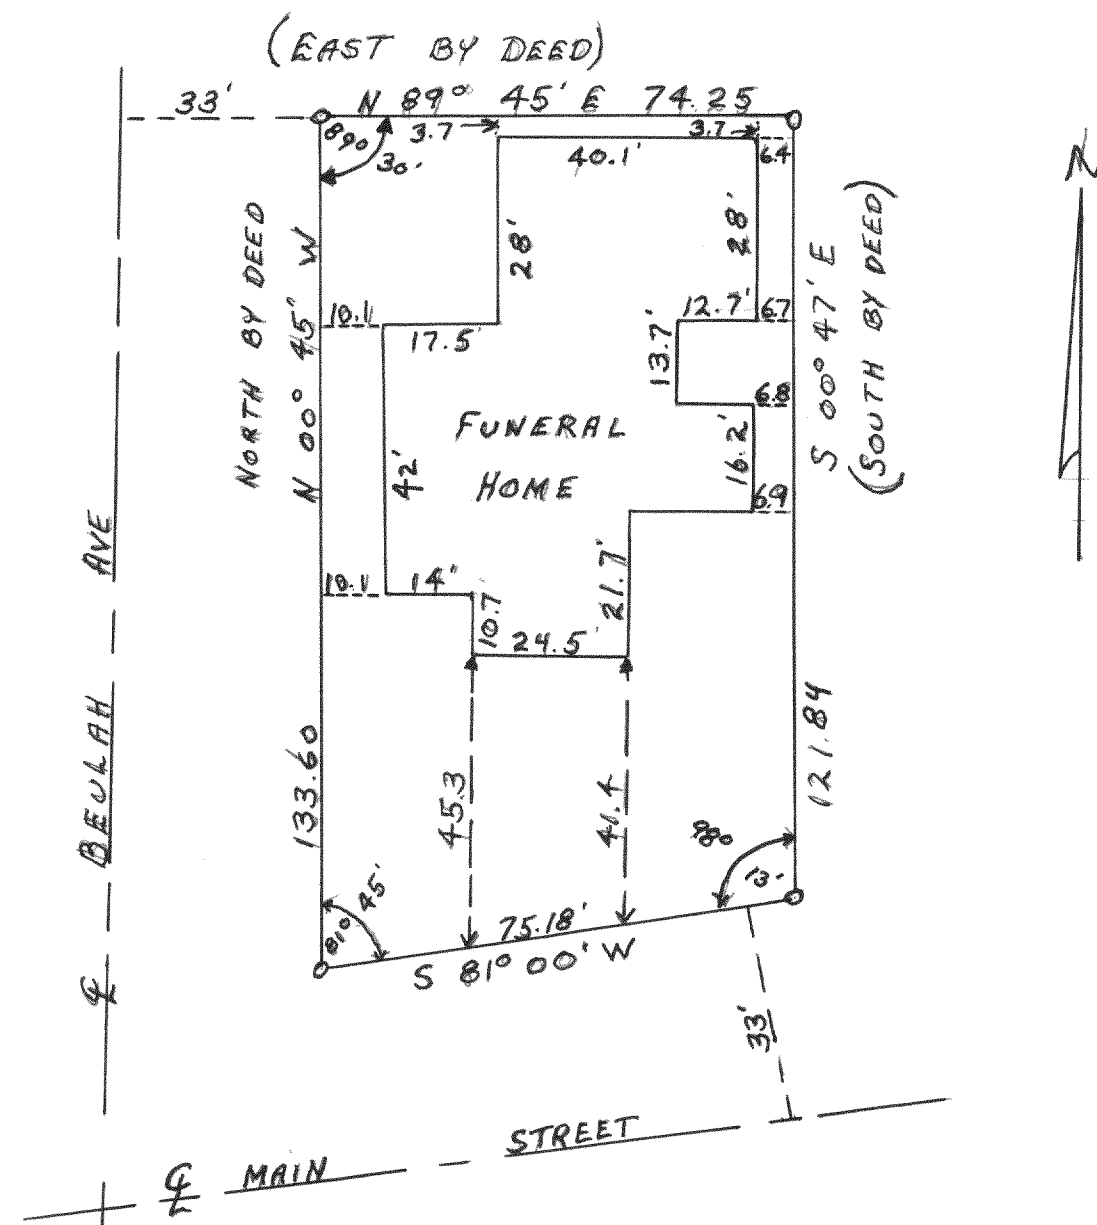

MARCH 1963


Lloyd Jensen
WAL. CO. SURVEYOR

4060

PLAT OF SURVEY OF

ALL THAT PART OF LOTS 4, 5, 8, OF BLOCK 2 OF THE ORIGINAL PLAT TO THE CITY
OF LAKE GENEVA WALWORTH COUNTY, WISCONSIN BOUNDED AND DESCRIBED AS FOLLOWS, TO-WIT:

BEGINNING AT THE NORTHEAST CORNER OF SAID LOT 4 AND RUNNING THENCE SOUTH ALONG THE EAST
LINE OF SAID BLOCK 2, 159.50 FEET; THENCE WEST PARALLEL TO THE NORTH LINE OF SAID LOT 4
134.00 FEET; THENCE NORTH PARALLEL TO THE EAST LINE OF SAID BLOCK 2, 84.50 FEET; THENCE
EAST PARALLEL TO THE NORTH LINE OF SAID LOT 4, 34.00 FEET; THENCE NORTH PARALLEL TO THE
EAST LINE OF SAID BLOCK 2, 75.00 FEET TO THE NORTH LINE OF SAID LOT 4; THENCE EAST ALONG THE
NORTH LINE OF SAID LOT 4, 100.00 FEET TO THE POINT OF BEGINNING, CONTAINING 10,820 SQUARE FEET
OF LAND MORE OR LESS.

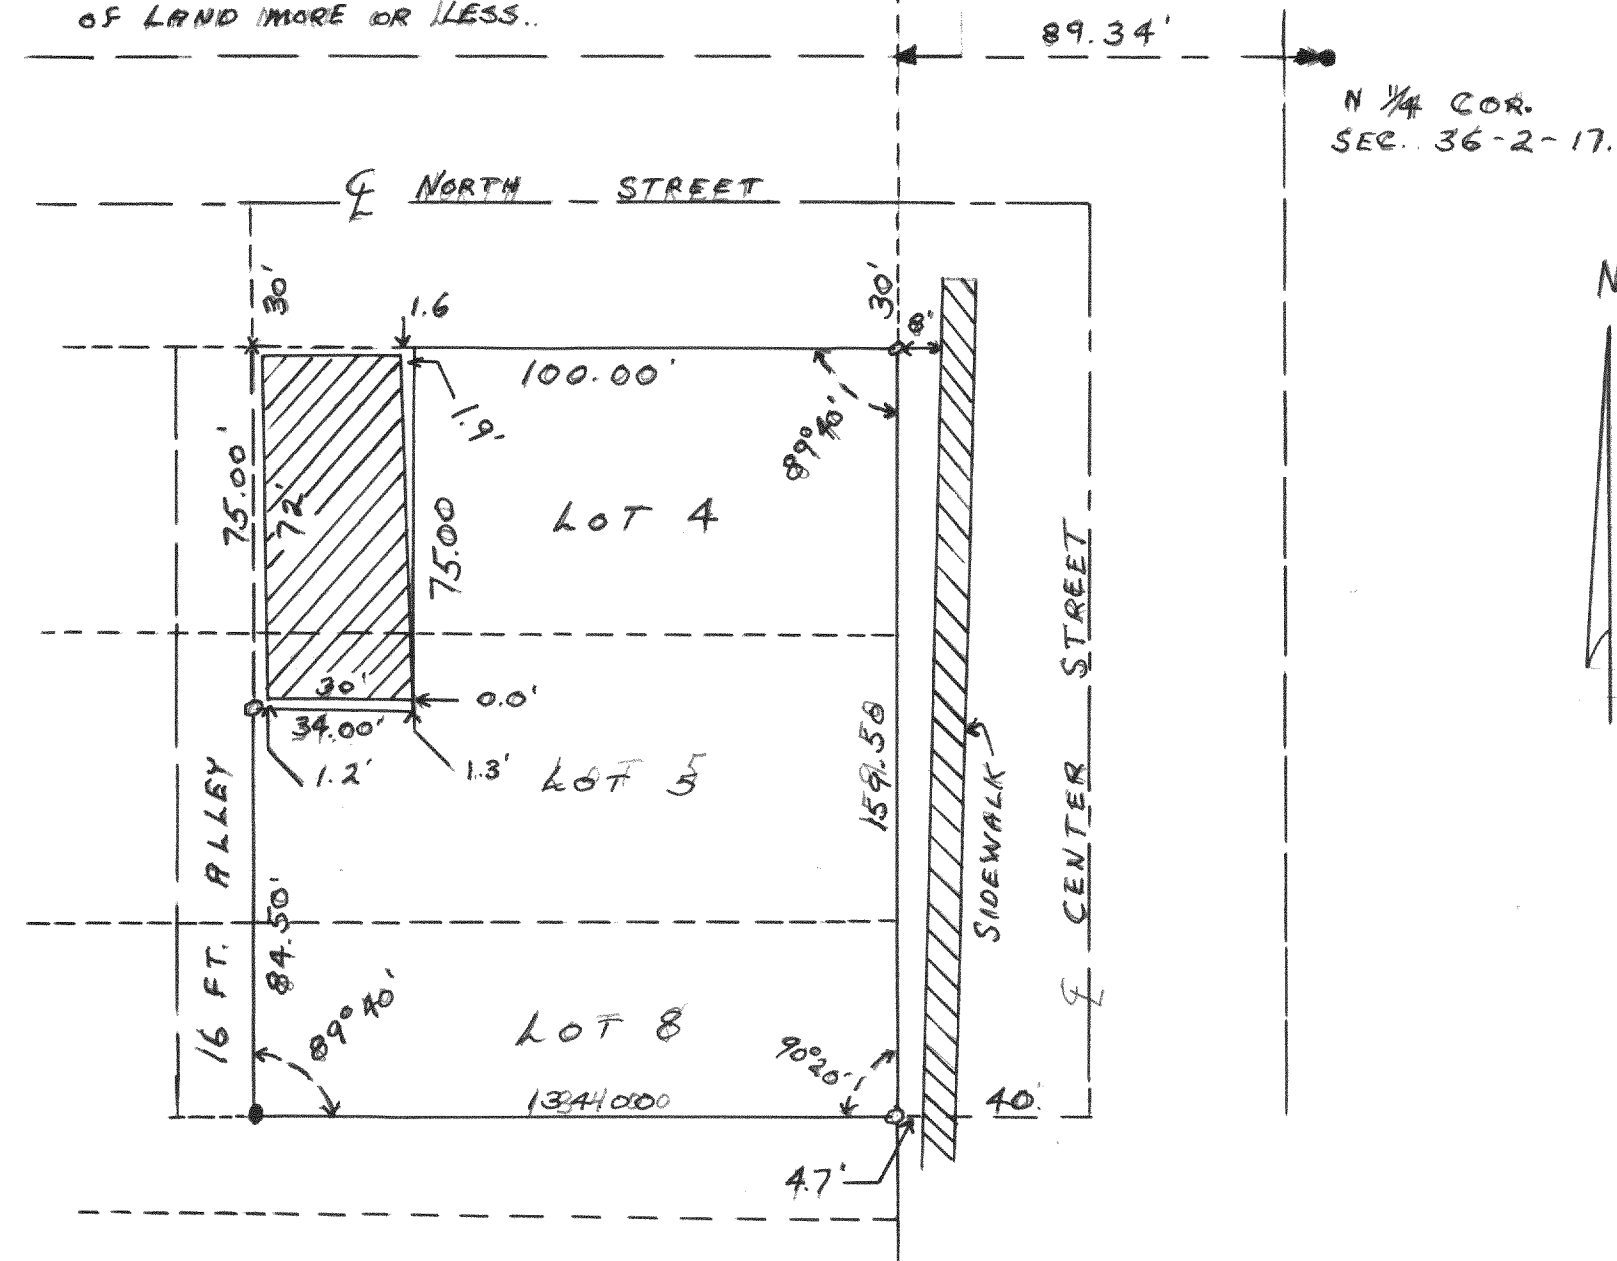

MARCH 1963

Lloyd Jensen
WAL. CO. SURVEYOR