


~~40~~ 4061

PLAT OF SURVEY OF
LOT 1 OF Block 32 OF The Original Plat
Except The North 73 Feet And Lot 4,
Block 32, Rockwells 1st Addition To
The City of Elkhorn
WALWORTH COUNTY, WISCONSIN

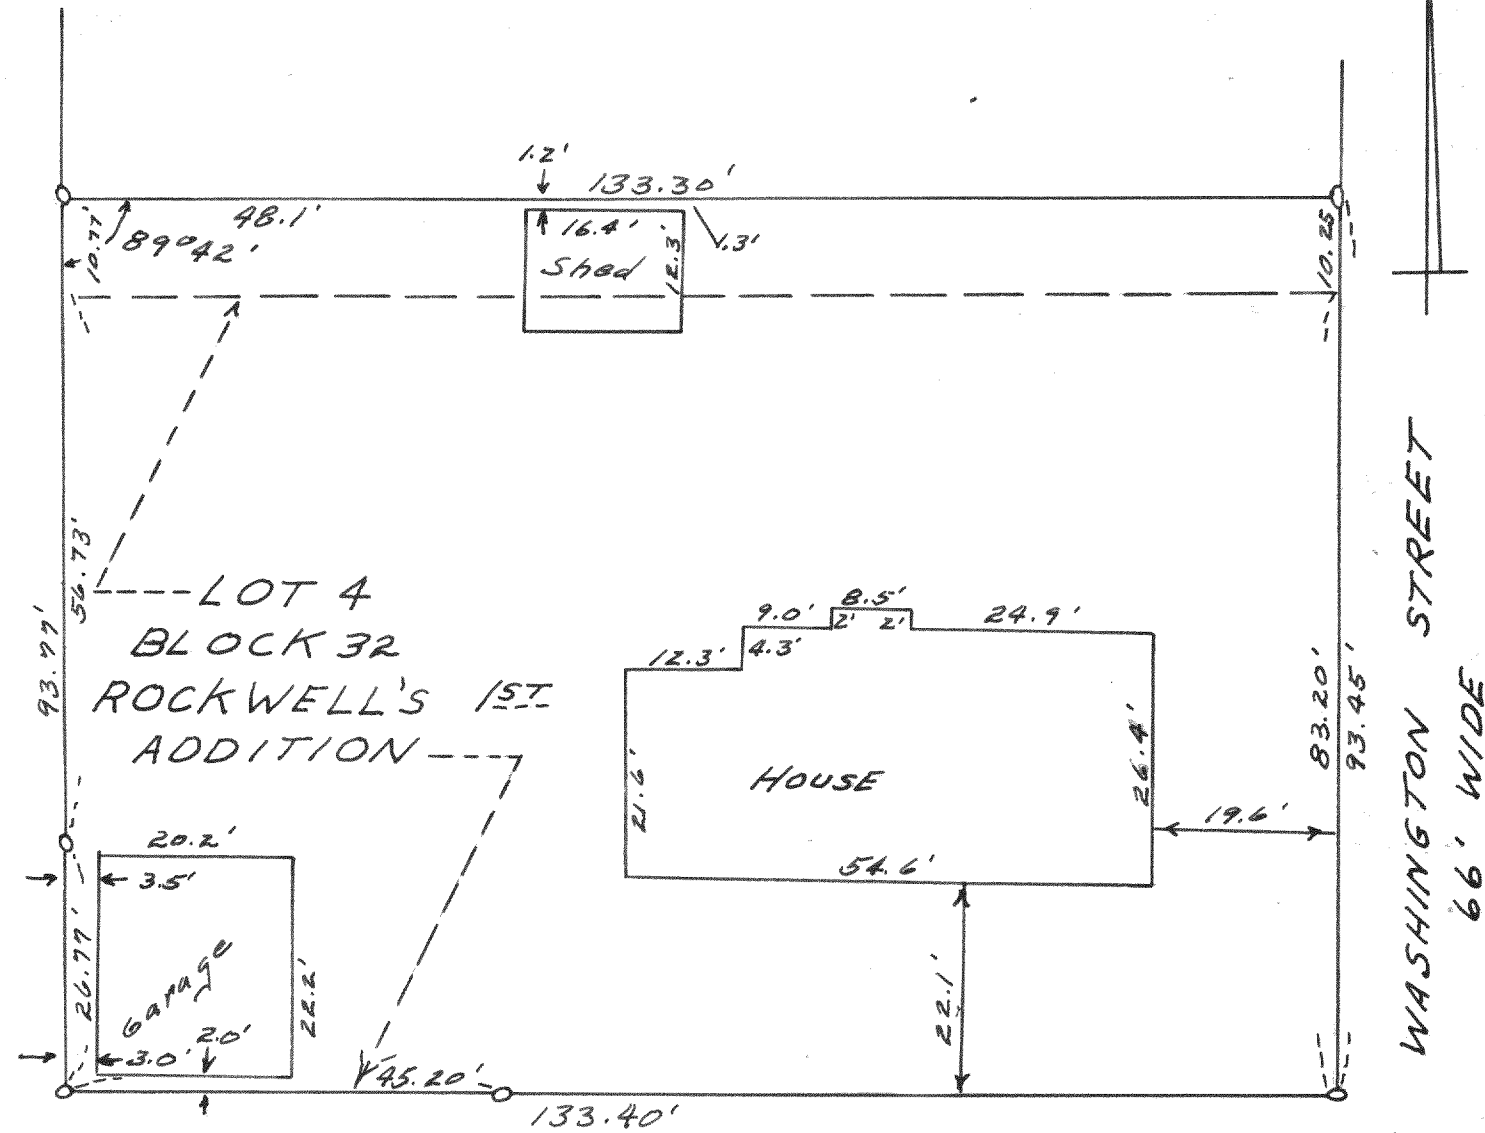


August 1962

Lynd Jensen
County Surveyor

~~#~~ 4062

PLAT OF SURVEY OF
Lot 20, Block 1, MIRAMAR Subdivision
Being a Part of the E $\frac{1}{2}$ of Section 10
And the W $\frac{1}{2}$ of Section 11, TAN, R 18E
WALWORTH COUNTY, WISCONSIN

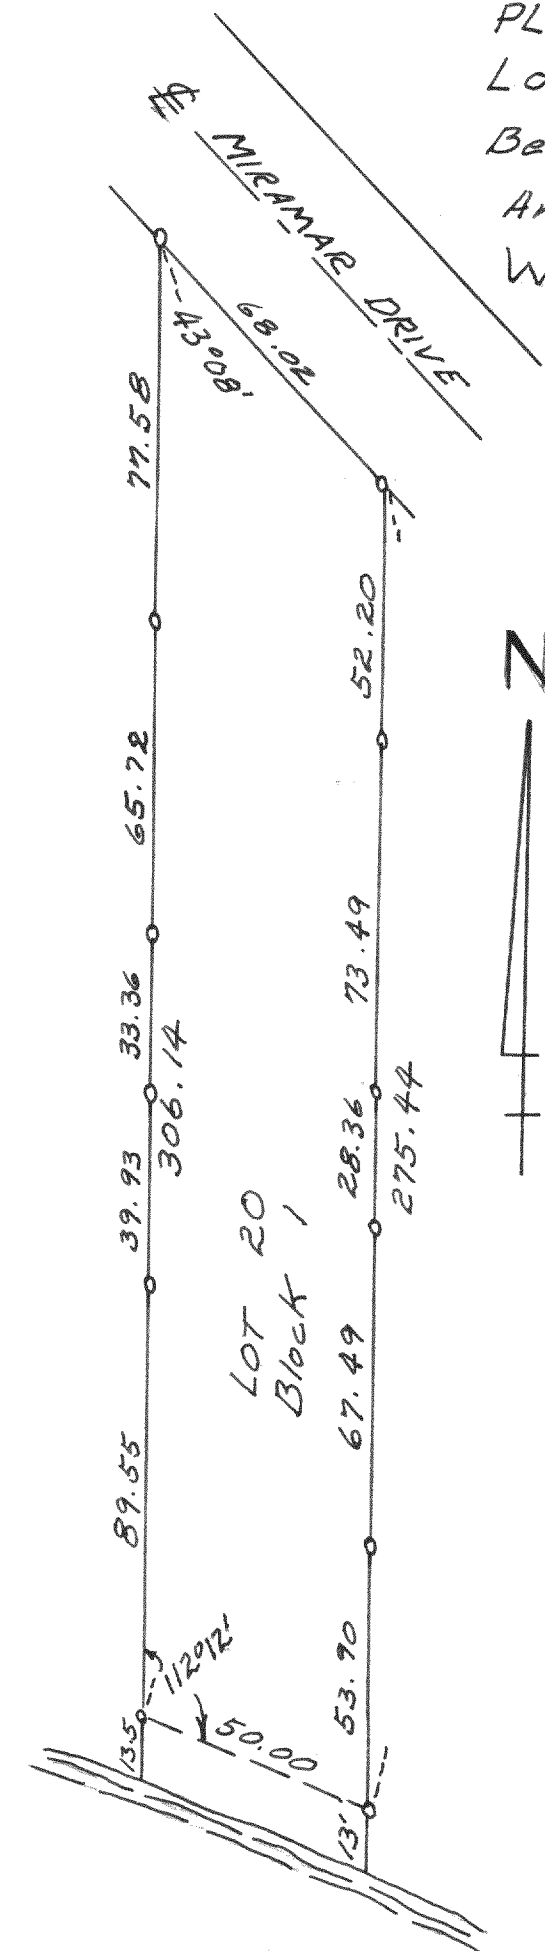

Potter Lake

September 1962

Lloyd L Jensen
County Surveyor