


#4095


PLAT of SURVEY of
THE WEST 66' of LOT 1, BLOCK 4
of the ORIGINAL VILLAGE of WILLIAMS
BAY, WALWORTH COUNTY, WISCONSIN

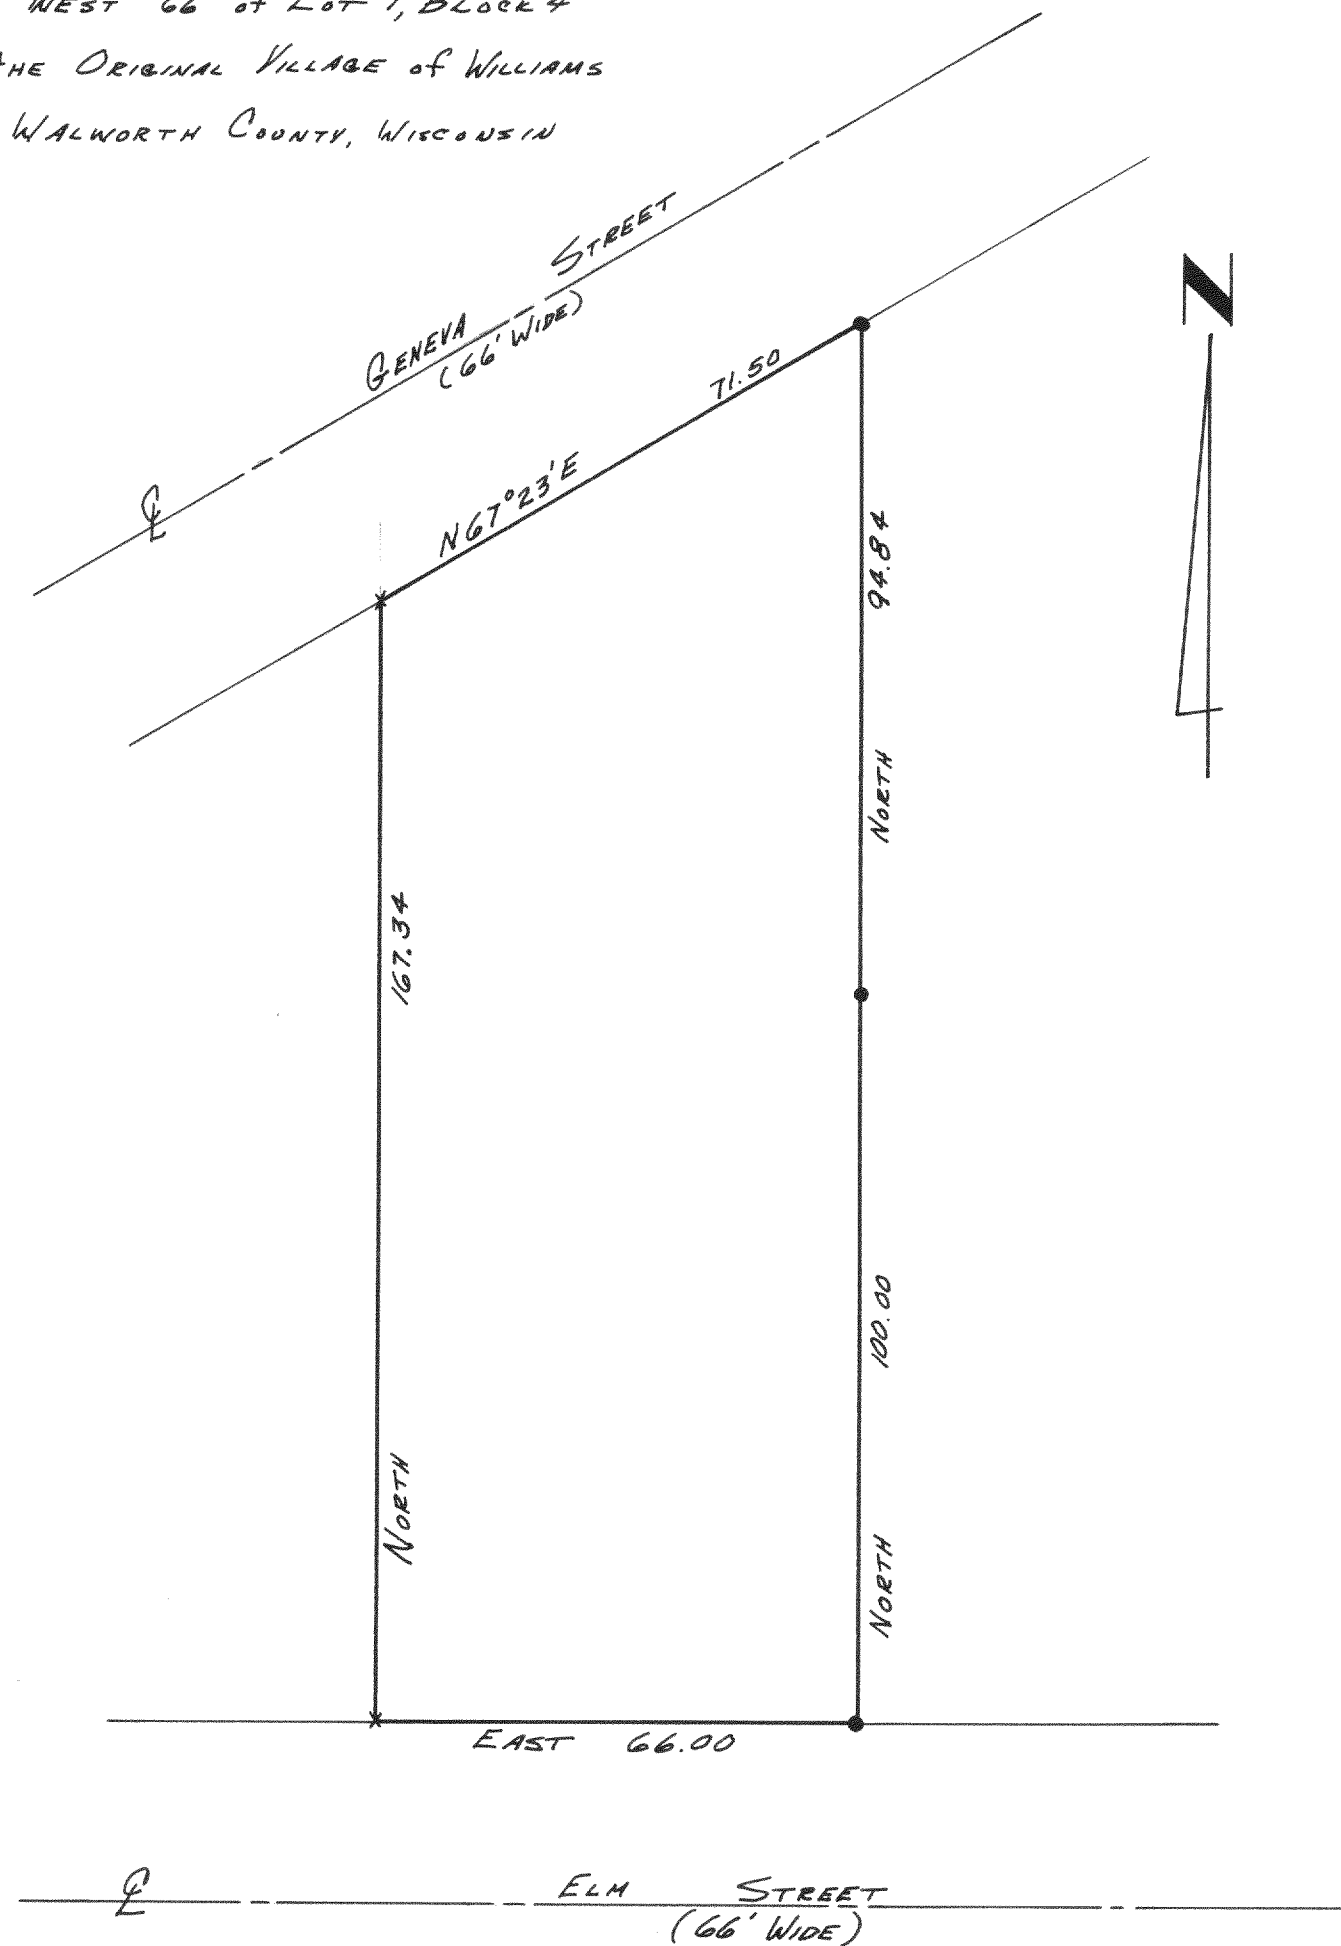

FEB. 1963 *Lloyd Jensen*
WAL. CO. SURVEYOR

#4096

PLAT of SURVEY of
A PARCEL of LAND LOCATED IN THE SW 1/4
of SEC. 20, T4N, R18E, VILLAGE of EAST TROY
WALWORTH COUNTY, WISCONSIN

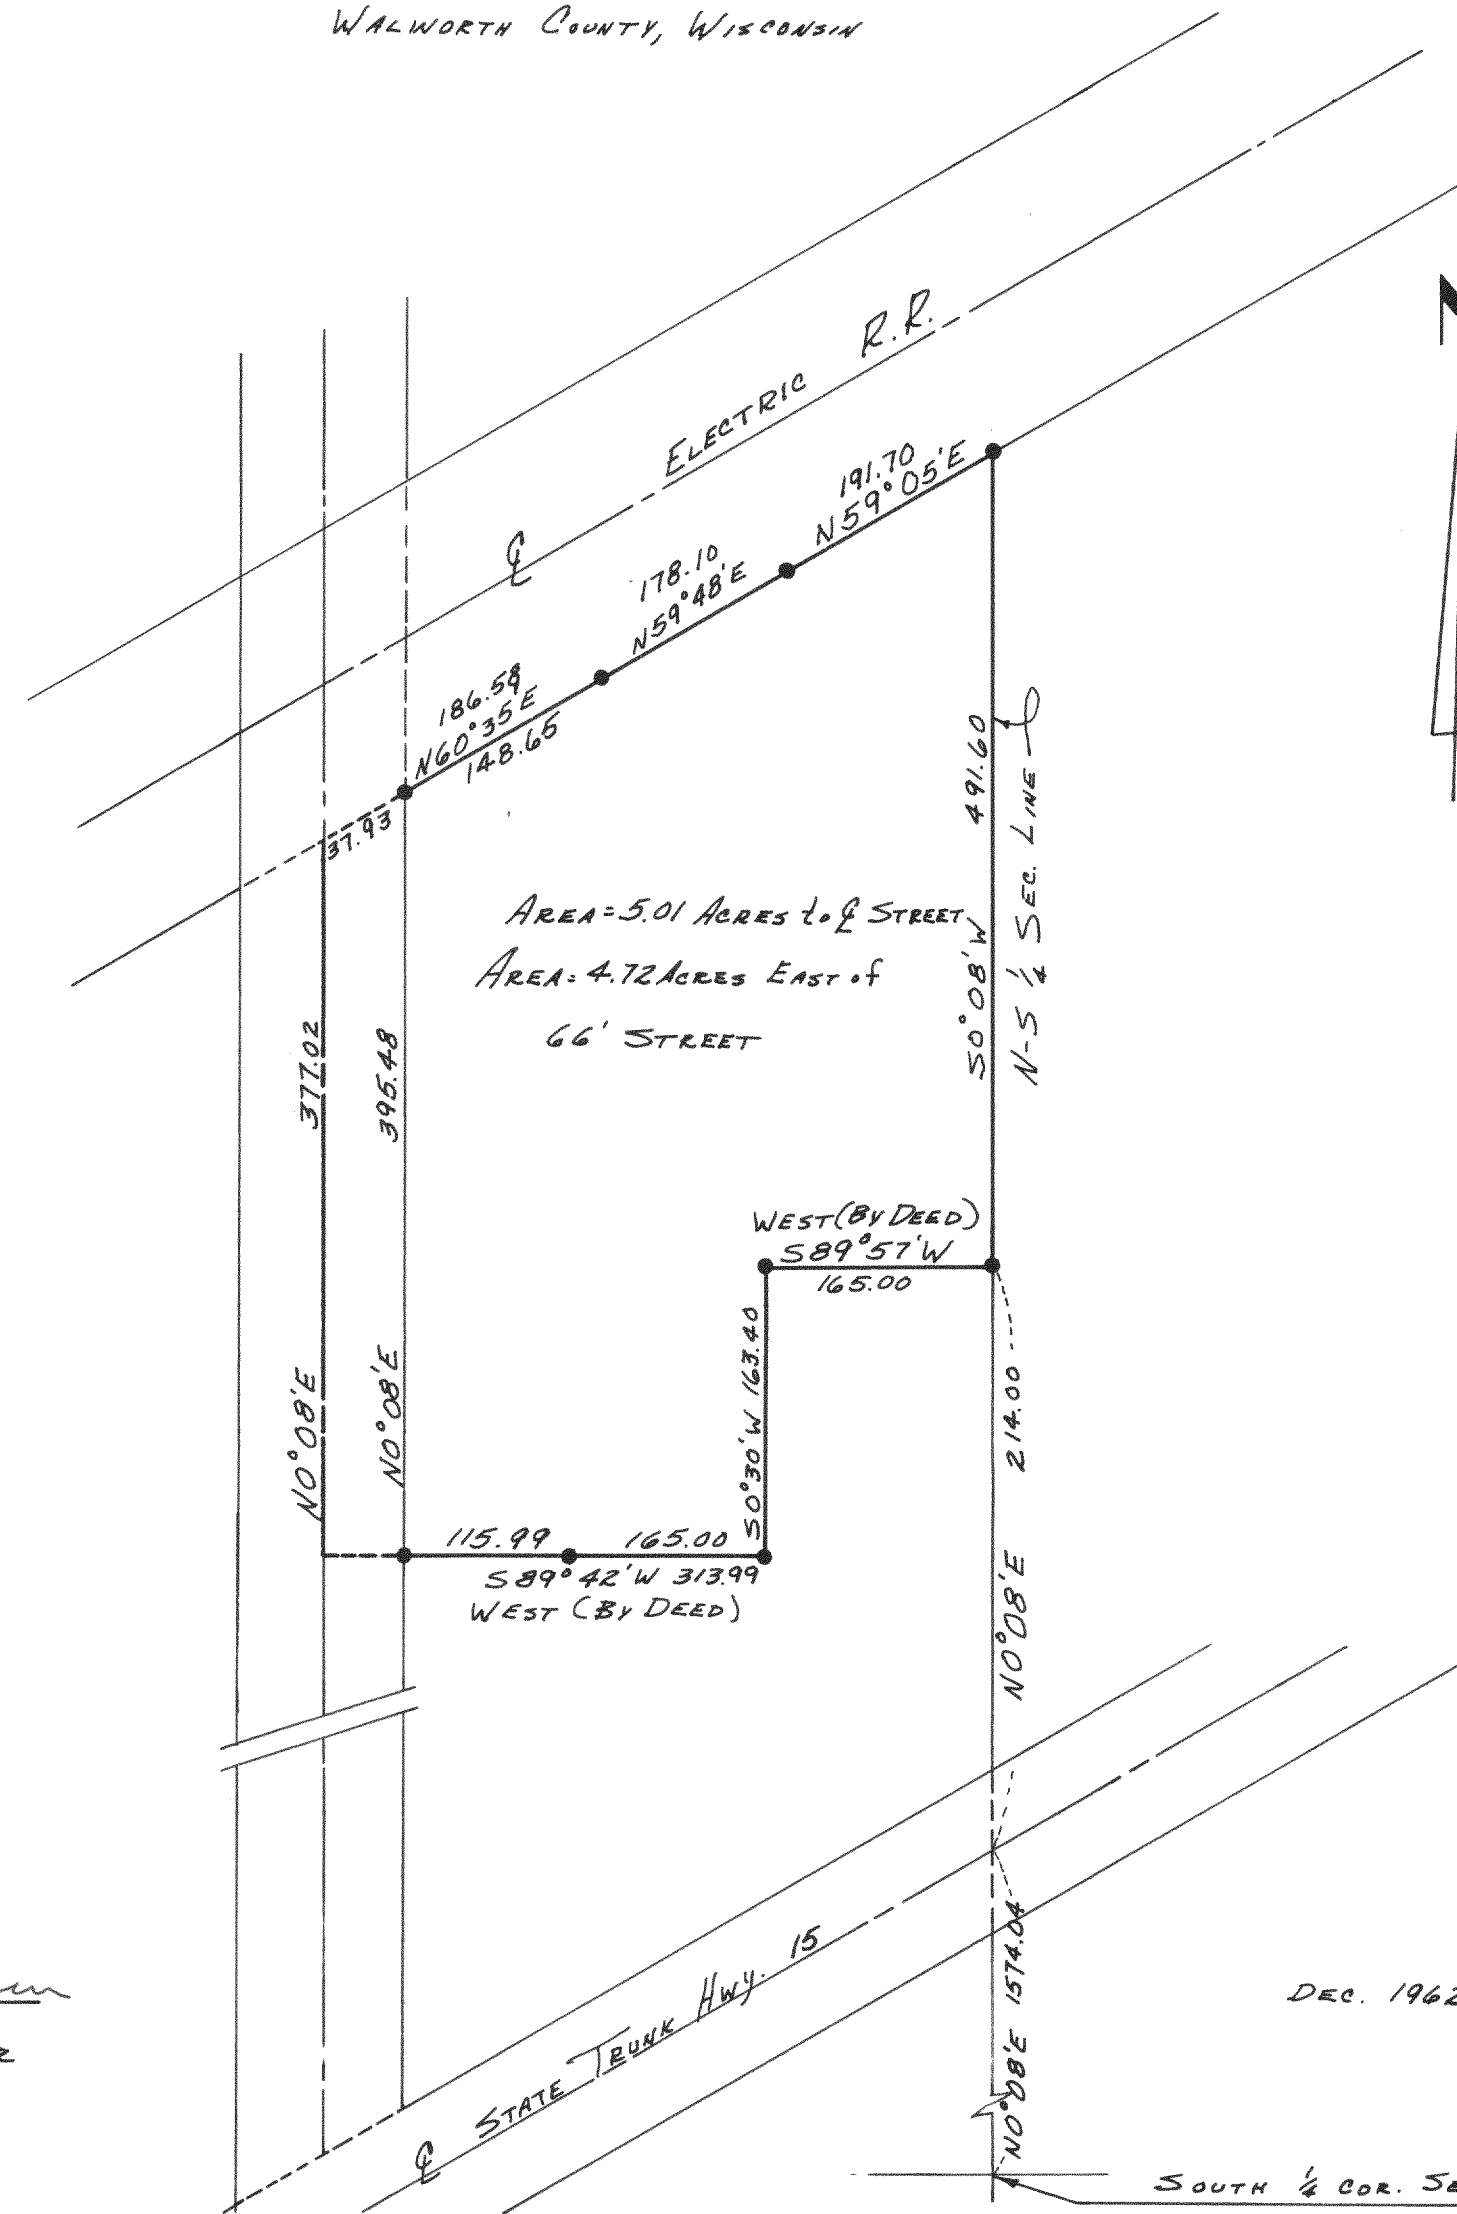

DEC. 1962 *Lloyd Jensen*
WAL. CO. SURVEYOR