


#4203

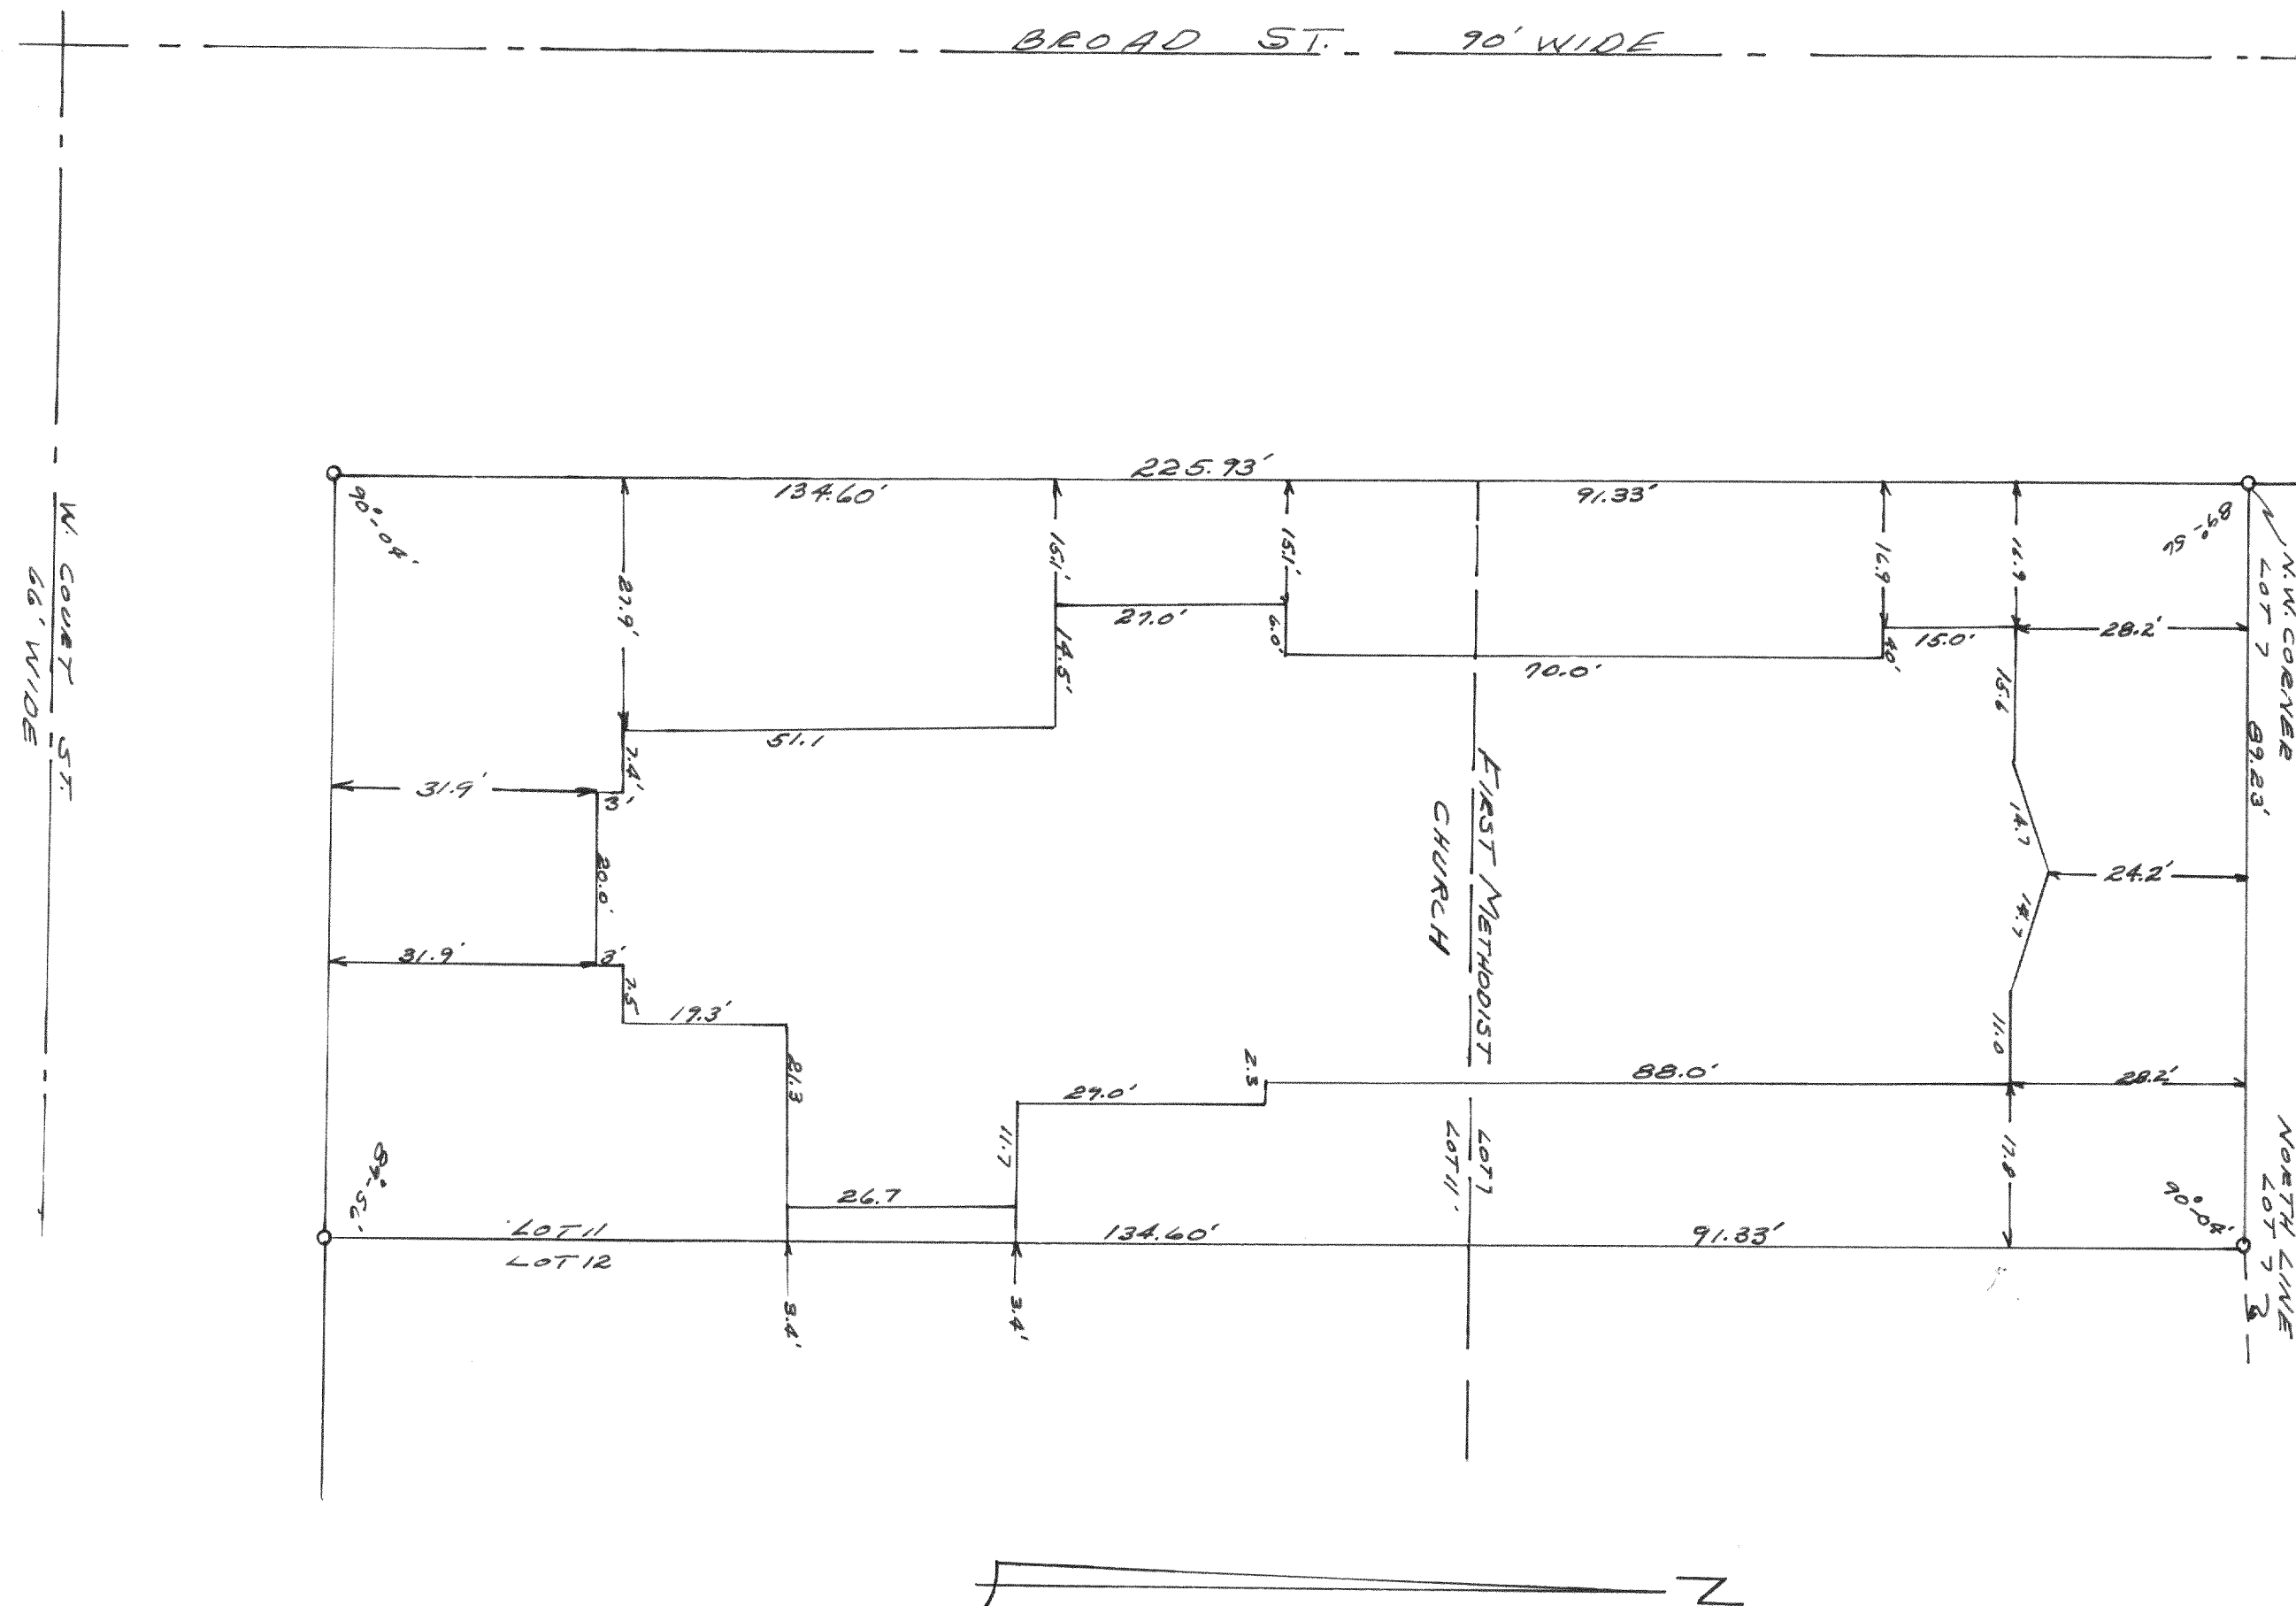

PLAT OF SURVEY OF
 LOT 11 AND THE WEST 89.23'
 OF LOT 7, BLOCK 16, ORIGINAL
 PLAT, CITY OF ELKHORN,
 WALWORTH COUNTY, WIS.

OCT. 1964

Lloyd Jensen
 CO. SURVEYOR