


#4214

PLAT OF SURVEY
OF
LAND LOCATED
IN SECTION 2, T2N R16E
(DELAYAN TOWN) WAL-
NORTH COUNTY, WISCONSIN



#4215

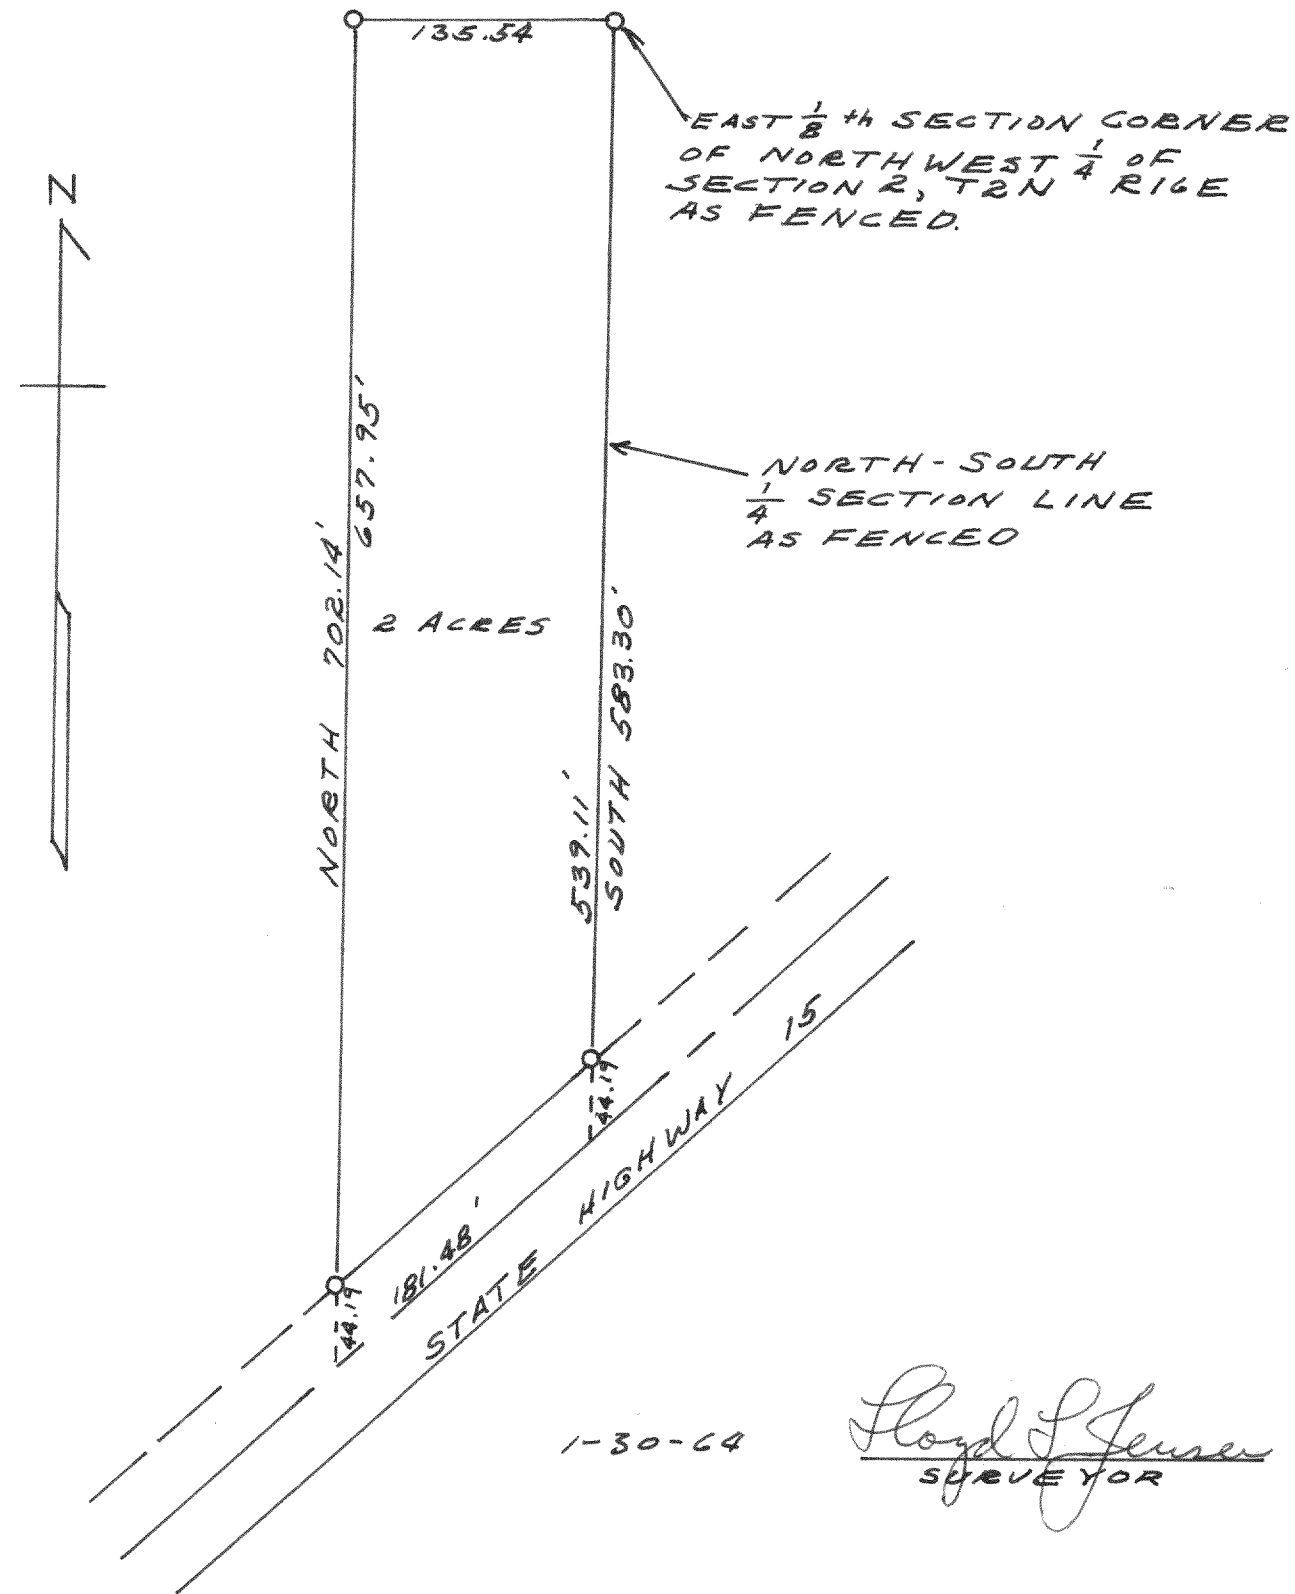