



2799

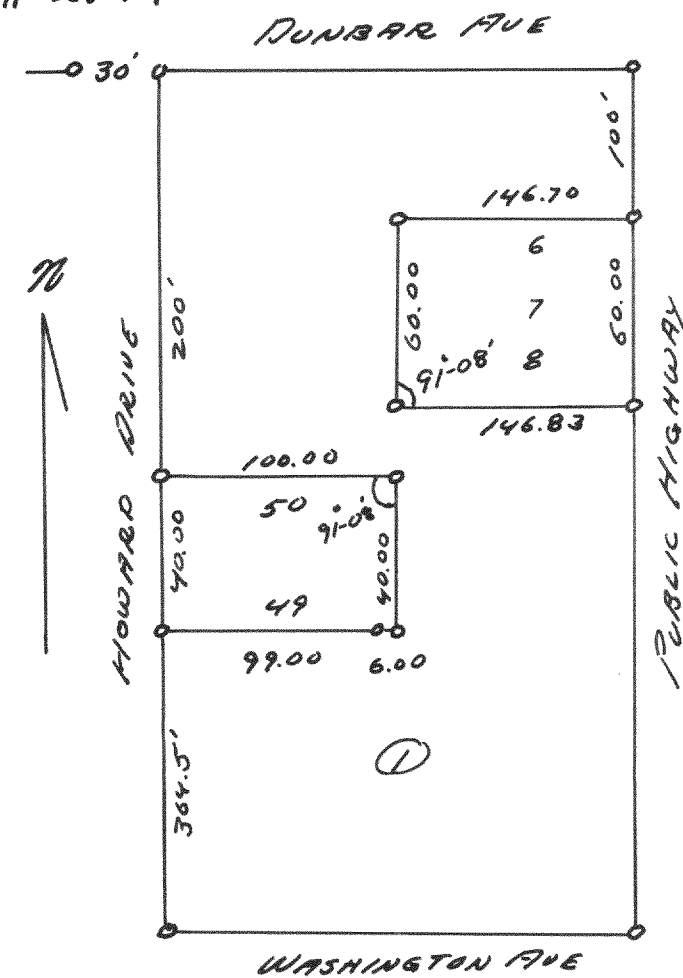


Plat of Survey of Lots 6, 7, 8, 19, & 50
Block 1 Lake Ivanhoe Resort
May 1953
LLJ
CS

2800

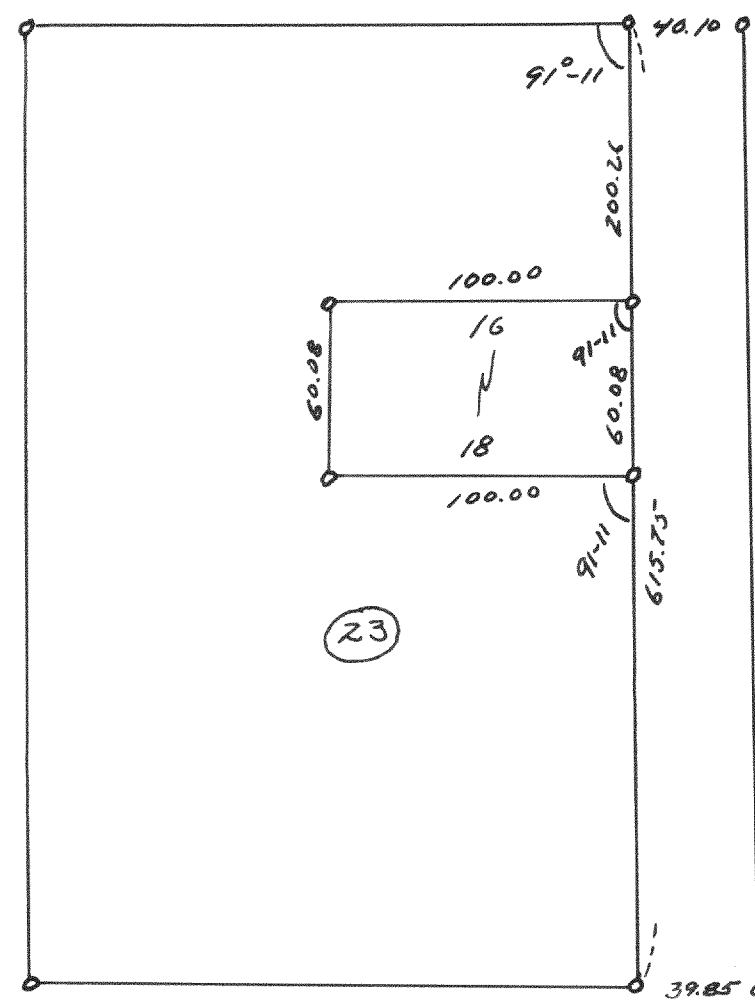

Plat of Survey of Lots 16-18
Block 23 Lake Ivanhoe Resort
April 1953
LLJ
CS

2801

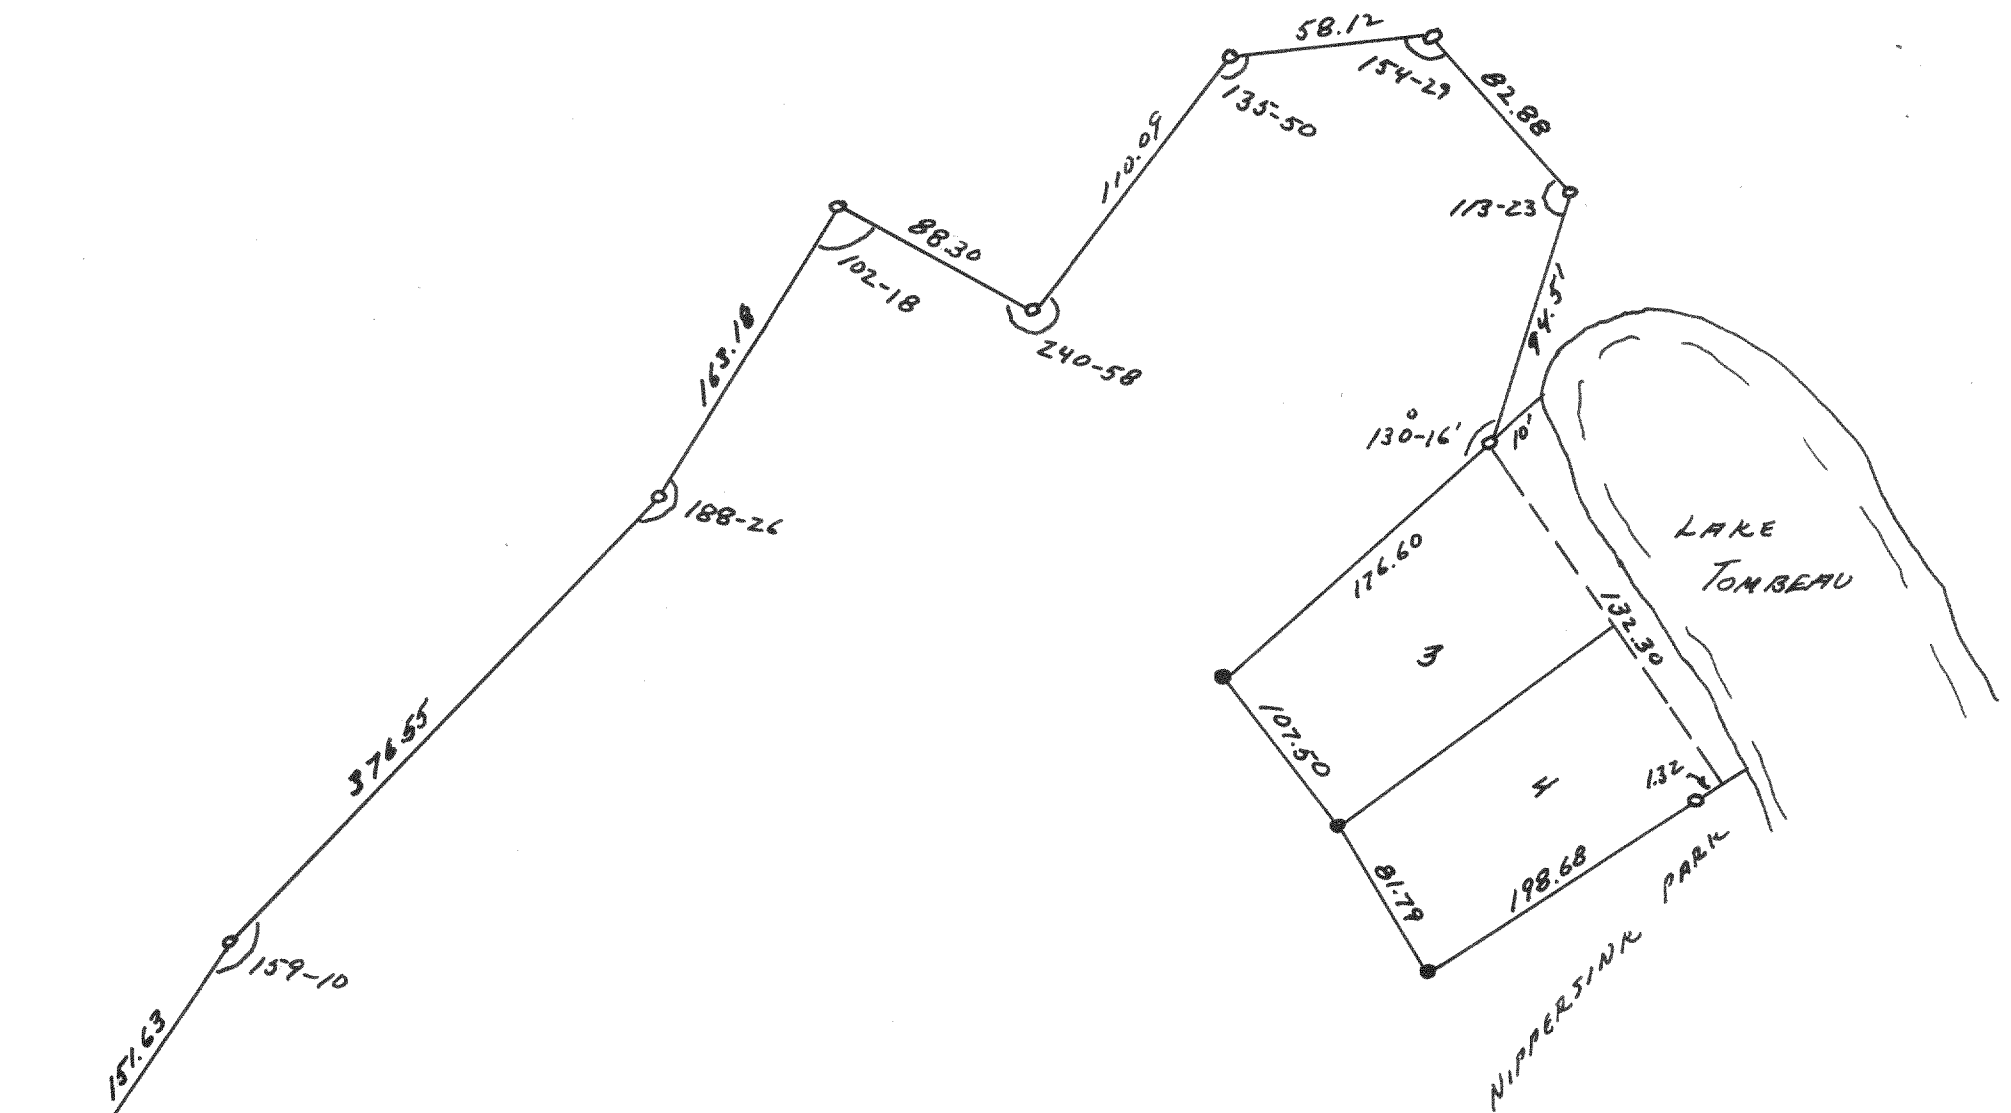


10.57 ACRES

SUBDIVISION


Plat of Survey of Land
located in the NE 1/4 of Section
24 T19N R18E
Oct., 1953
LLJ
CS

SECOND

2802

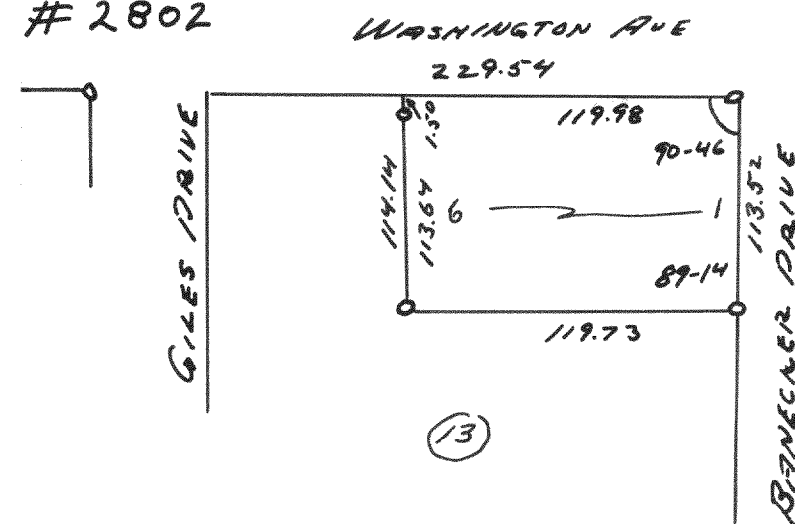

Plat of Survey of Lots 1-6
Block 13 Lake Ivanhoe Resort
April 1953
LLJ
CS

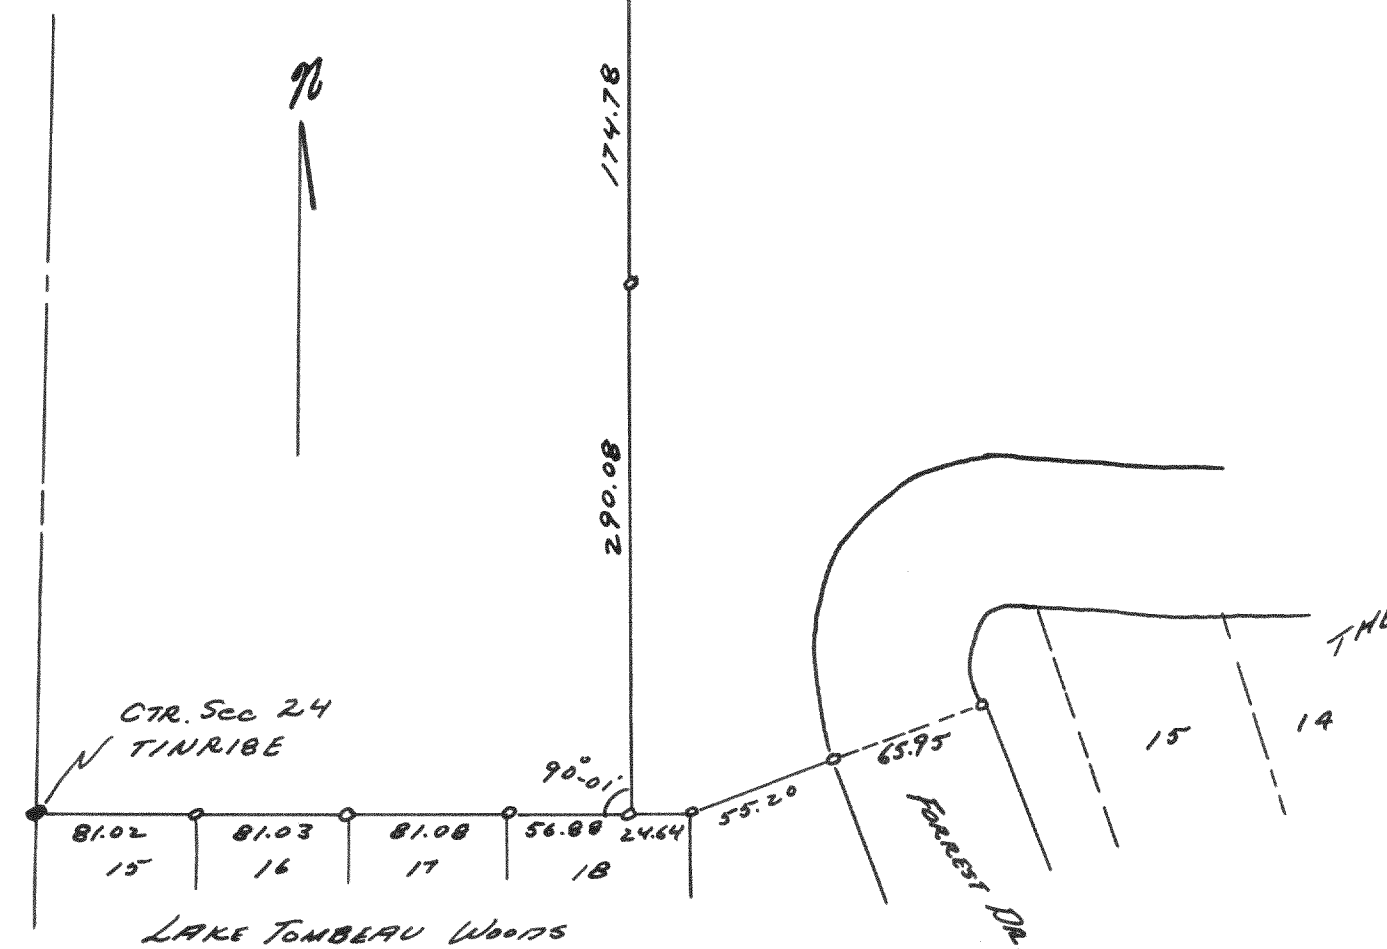

LAKE TOMBEAU Woods