



2803

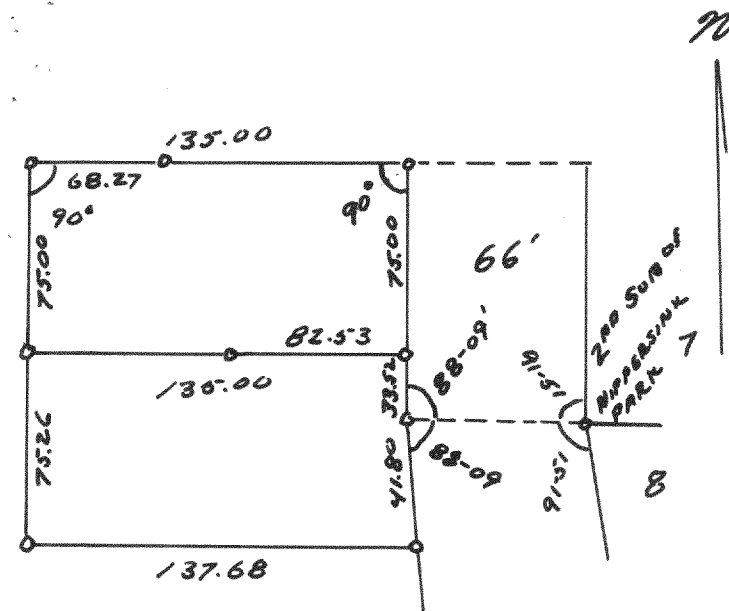


Plat of Survey of Land Located in NE 1/4 Sec. 24 T2N R18E Sept. 1953 LLV CS

2804

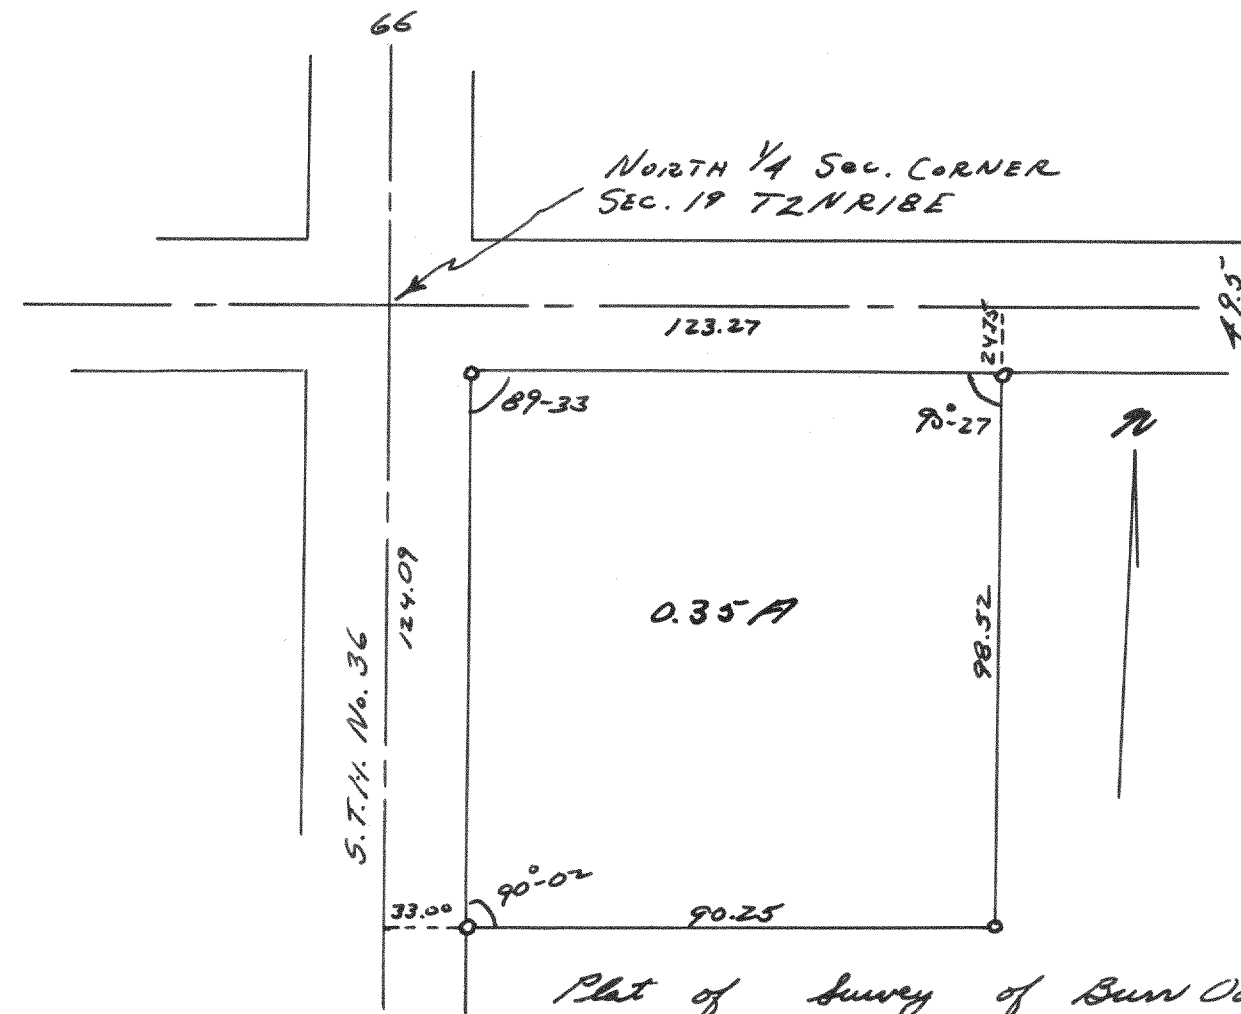


Plat of Survey of Burn Oak School in NW 1/4 NE 1/4 Sec. 19 T2N R18E Sept. 1953 LLV CS

2805

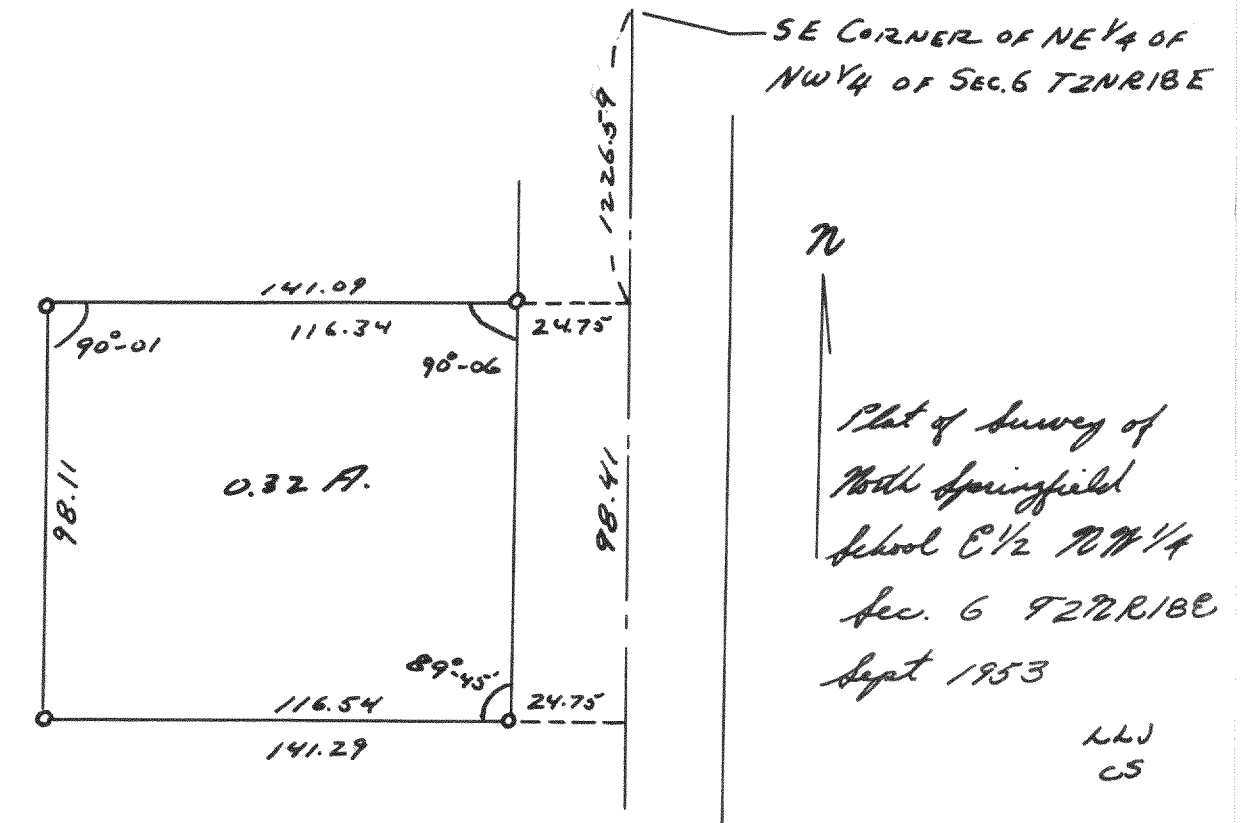


Plat of Survey of North Springfield School E 1/2 NW 1/4 Sec. 6 T2N R18E Sept 1953 LLV CS

2806

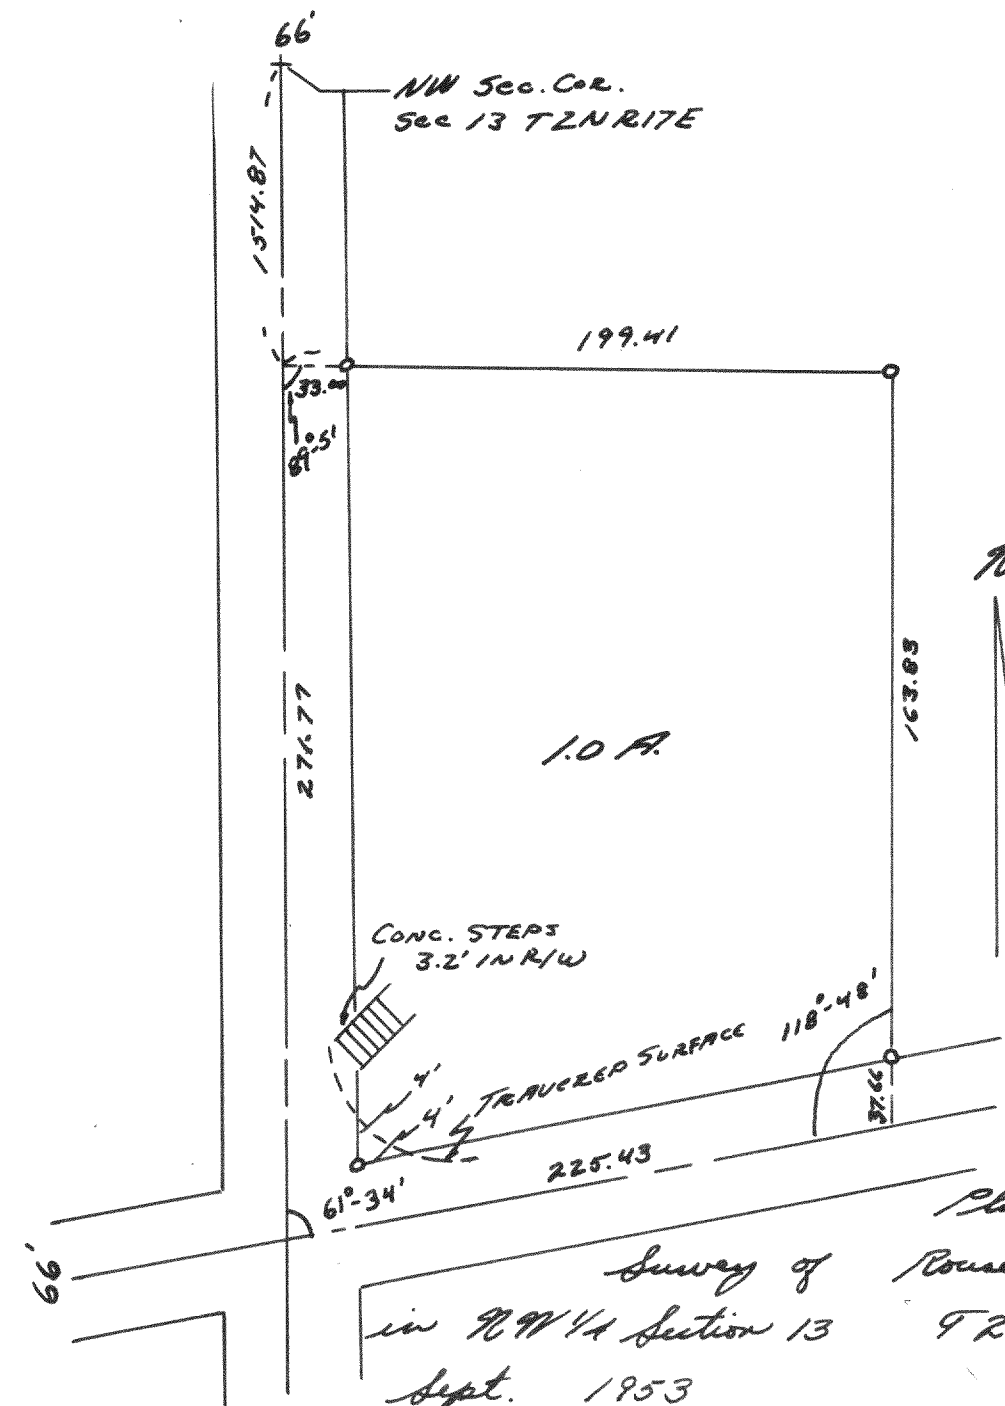


Plat of Survey of House School in NW 1/4 Section 13 T2N R17E Sept. 1953 LLV CS

2807

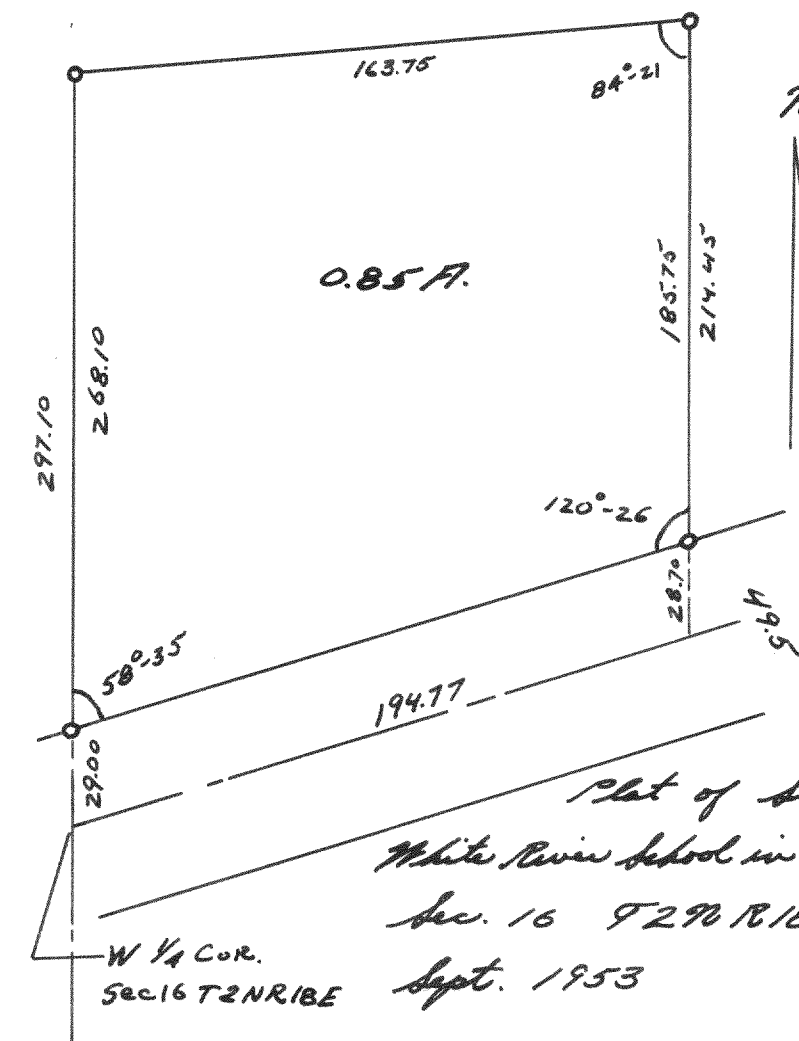

Plat of Survey of White River School in SW 1/4 NW 1/4 Sec. 16 T2N R18E Sept. 1953 LLV CS

2808

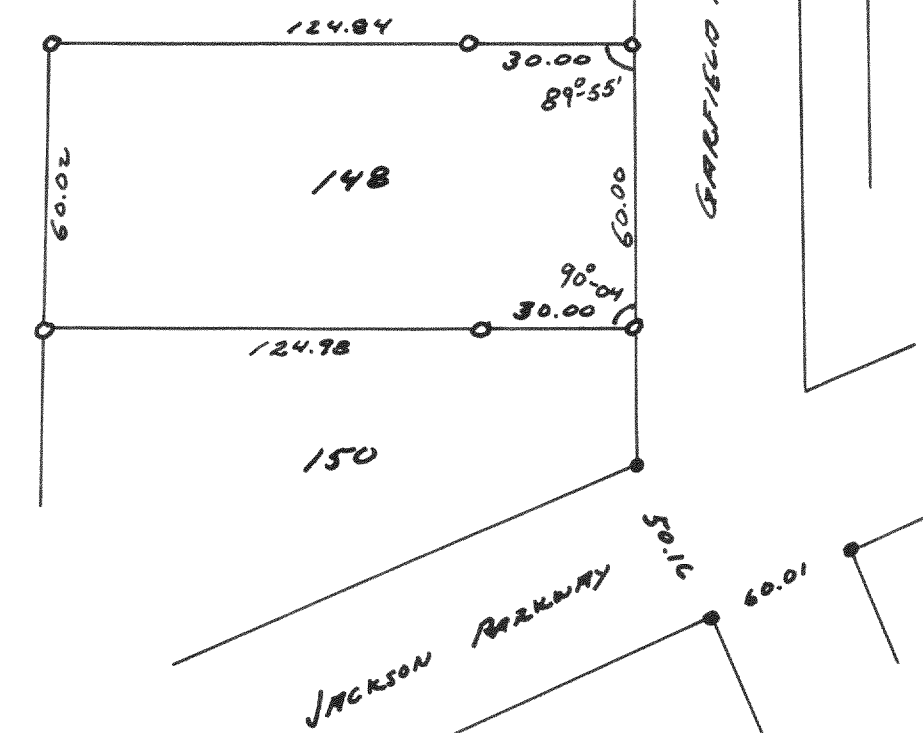

Plat of Survey of Lot 148 Cedar Point Park Original Village of Williams Bay. November 1954 LLV CS