


#4252 PLAT OF SURVEY OF
LOT 10, LOT 11 AND PART OF LOT 12,
BLOCK 5 - TRIPP'S ADDITION TO THE
CITY OF WHITEWATER

OCT 20, 1964

Lloyd L. Jensen
CO. SURVEYOR

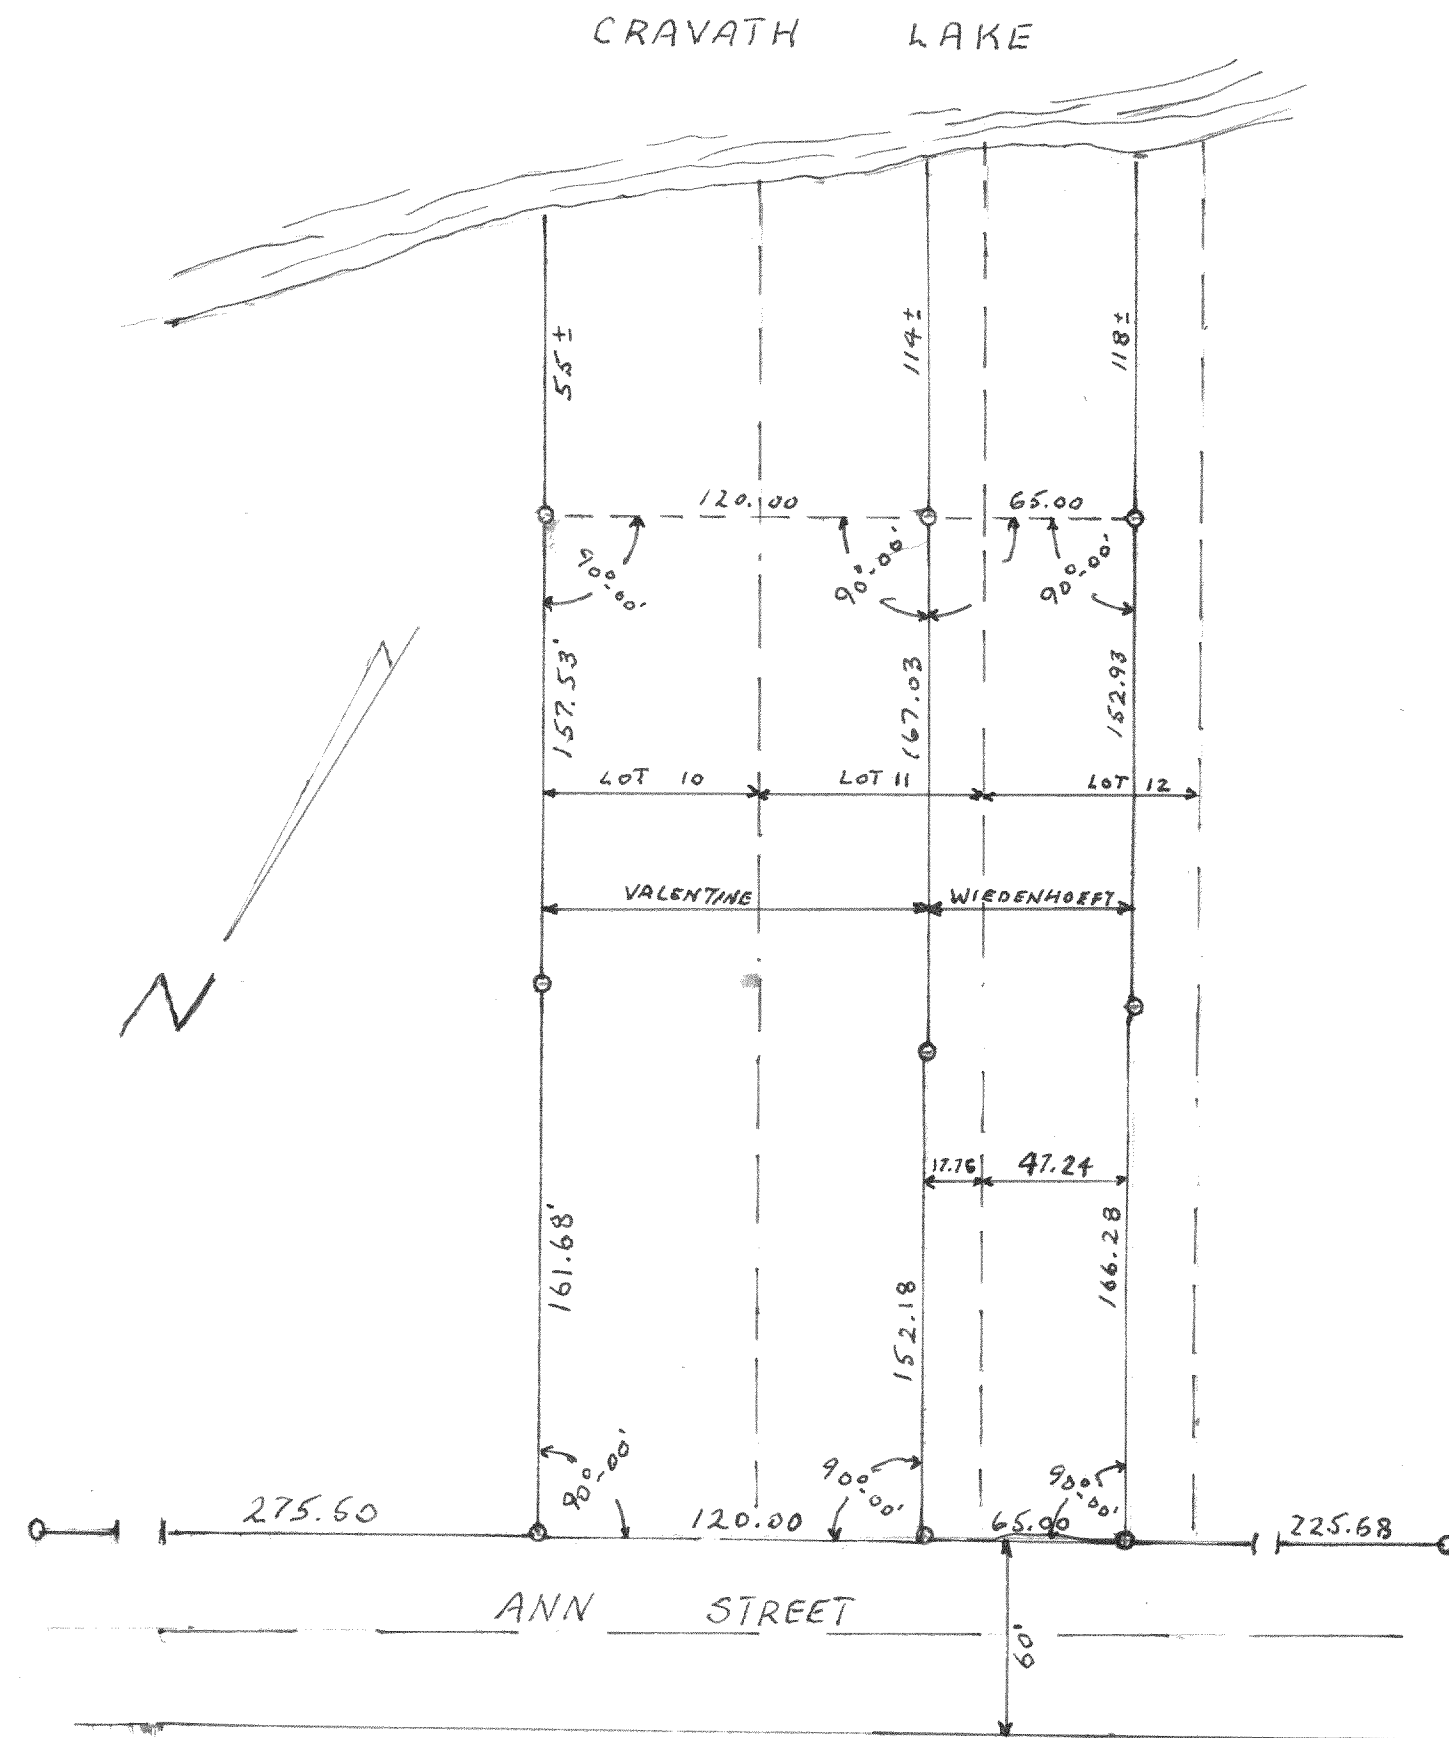

#4253 PLAT OF SURVEY OF
PART OF LOT 4 BLOCK 2 ORIGINAL PLAT-
CITY OF WHITEWATER, WALWORTH COUNTY, WIS.

OCT. 22, 1964

Lloyd L. Jensen
CO. SURVEYOR

