


#4297

Plat of Survey of
LOTS 12190 TO 12194 inclusive
Block 217 Lake Como Beach
Subdivision T2N-R17E Walworth
County, Wisconsin

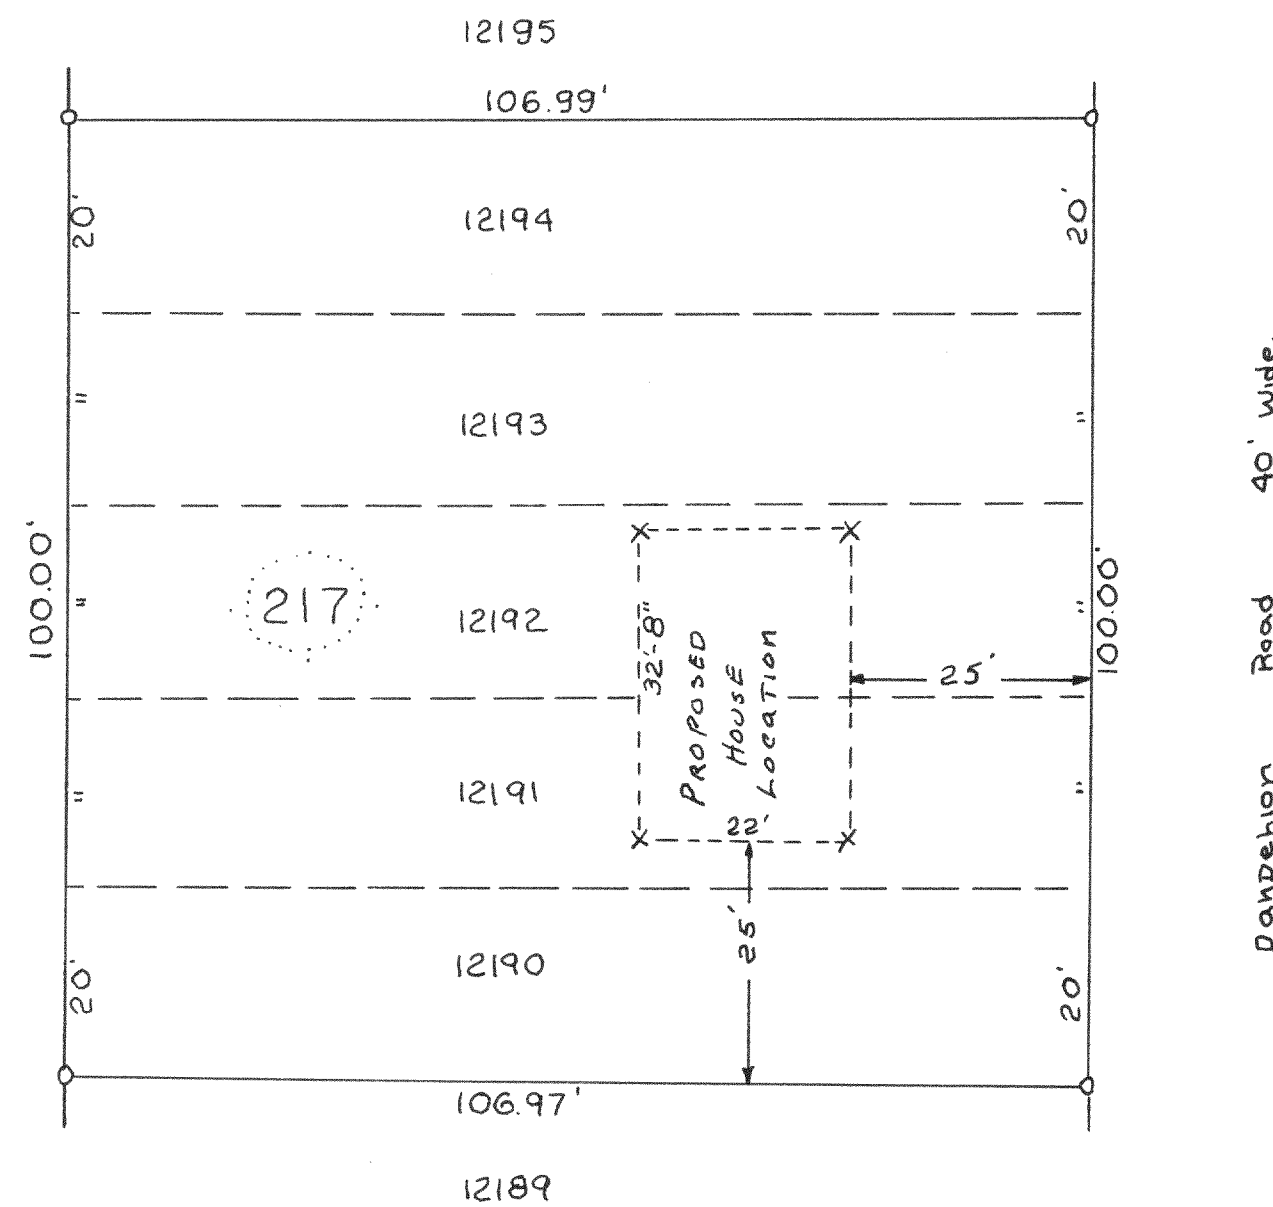


OCT. 1962

Lloyd L. Jensen
Wal. Co. Surveyor

#4298

Plat of Survey of
Lot 11 - Block 1, Miramar Subdivision
located in Section 10 & 11, T4N, R18E
Walworth County, Wisconsin

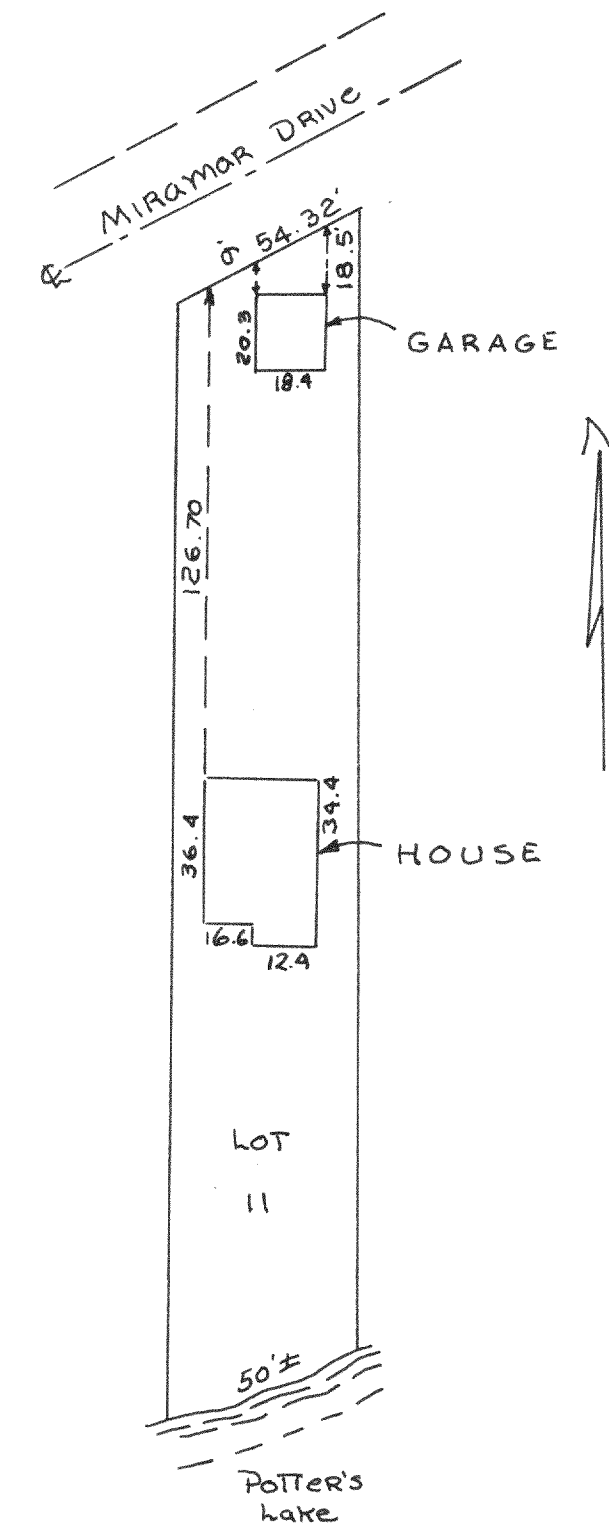

NOV. 1962

Lloyd L. Jensen
Wal. Co. Surveyor