


# 4305

PLAT OF SURVEY OF  
LOTS 21, 22, 23, EDGEWATER  
TERRACE SUBD. LOCATED  
IN SEC. 8 & 9 T1N R1E  
WALWORTH COUNTY, WIS

APRIL 1964

*Lloyd L. Jensen*  
CO. SURVEYOR

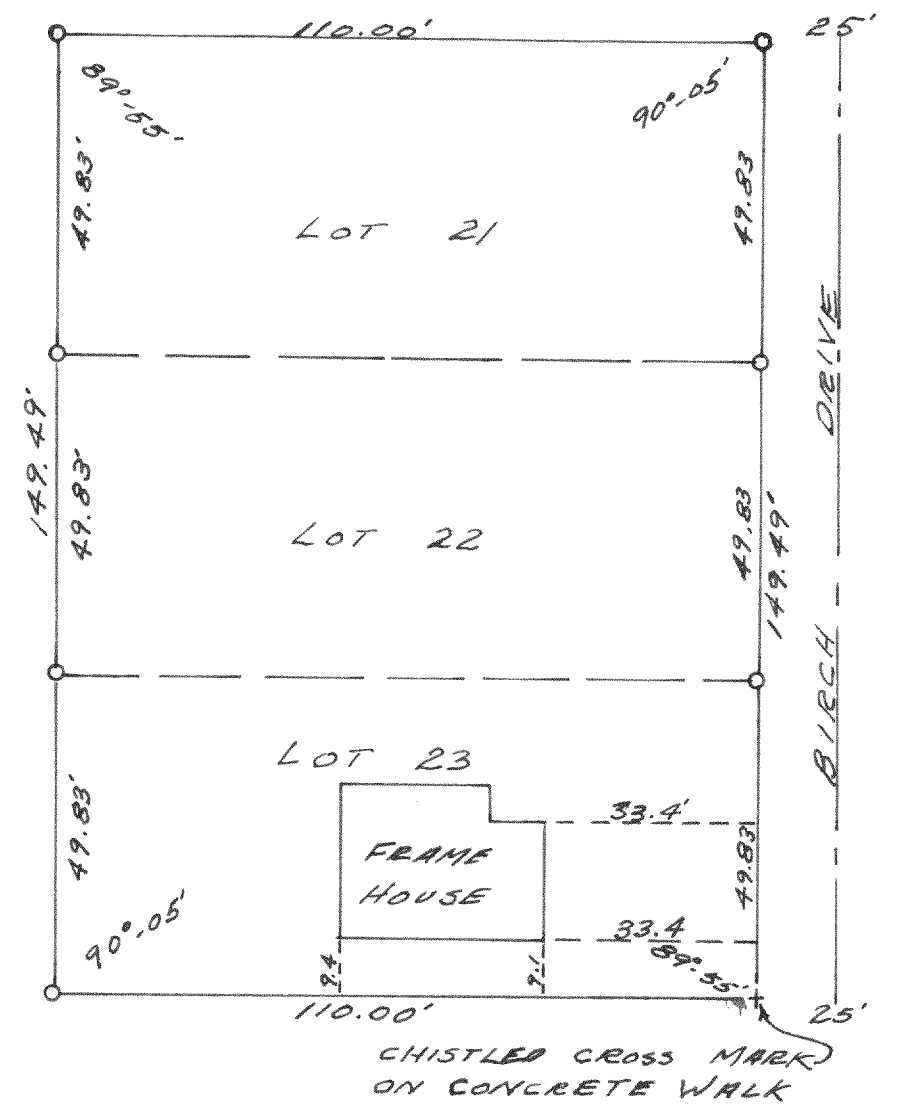

# 4306

PLAT OF SURVEY OF

LOTS 85, 88, + 89 LAKE GENEVA  
BEACH SUBD. LOCATED IN SW 1/4 OF  
SEC 11, T1N, R1E, WALWORTH COUNTY, WIS

AUG 1964

*Lloyd L. Jensen*  
CO. SURVEYOR

