



2629

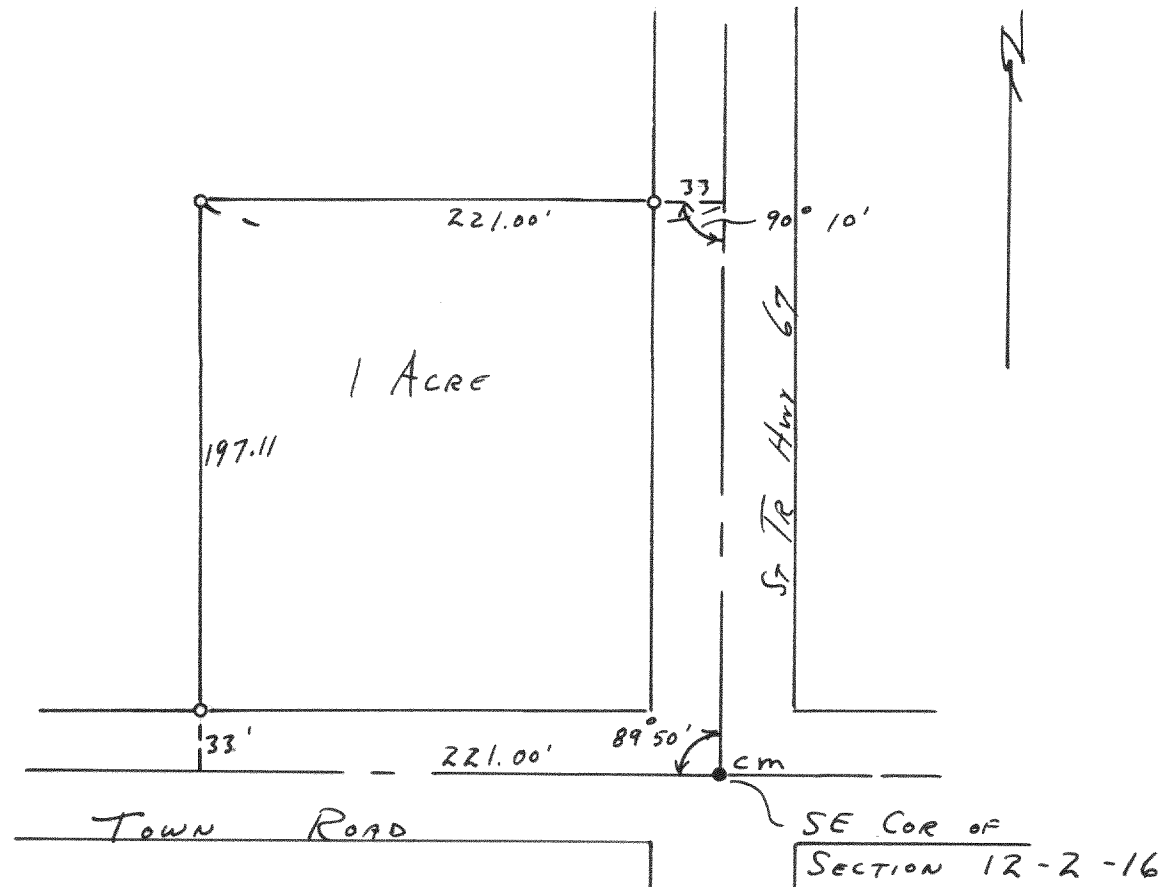


PLAT OF SURVEY OF 1 ACRE OF LAND
LOCATED IN THE SOUTHEAST CORNER
OF SECTION 12, T2N R16 E
June 28, 1952 Lloyd L Jensen
County Surveyor CR.

2631

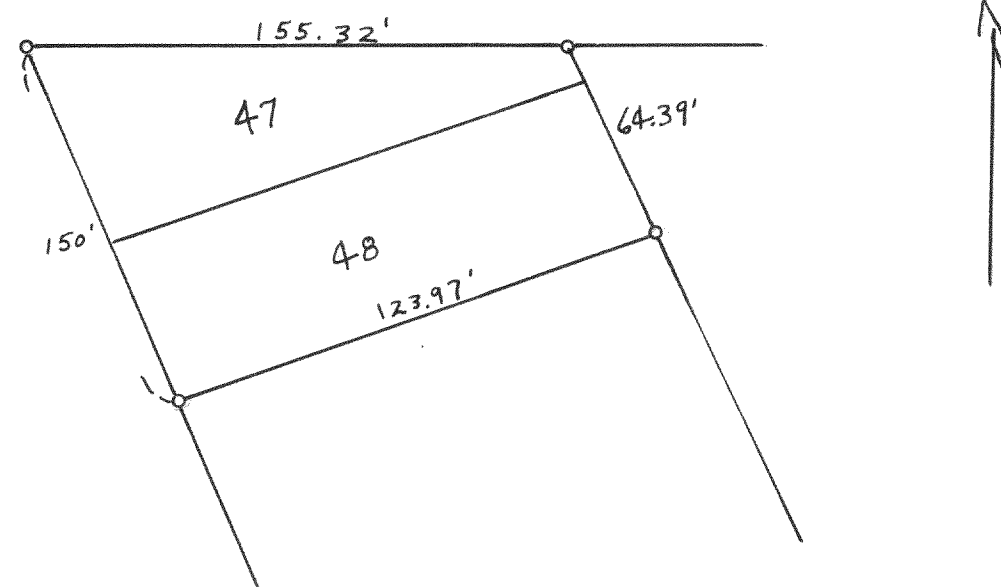


PLAT OF SURVEY OF LOTS 47 AND 48 OF
BLOCK 3 OF INLET OAKS SUBD. No. 3
June 28, 1952 Lloyd L Jensen
County Surveyor CR.

2630

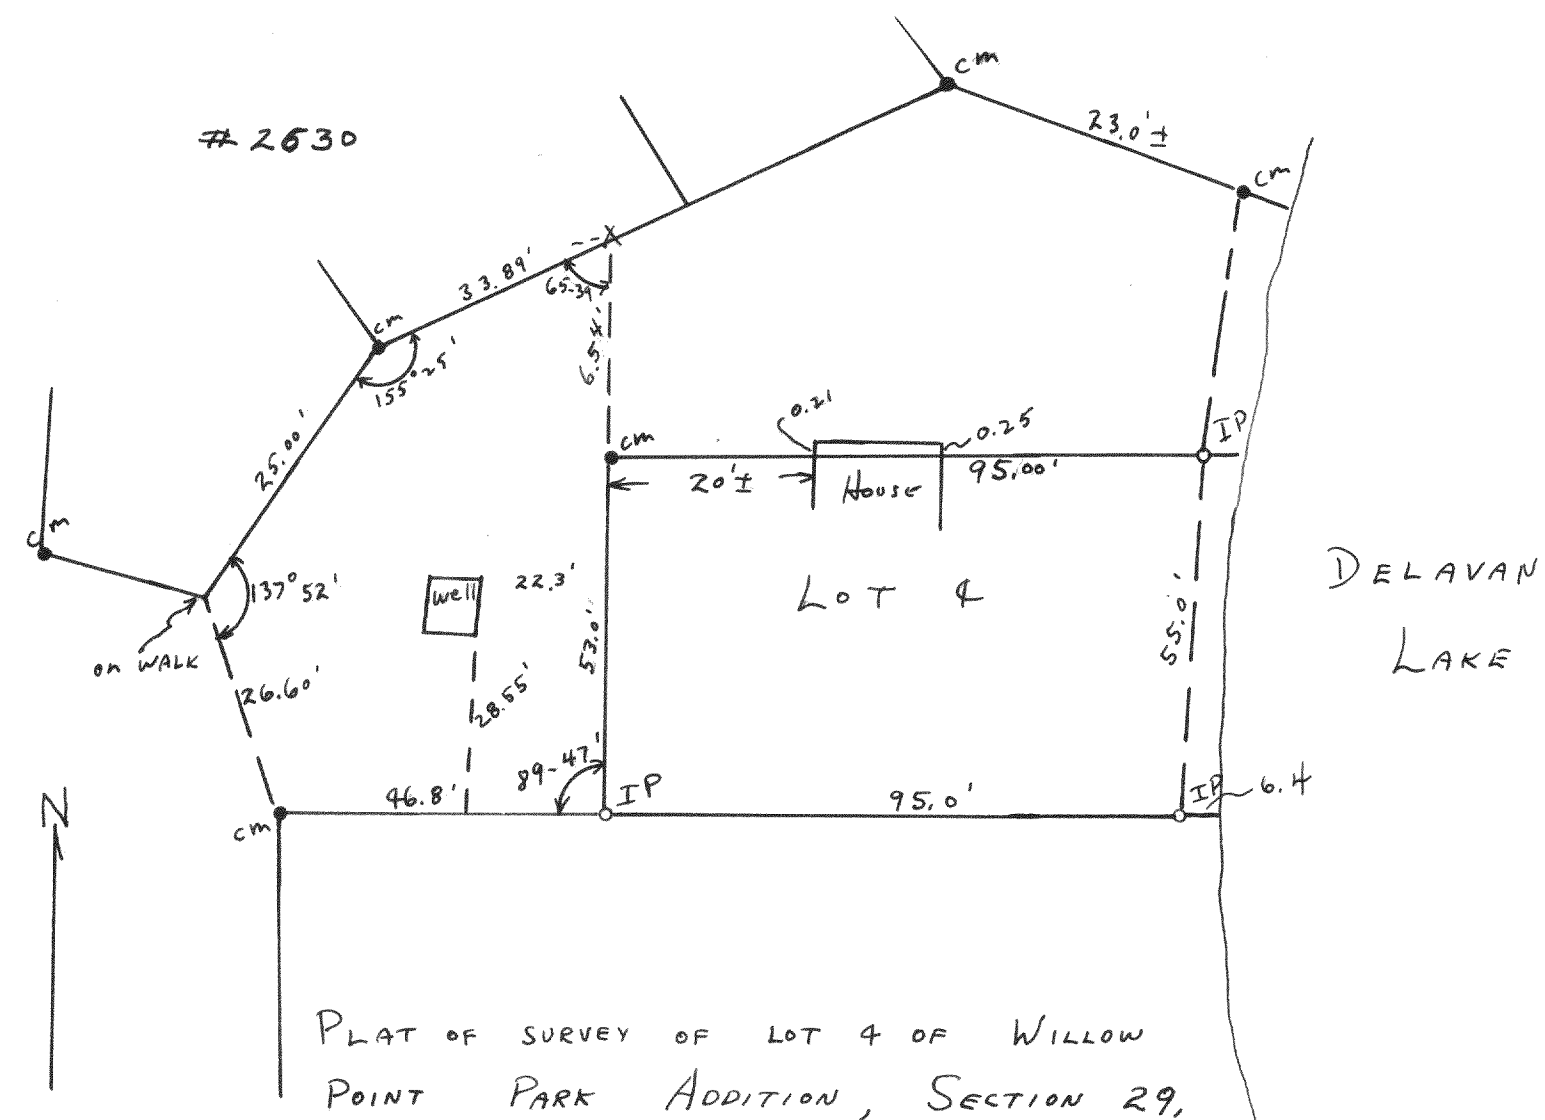

PLAT OF SURVEY OF LOT 4 OF WILLOW
POINT PARK ADDITION, SECTION 29,
T2N R16 E.
Aug 7, 1952 Lloyd L Jensen
County Surveyor CR.

2632

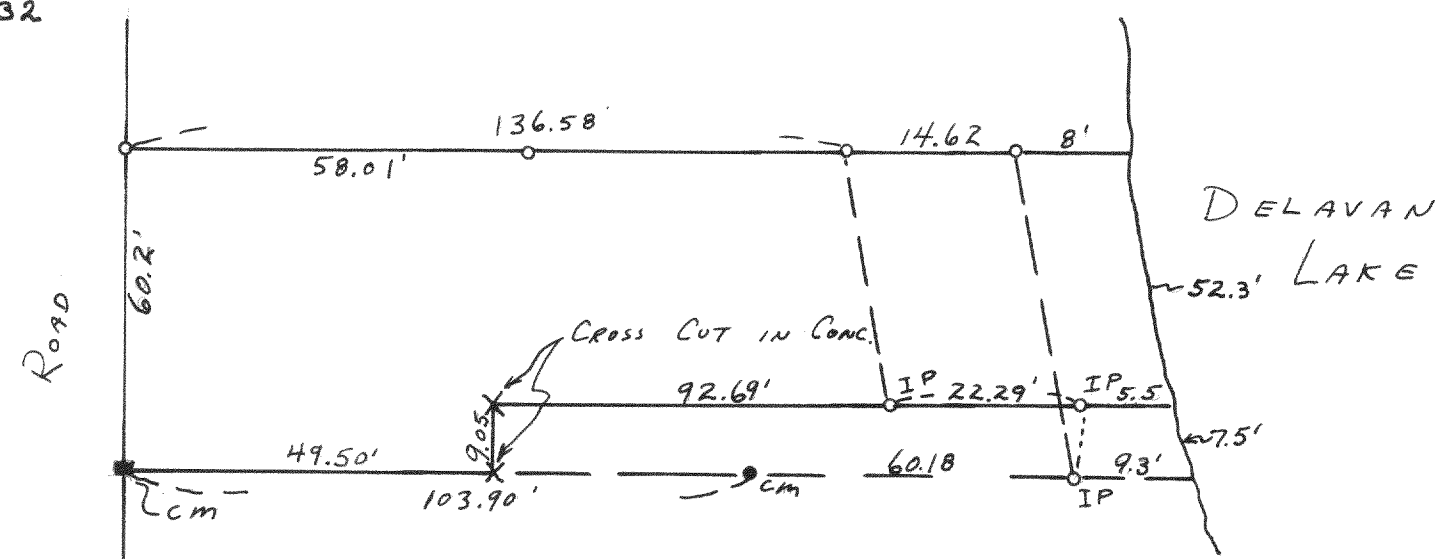

PLAT OF SURVEY OF PART OF LOT 6 OF
WILLOW POINT PARK ADDITION, SECTION
29, T2N R16 E.
May 31, 1952 Lloyd L Jensen
County Surveyor CR.