



#4319

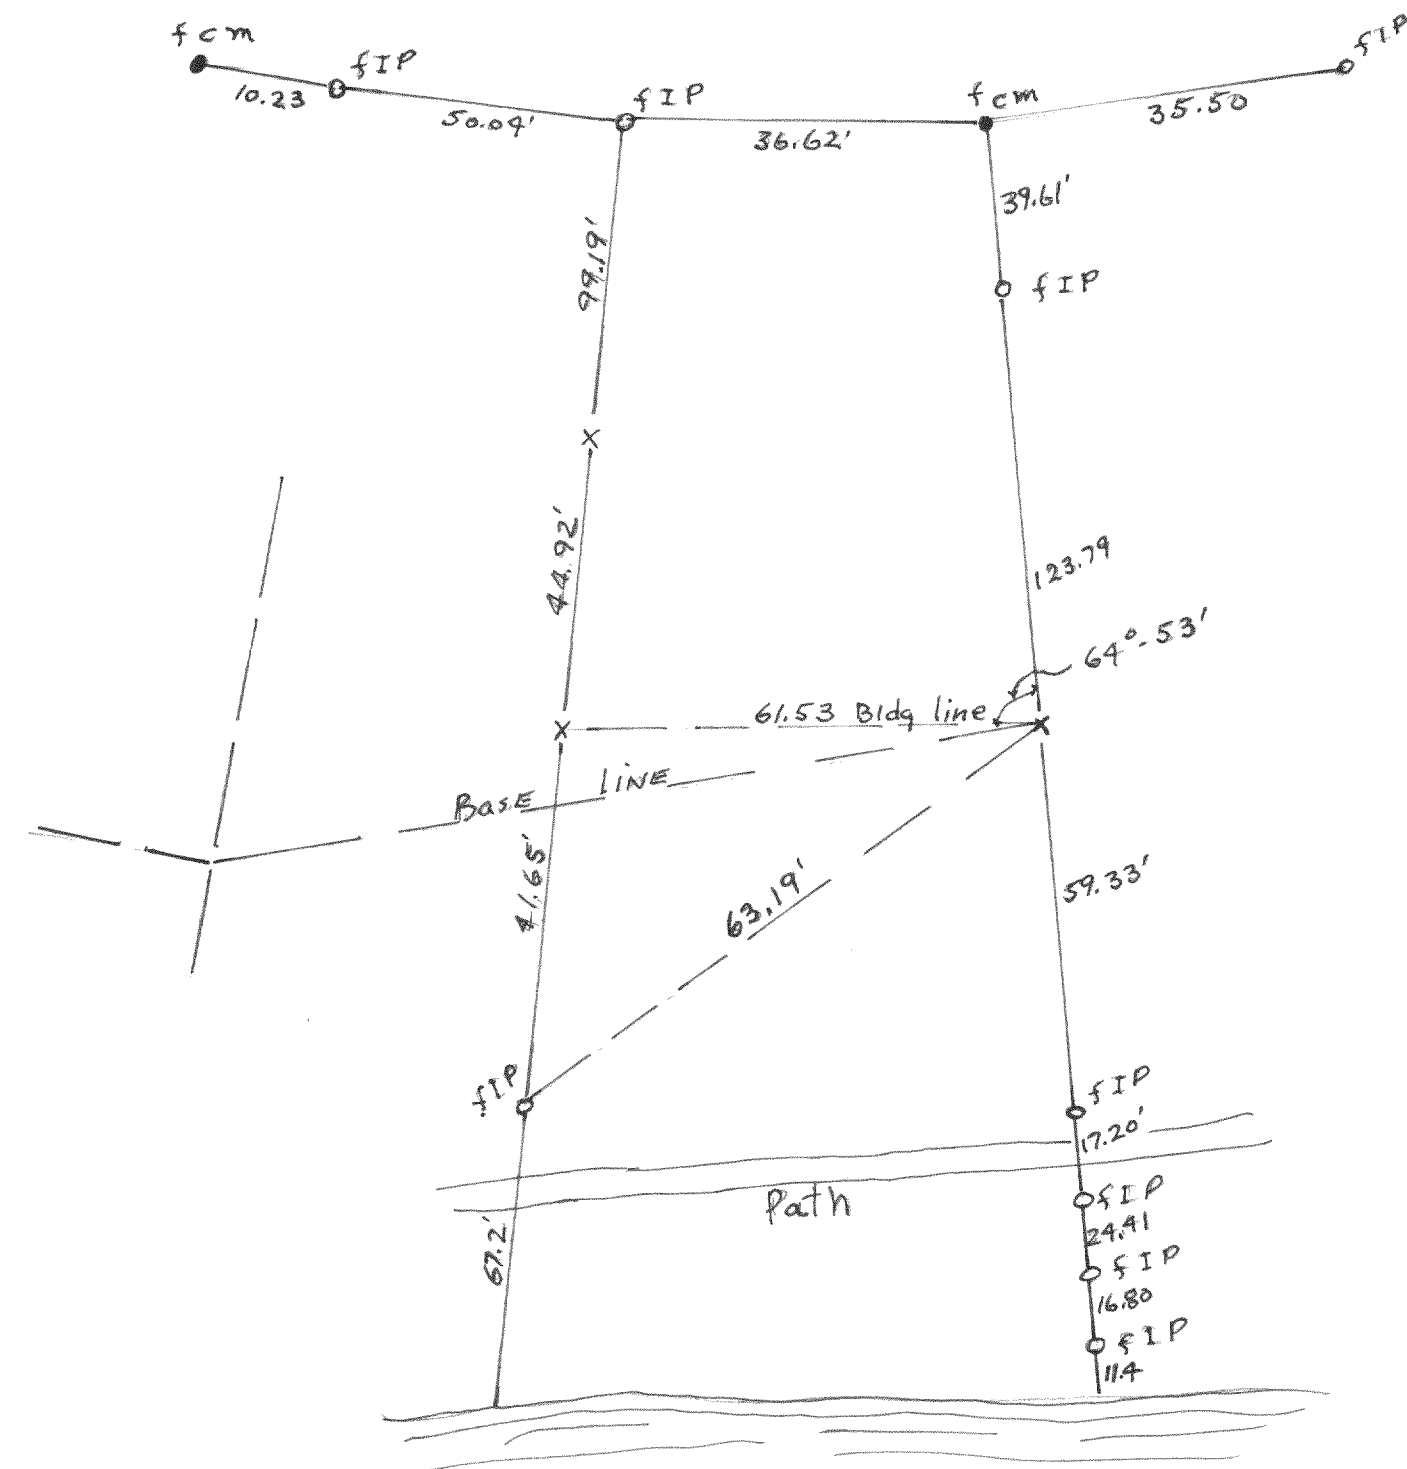

GENEVA Lake

Plat of SURVEY of Lot 217 of
3rd Add to Cedar Pt. PARK
W^m Bay, Wis.
Nov. 9, 1955
Lloyd Jensen
County SURVEYOR

#4320

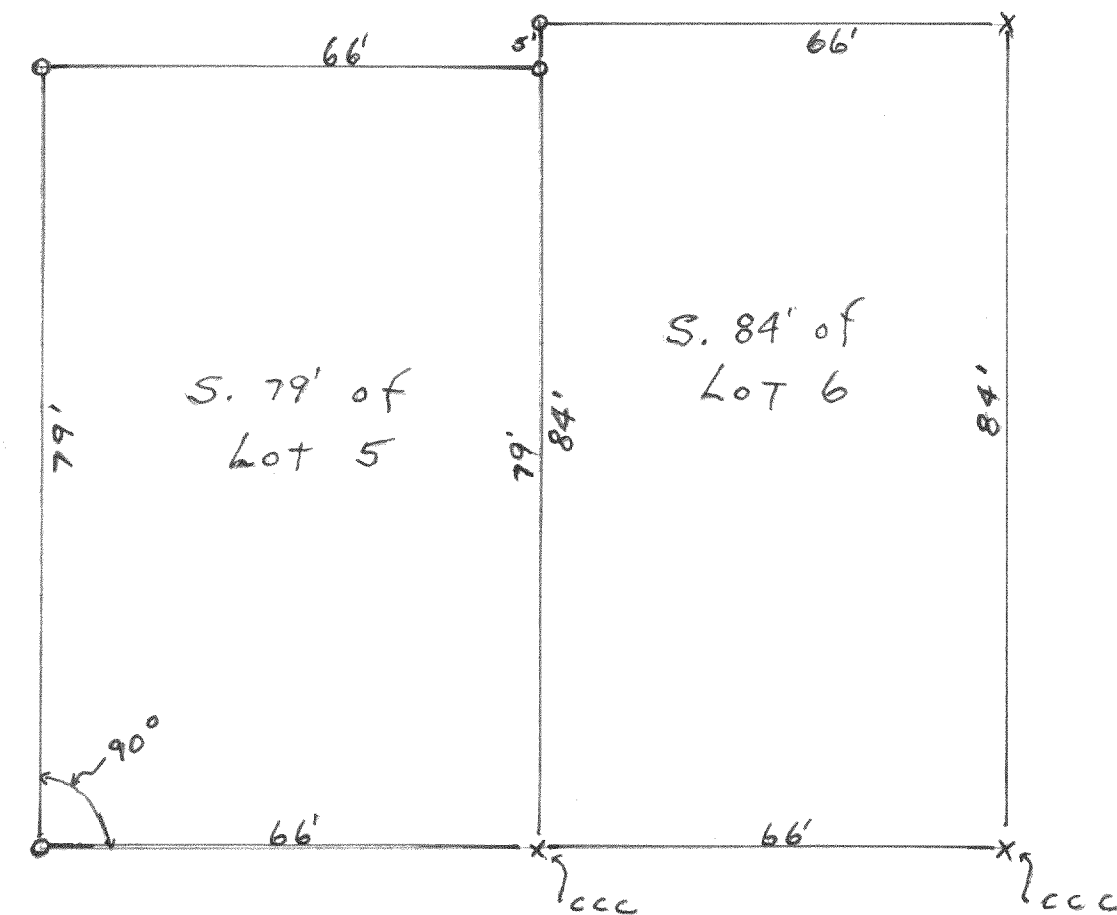

Plat of SURVEY of part of Lots
5 + 6 of Block 9 of the Village
of Sharon
DEC. 11, 1963
Lloyd Jensen
County SURVEYOR