


#4323

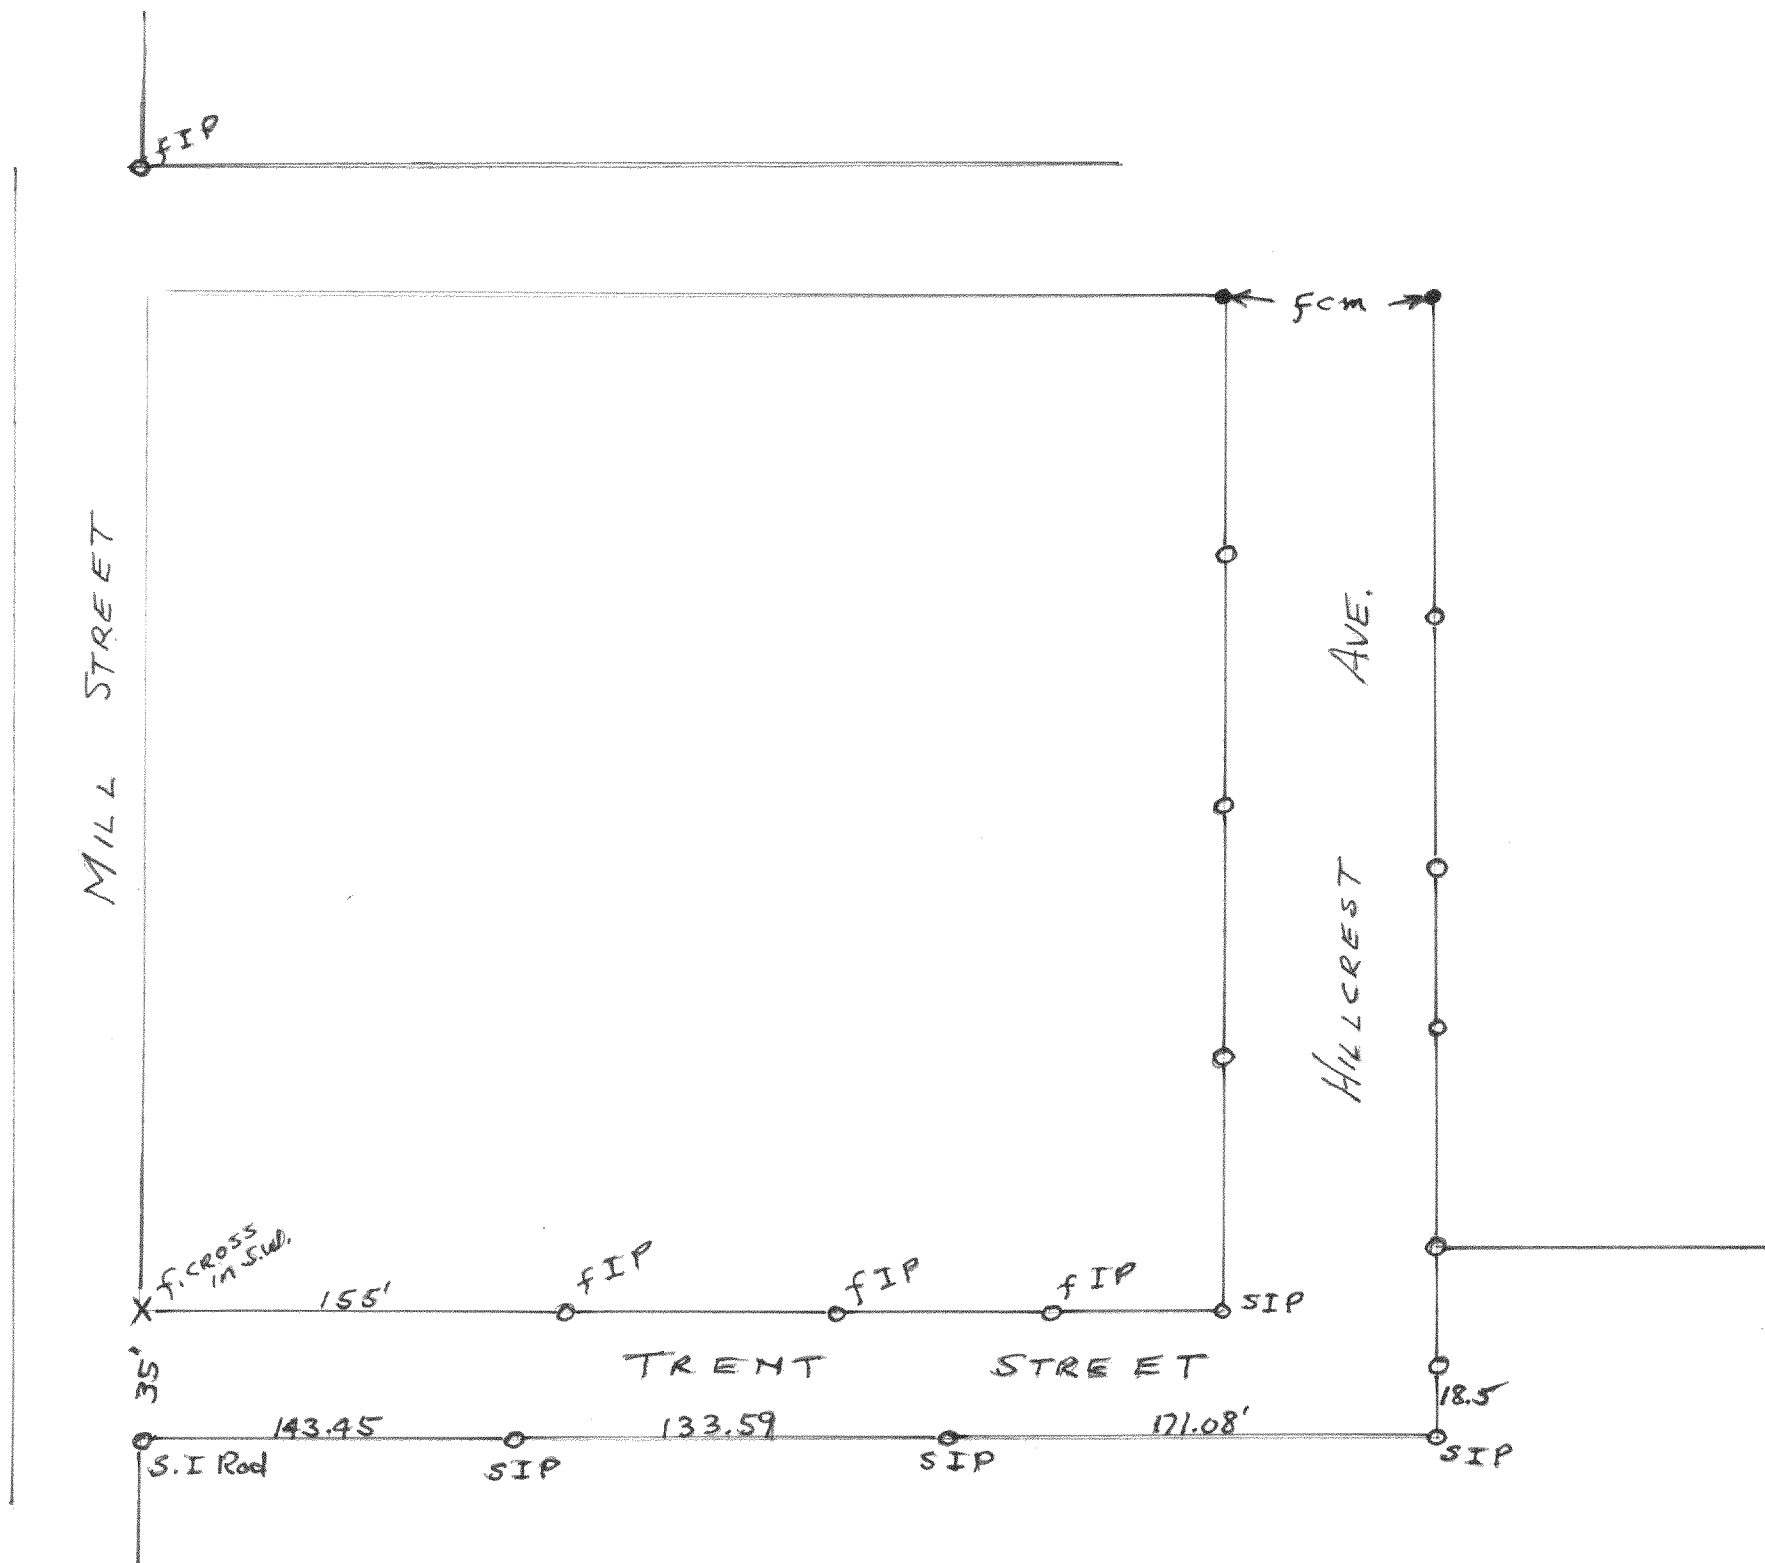


Plat of SURVEY of TRENT STREET
in the Village of East Troy

Sept. 11, 1950

Lloyd L. Jensen
County Surveyor

4324

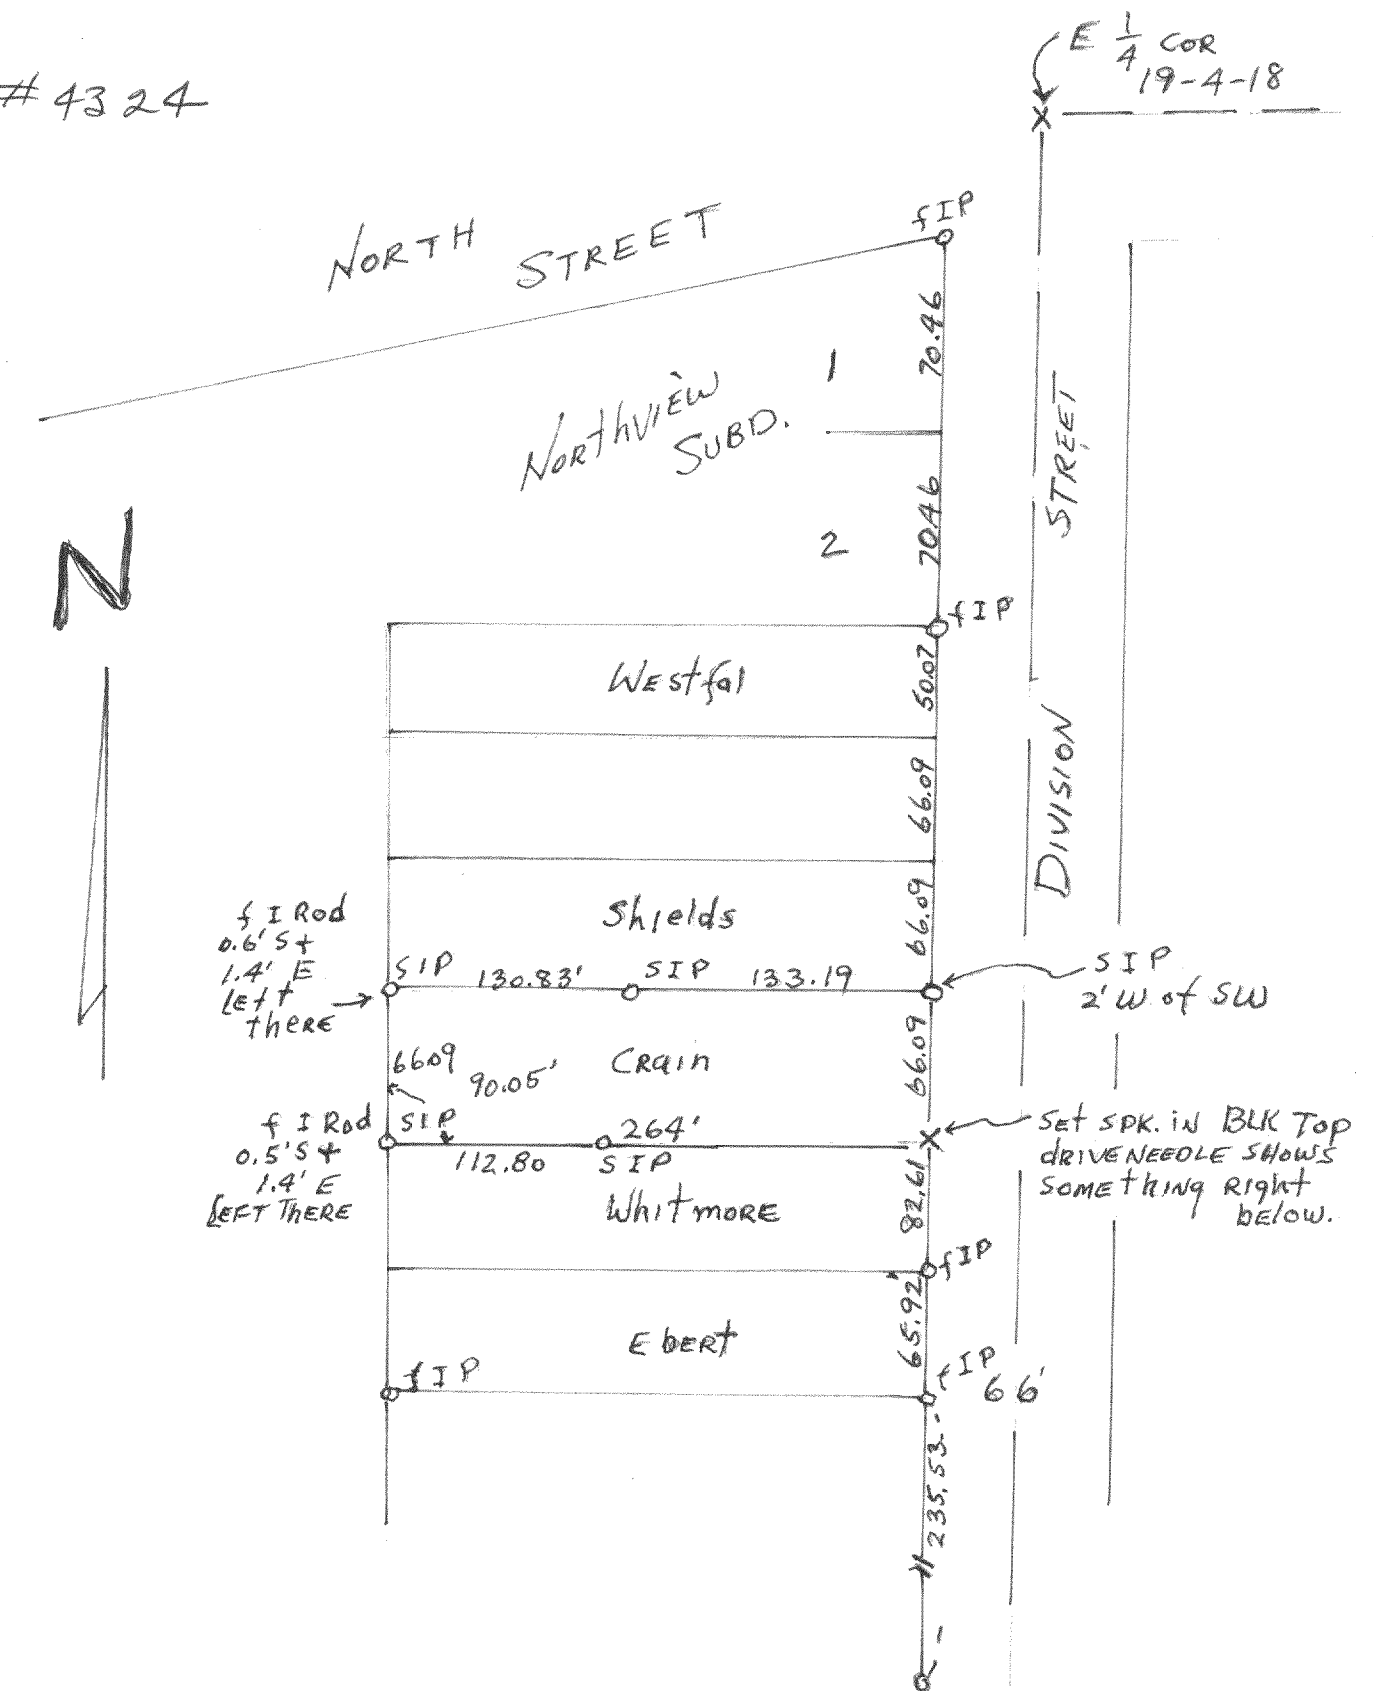

Plat of SURVEY of a lot on DIVISION
St. in SEC. 19-4-18.

Nov. 2, 1956

ST. IN SEC., 19-4310.
Nov. 2, 1956 Lloyd Jensen
County Surveyor