



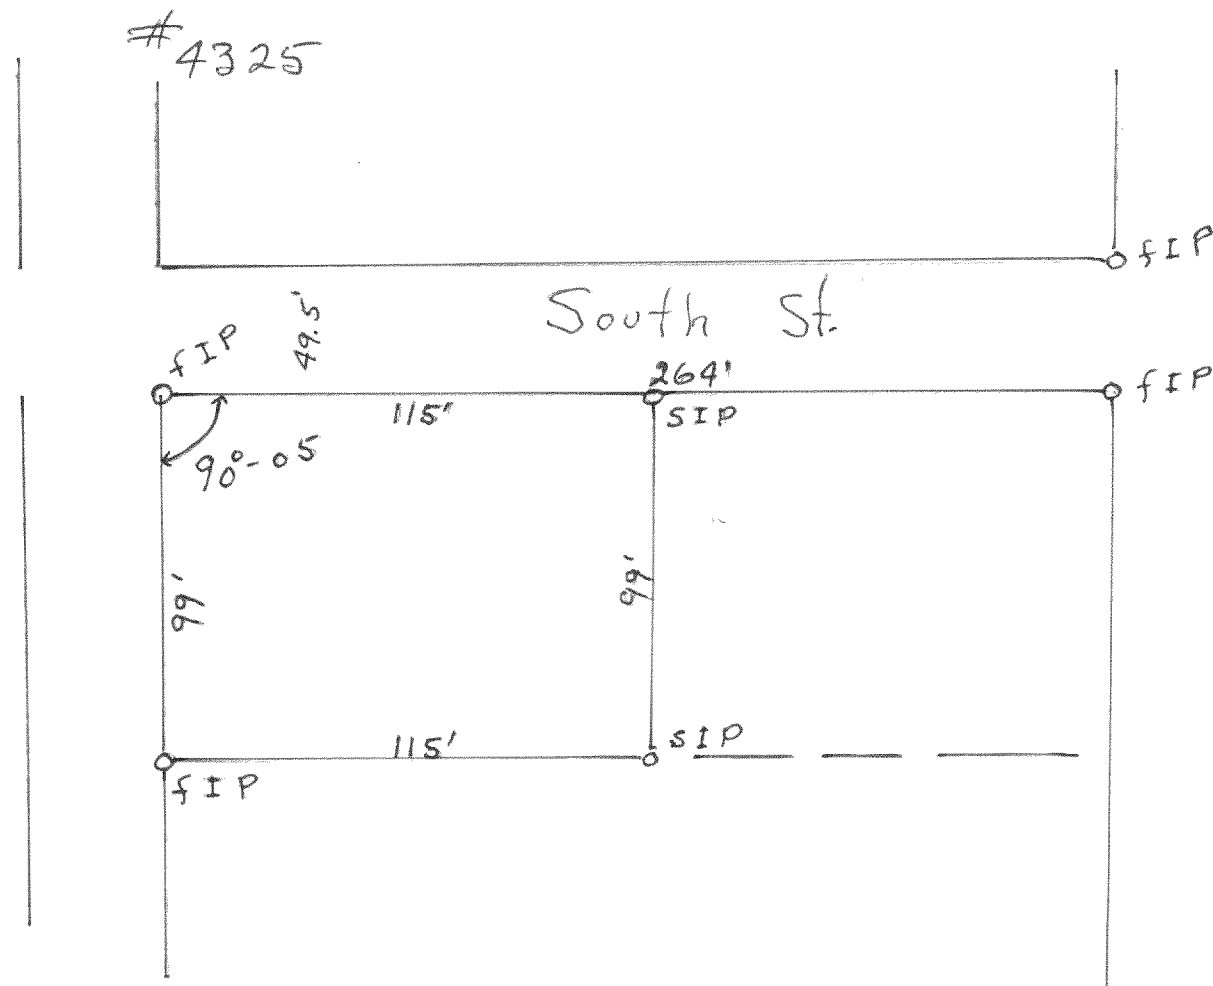

Plat of SURVEY of part of Lot 1
BIK 18 of original plat of
East TROY

Floyd L Jensen
County SURVEYOR

July 2, 1957

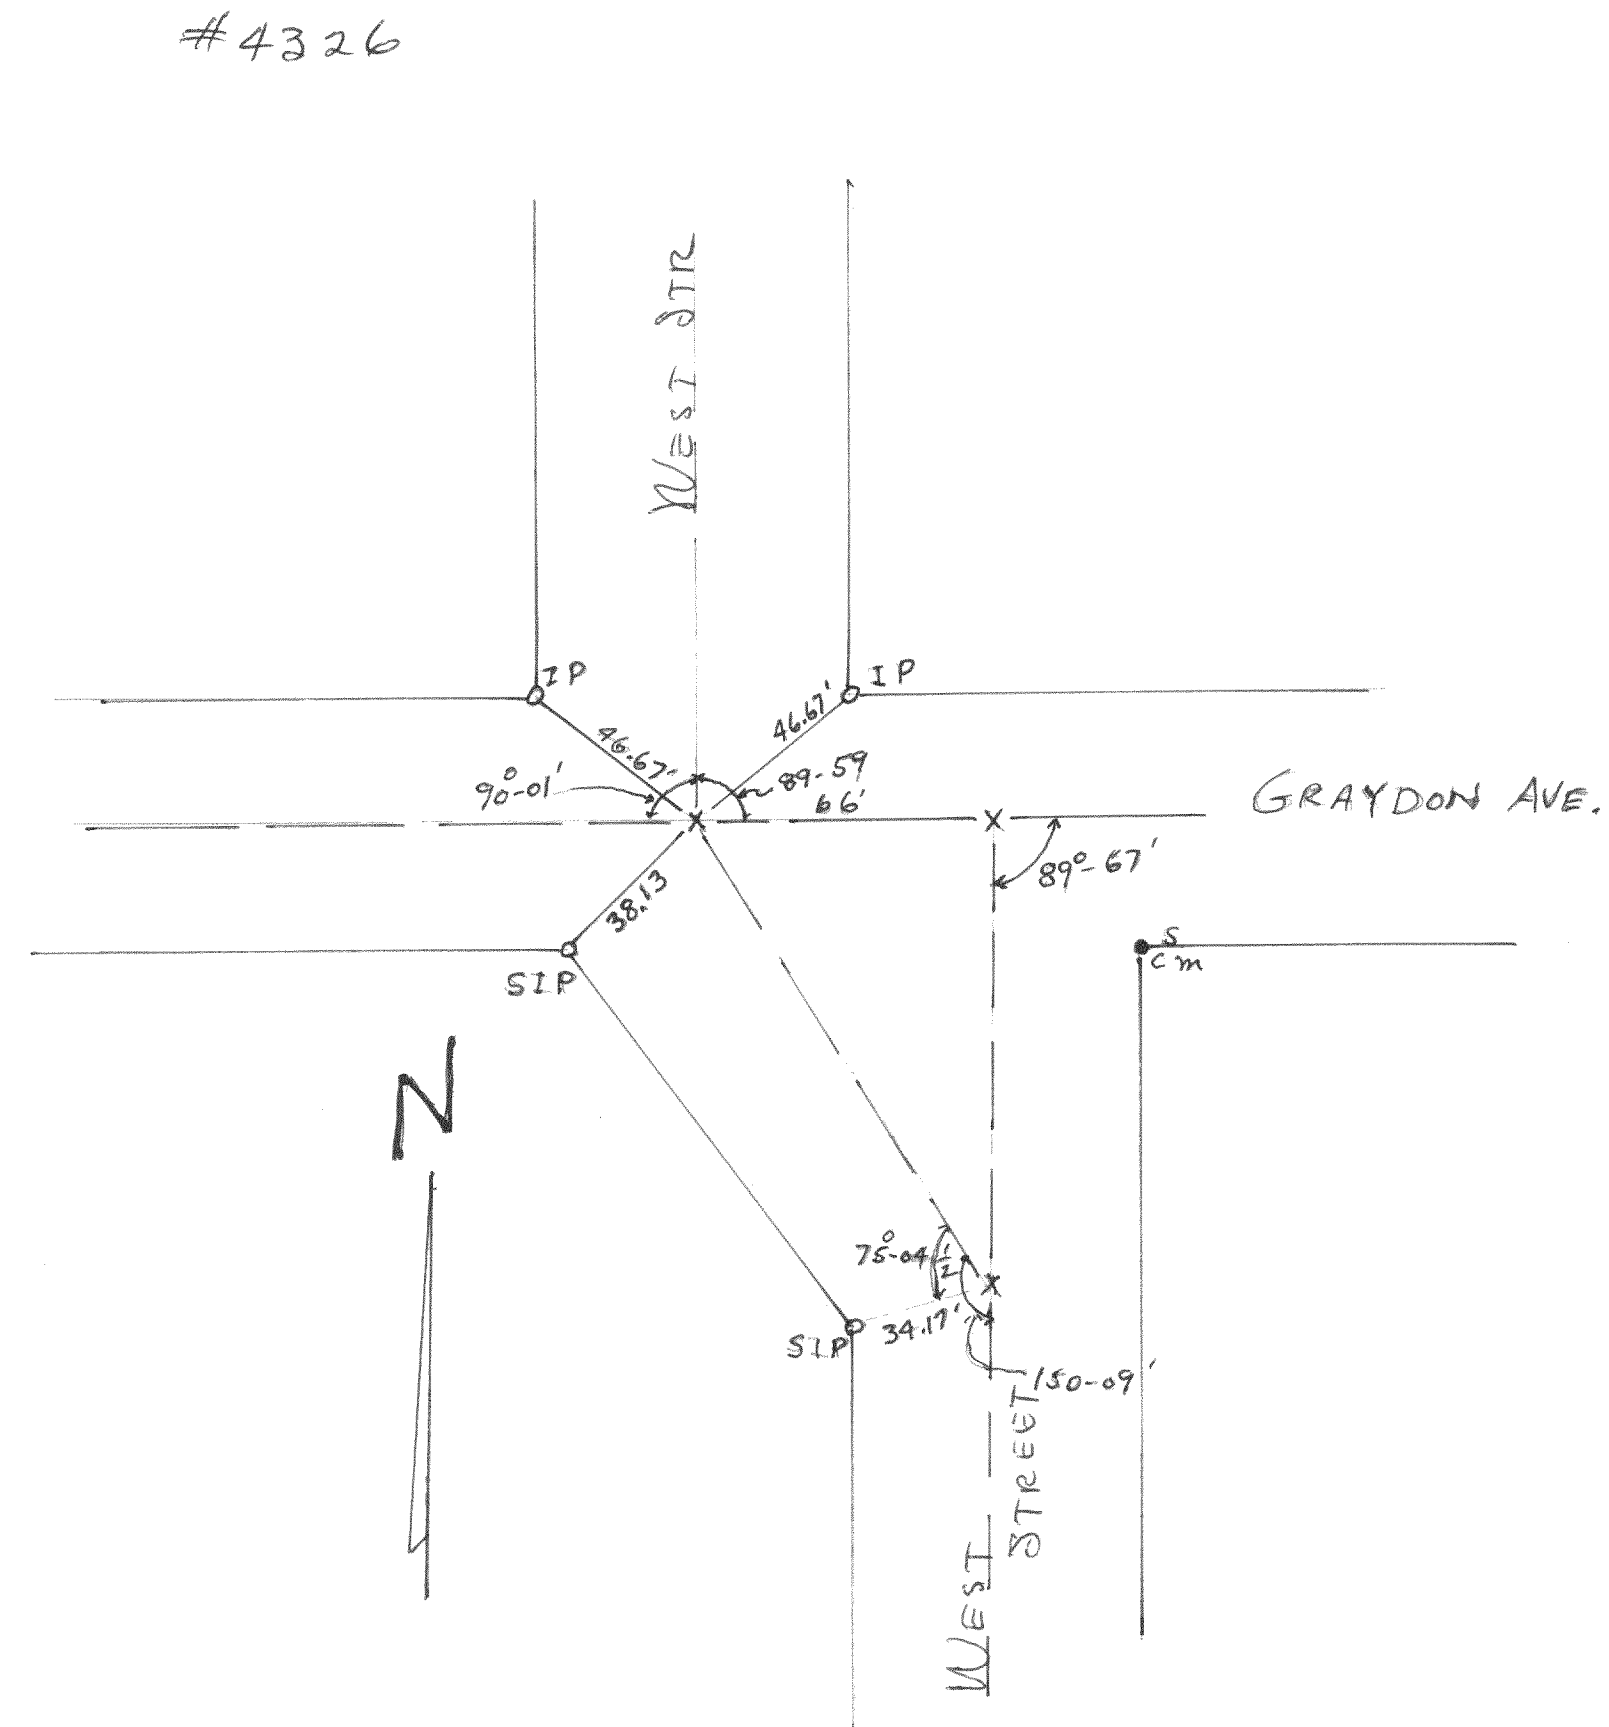

Plat of survey of the intersection
of Graydon Ave. and West St.
in the Village of East Troy, Wis

July 1962

Lloyd Jensen
County Surveyor